

PLAT OF SURVEY

FOR: DAN CARMODY

DATE: 10/03/03

DESCRIPTION: BEING LOT 66 OF ELKHORN WEST ADDITION # 1, A SUBDIVISION LOCATED IN PART OF THE NE 1/4 AND SE 1/4 OF THE SE 1/4 OF SECTION 35, TOWN 3 NORTH, RANGE 16 EAST AND PART OF THE NE 1/4 OF THE NE 1/4 OF SECTION 2, TOWN 2 NORTH, RANGE 16 EAST, CITY OF ELKHORN, WALWORTH COUNTY, WISCONSIN.

NOV 1 6



KW

WEST
SEDGEMEADOW ST.

LEGEND

Symbol	Description
●	FOUND 1" IRON PIPE
⊗	FOUND 2" IRON PIPE
—C—	CENTER LINE ROAD

SCALE 1"=30'

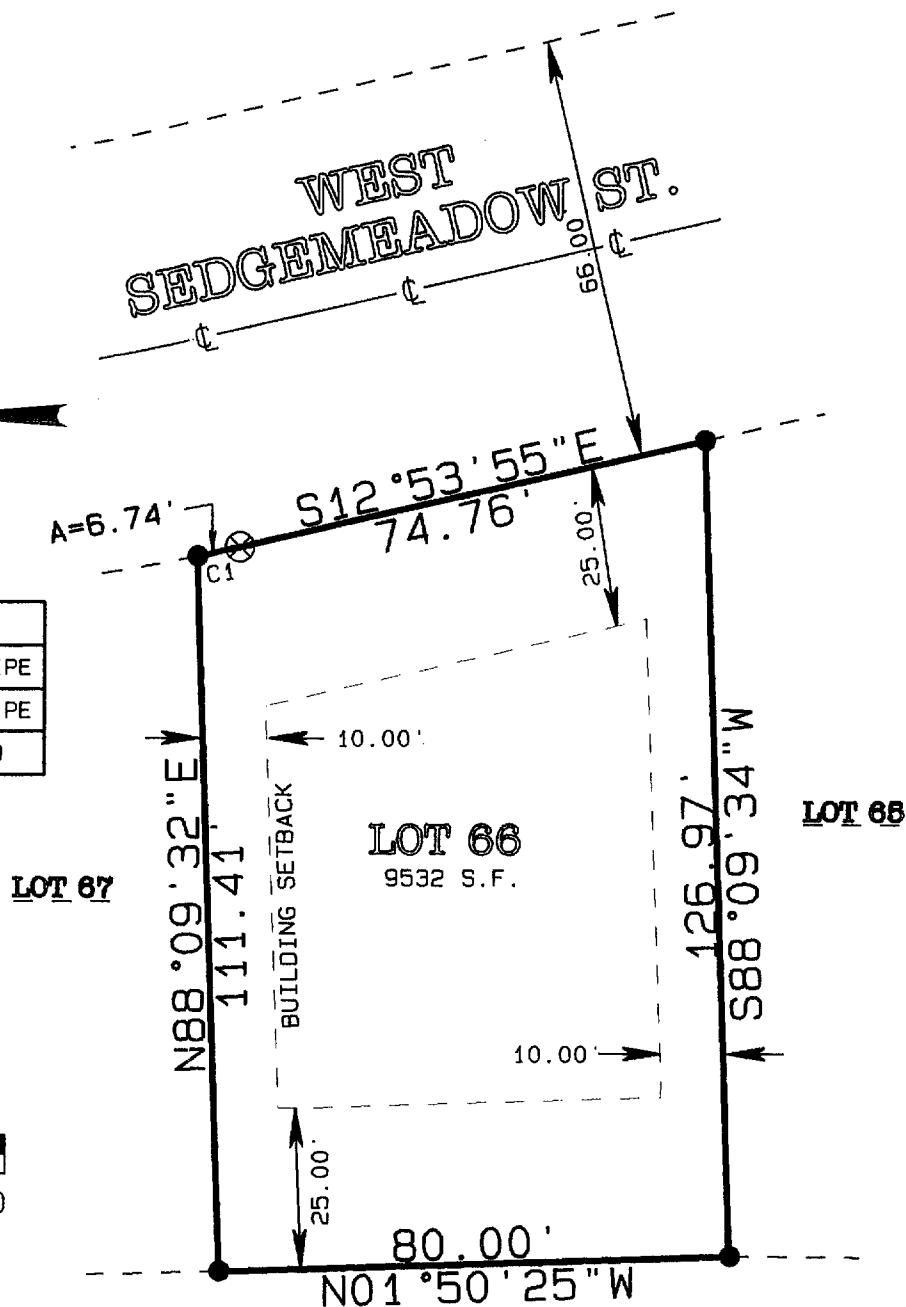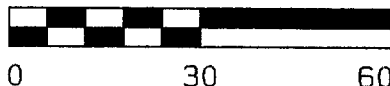


CURVE TABLE

CURVE #	DELTA	RADIUS	ARC	CHORD BEARING	CHORD
C1	1°15'44"	306.00'	6.74'	S16°16'24"W	6.74'

I PAUL H. VAN HENKELUM R.L.S. # 1931 HEREBY CERTIFY THAT THIS SURVEY WAS MADE IN ACCORDANCE WITH THE MINIMUM STANDARDS FOR PROPERTY SURVEYS (CHAPTER A-E7) STATE OF WISCONSIN AND HAS BEEN PREPARED UNDER MY DIRECTION AND CONTROL AND IS CORRECT TO THE BEST OF MY KNOWLEDGE AND BELIEF.

PAUL H. VAN HENKELUM R.L.S. #1931
RSVDATA6/BRADTDS03/J03337

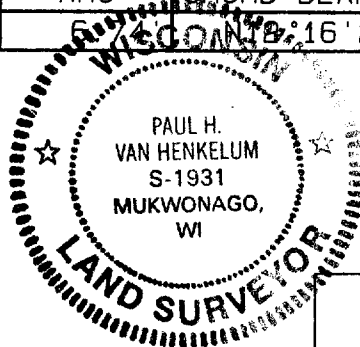

004-1676
ERSV
ENGINEERING, INC.

Engineers-Land Surveyors-Environmental Scientists
501 MAIN STREET MUKWONAGO, WISCONSIN 53146 (262) 383-2004

YEW1-66