

PLAT OF SURVEY

RSV
ENGINEERING, INC.

Engineers • Land Surveyors • Environmental Scientists
801 MAIN STREET MUKWONAGO, WISCONSIN 53149 (262) 363-2004

FOR: DAN CARMODY

DATE: 9/05/2003

DESCRIPTION:

LOT 97 OF ELKHORN WEST ADDITION NO. 1 BEING PART OF THE NORTHEAST $\frac{1}{4}$ AND THE SOUTHEAST $\frac{1}{4}$ OF THE SOUTHEAST $\frac{1}{4}$ OF SECTION 35, T3N, R16E AND PART OF THE NORTHEAST $\frac{1}{4}$ OF THE NORTHEAST $\frac{1}{4}$ OF SECTION 2, T2N, R16E, CITY OF ELKHORN, WALWORTH COUNTY, WISCONSIN

LEGEND


- FOUND 1" IRON PIPE
- UTILITY PEDISTAL

CURVE TABLE DATA

NO.	DELTA	RADIUS	ARC	CHD. BRG.	CHD. L.
C1	15°45'23"	294.00'	80.85'	S78°29'55.5"W	80.60'

LINE TABLE DATA

L1	S70°37'14"W	19.58'
L2	N81°21'07"E	67.70'

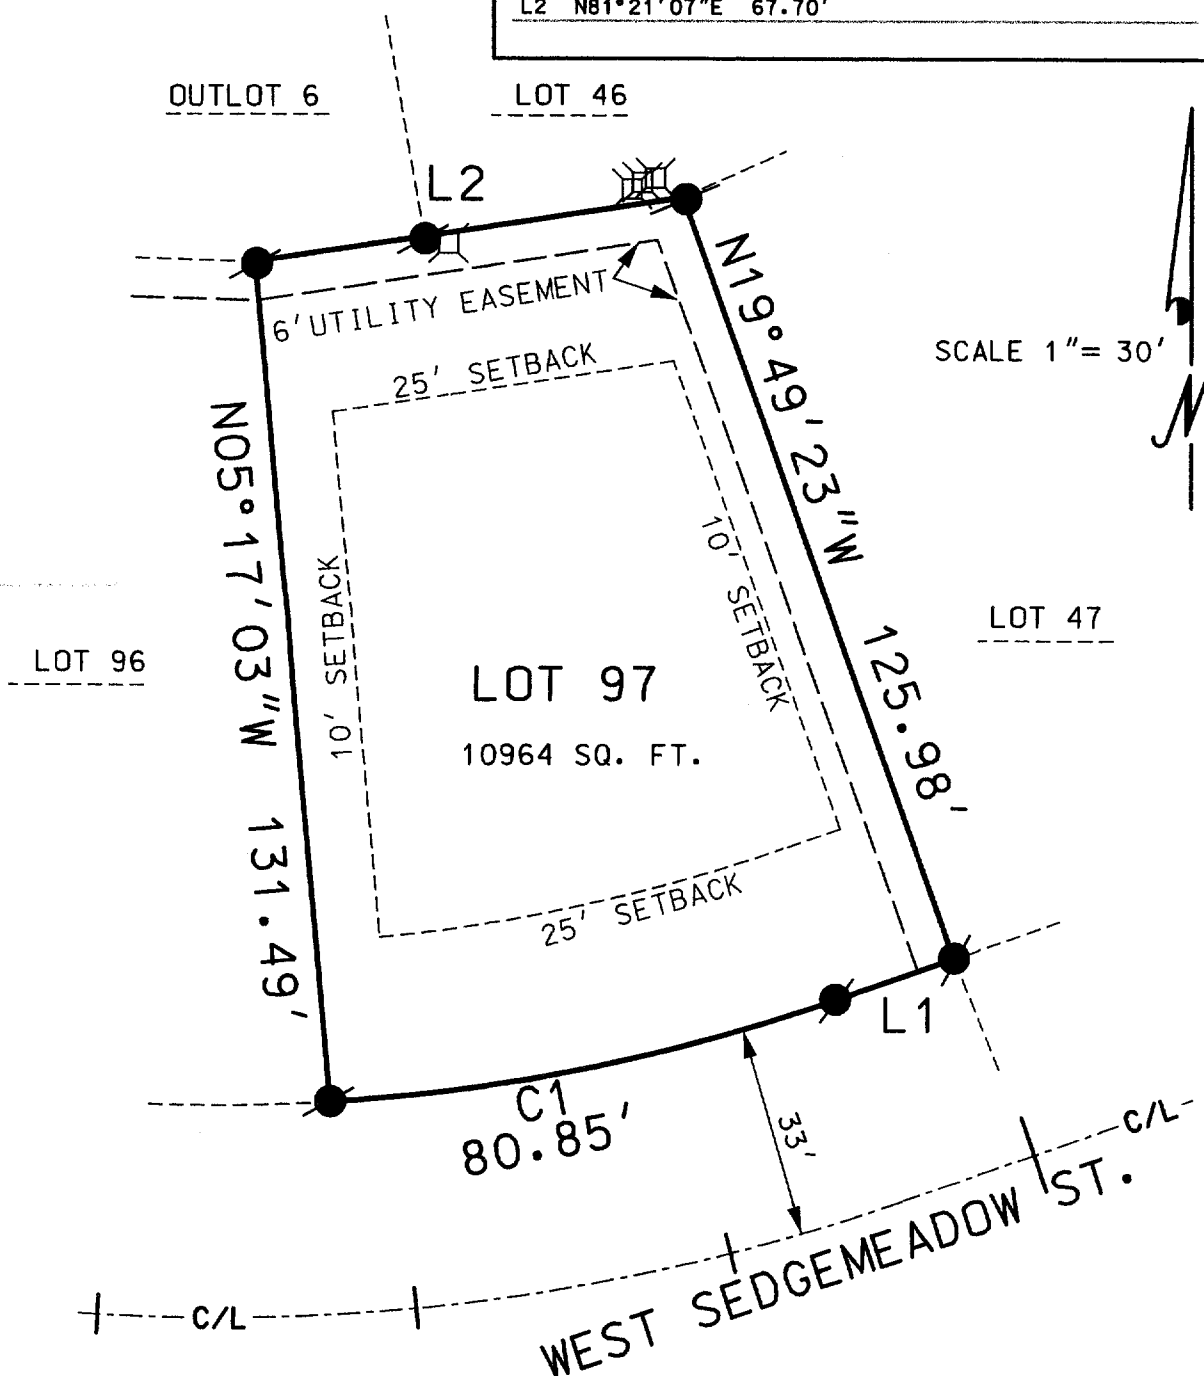

I PAUL H. VAN HENKELUM R.L.S. # 1931 HEREBY CERTIFY THAT THIS SURVEY WAS MADE IN ACCORDANCE WITH THE MINIMUM STANDARDS FOR PROPERTY SURVEYS (CHAPTER A-E7) STATE OF WISCONSIN AND HAS BEEN PREPARED UNDER MY DIRECTION AND CONTROL AND IS CORRECT TO THE BEST OF MY KNOWLEDGE AND BELIEF.

Paul H. Van Henkelum
PAUL H. VAN HENKELUM, R.L.S. # 1931
RSV# 00291 291LOT97.DGN



004-1689

YEW1-97