


HOLLAND & THOMAS, L.L.C. - LAND SURVEYORS

202 West Street Johnson Creek, WI 53038 (920) 699-3305


PLAT OF SURVEY

FOR LOT 44 OF JACKSON CREEK EAST SUBDIVISION, LOCATED IN THE SW 1/4
AND SE 1/4 OF THE SOUTHWEST QUARTER OF SECTION 7, TOWN 2 NORTH,
RANGE 17 EAST, CITY OF ELKHORN, WALWORTH COUNTY, WISCONSIN.

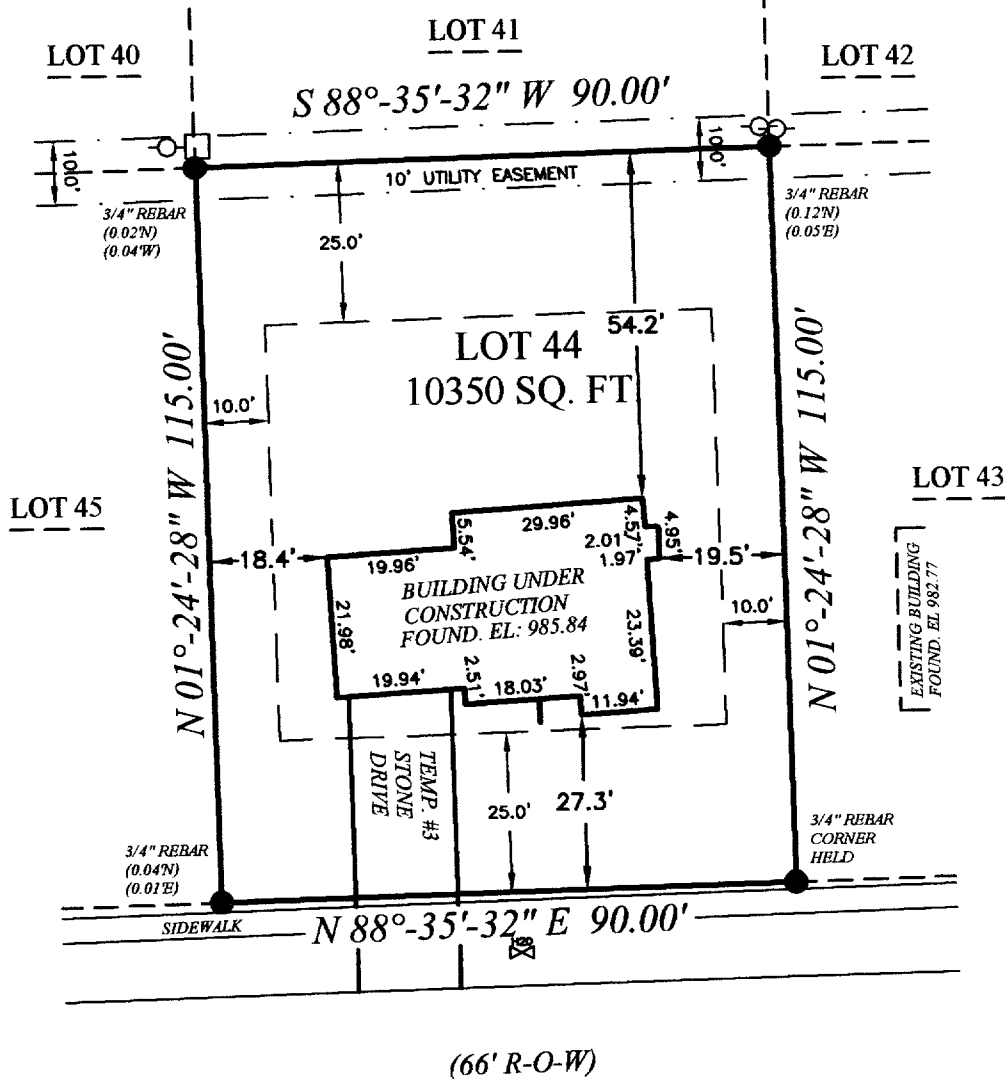


SOUTH CREEK DRIVE

IF THE SURVEYOR'S SEAL IS NOT
RED, THE PLAN IS A COPY THAT
SHOULD BE ASSUMED TO CONTAIN
UNAUTHORIZED ALTERATIONS. THE
CERTIFICATION CONTAINED ON THIS
DOCUMENT DOES NOT APPLY TO
COPIES UNLESS THEY TOO HAVE A
RED STAMP OVER THE PHOTOCOPIED
STAMP BY SAME SURVEYOR.

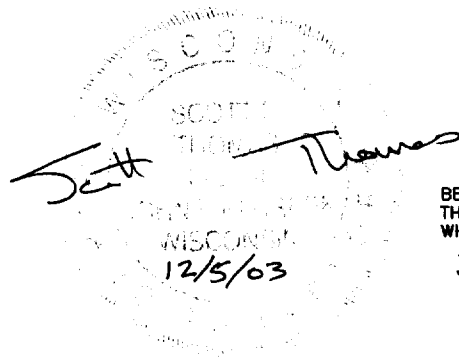

BEARINGS ARE REFERENCED TO THE SOUTH LINE OF
THE SOUTHWEST QUARTER OF SECTION 7-2-17,
WHICH IS ASSUMED TO BEAR S 88°45'03" W.

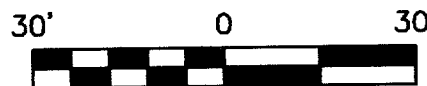

State of Wisconsin } SS.
County of Jefferson }

We, Holland & Thomas, L.L.C., do hereby certify that we have made this survey and that the information as shown on the above
Plat of Survey is a true and correct representation thereof.

LEGEND: These standard symbols may be found in the drawing.

- Lot Corner (Found) w/desc.
- Utility Pedestal
- Elec. Trans. Box
- ⊕ Man Hole w/type
- ⊗ Water Valve
- Easement Boundary
- Setback Line

BUILDER: BROOKSTONE HOMES, INC.
1230 Corporate Center Dr.
SUITE 200
OCONOMOWOC, WI 53066
PHONE: (262) 567-5700
FAX: (262) 567-7228

C:\Holland&Thomas\2003\0310\031003AB.dwg; Drawn By: NLH; Checked By: SDT; 12-05-03.

JAN 20

YJ

YJCE-44

004-1696