


PLAT OF SURVEY

A PARCEL OF LAND LOCATED IN THE NW 1/4 OF THE SW 1/4 OF SECTION 19, TOWN 3 NORTH, RANGE 17 EAST, TOWN OF LAFAYETTE, WALWORTH COUNTY, WISCONSIN, DESCRIBED AS FOLLOWS, TO-WIT: BEGIN AT A POINT ON THE EAST-WEST 1/4 SECTION OF SAID SECTION 19, LOCATED 202.82 FEET EAST OF THE WEST 1/4 CORNER; THENCE CONTINUE EAST 87.00 FEET, THENCE S 0°58' E, 219.42 FEET; THENCE S 89°47' W, 87.00 FEET; THENCE N 0°58' W, 219.74 FEET TO THE POINT OF BEGINNING AND LOTS 1 AND 2 OF CERTIFIED SURVEY MAP NO. 1826.


OWNER: RANDOLPH THELEN
P.O. BOX 17
ELKHORN, WI. 53121

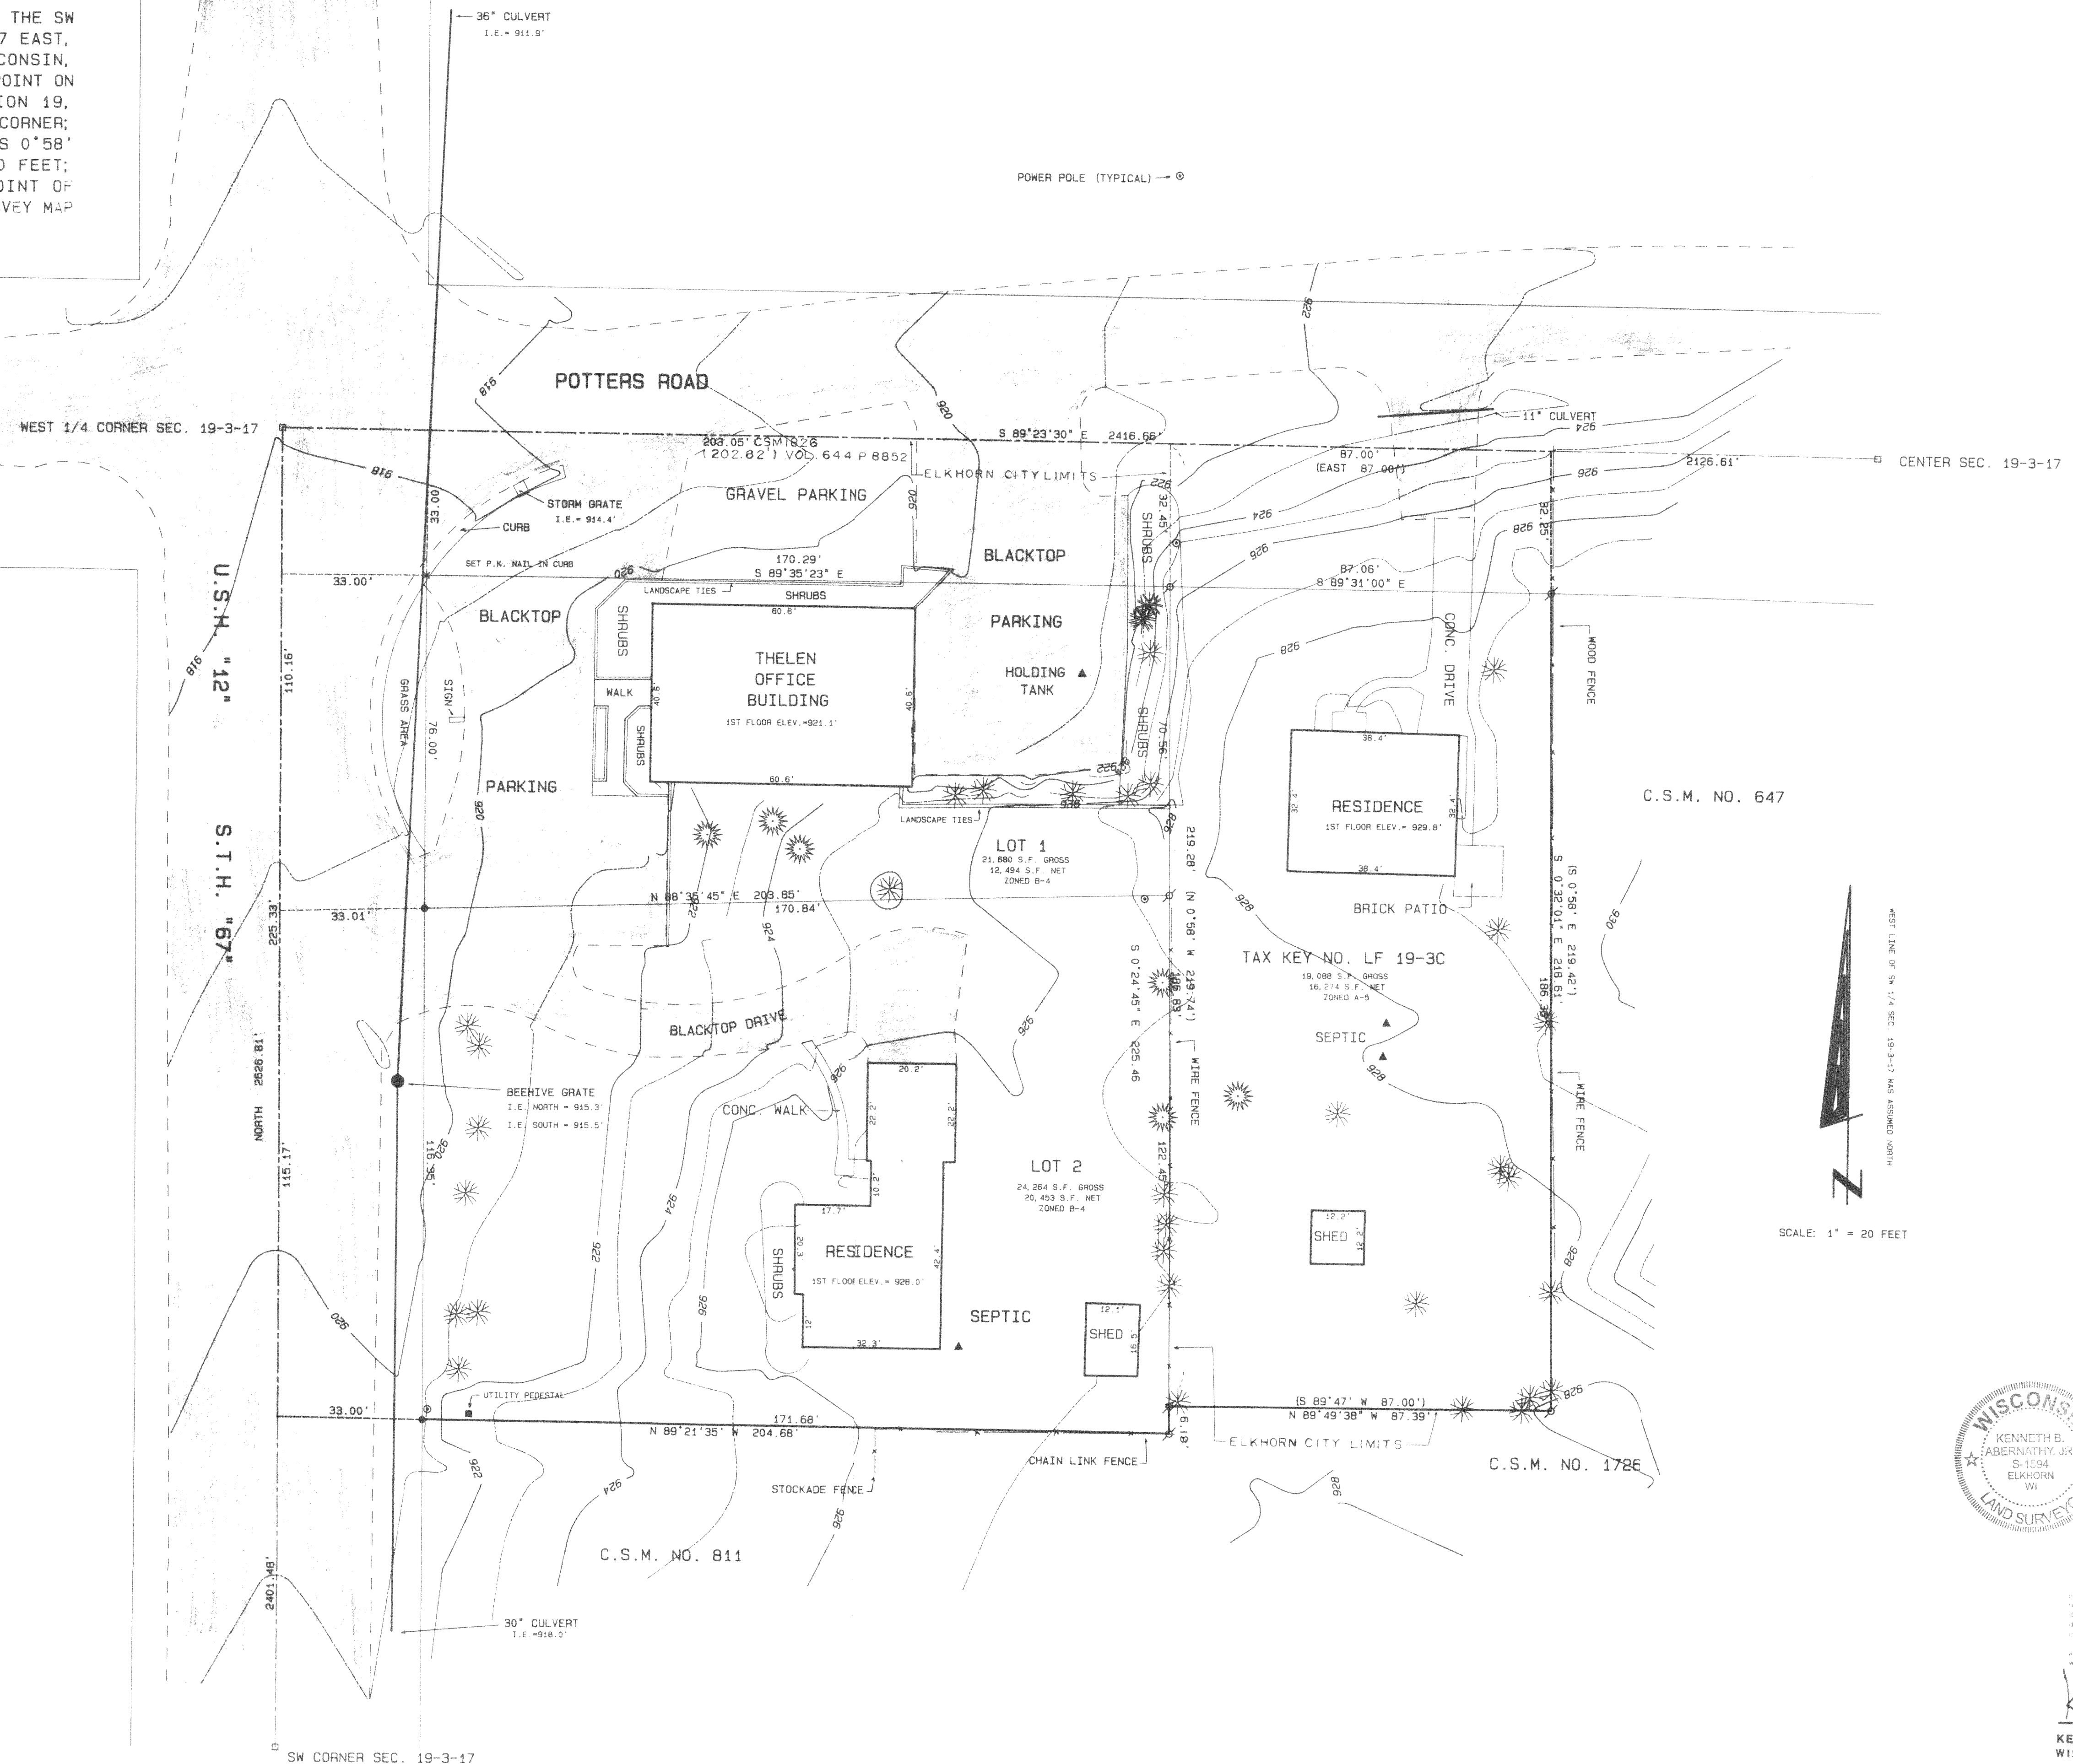

SCALE: 1" = 20 FEET

Legend

- ✓ FOUND IRON PIPE
- FOUND IRON ROD
- FOUND BRASS CLAPPED MONUMENT
- * FOUND CONCRETE MONUMENT
- CHISEL CUT IN CONCRETE
- SET IRON ROD, 24" LONG, WEIGHING 1.5 LBS. LINEAL FT., 3/4" DIA.
- SET IRON ROD, 10" LONG, WEIGHING 4.5 LBS. LINEAL FT., 1.11 16" DIA
- (xx) RECORDED AS DIMENSION
- x - - - - - EXISTING FENCE

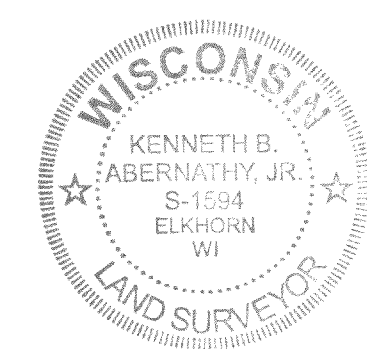

SCALE: 1" = 20 FEET

within one year from date hereof

Kenneth B. Abernathy, Jr.

KENNETH B. ABERNATHY, JR.
WISCONSIN REGISTERED LAND SURVEYOR,
S-1594

REVISÉ 1-9-98

Date: AUGUST 8, 1997 Job No. 97.709

004-1713