


1-6-62

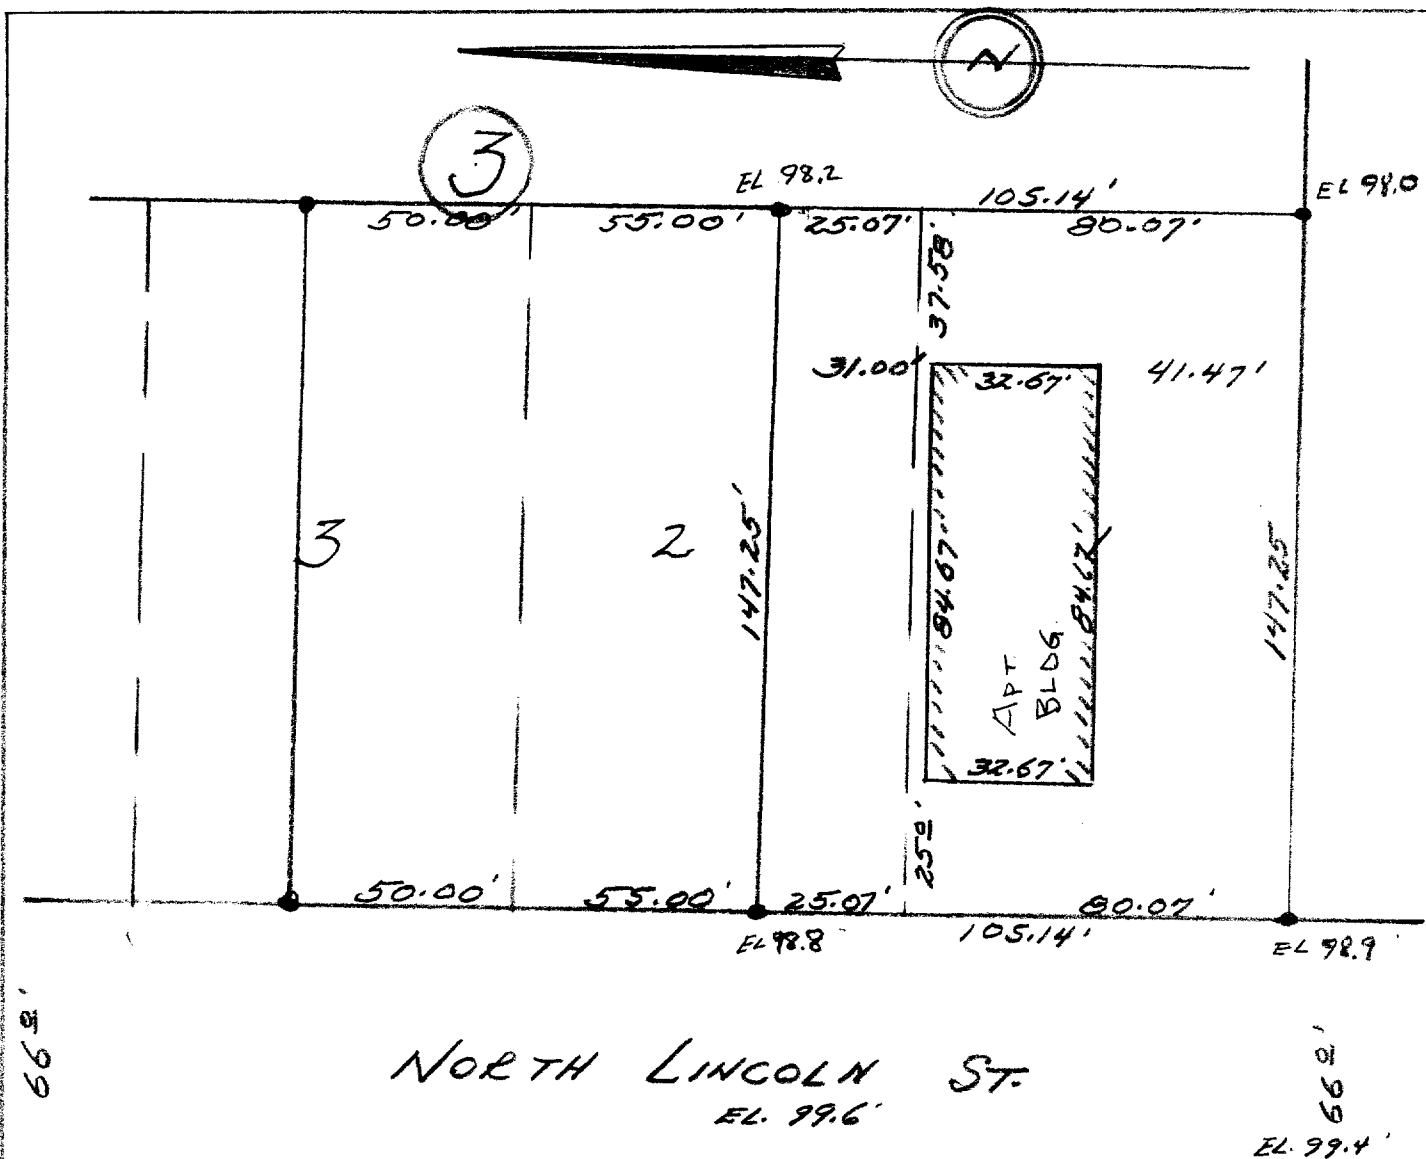

DESCRIPTION:


The South 25.07 feet of Lot 2, Block 3, and all of Lot 1, Block 3, of Tree Towns Subdivision of a portion of the City of Elkhorn, Walworth County, Wisconsin.

CERTIFICATE:

I, James F. Biagi, surveyor, do hereby certify that I have surveyed the property hereon described and that the location of all improvements are as shown on the above drawing.

SIGNED AND SEALED ON THIS THE 20TH DAY OF JULY, 1962.

July 19 1962.

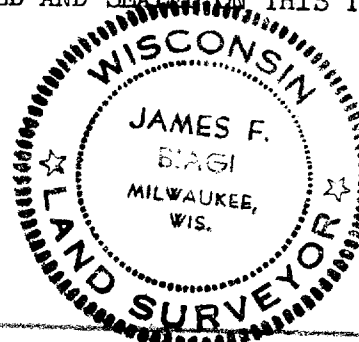

James F. Biagi
James F. Biagi, RLS 272
Elkhorn, Wisconsin

TTS-19

4-171B