

PREPARED FOR: JANE St. JOHN


J.K. SURVEYING INC.
N3705 WILLOWBEND LANE
LAKE GENEVA, WI 53147
(262) 248-3697

COUNTY TRUNK HIGHWAY "H"

(66' WIDE)

GLENRIDGE LANE

(50.0' WIDE)

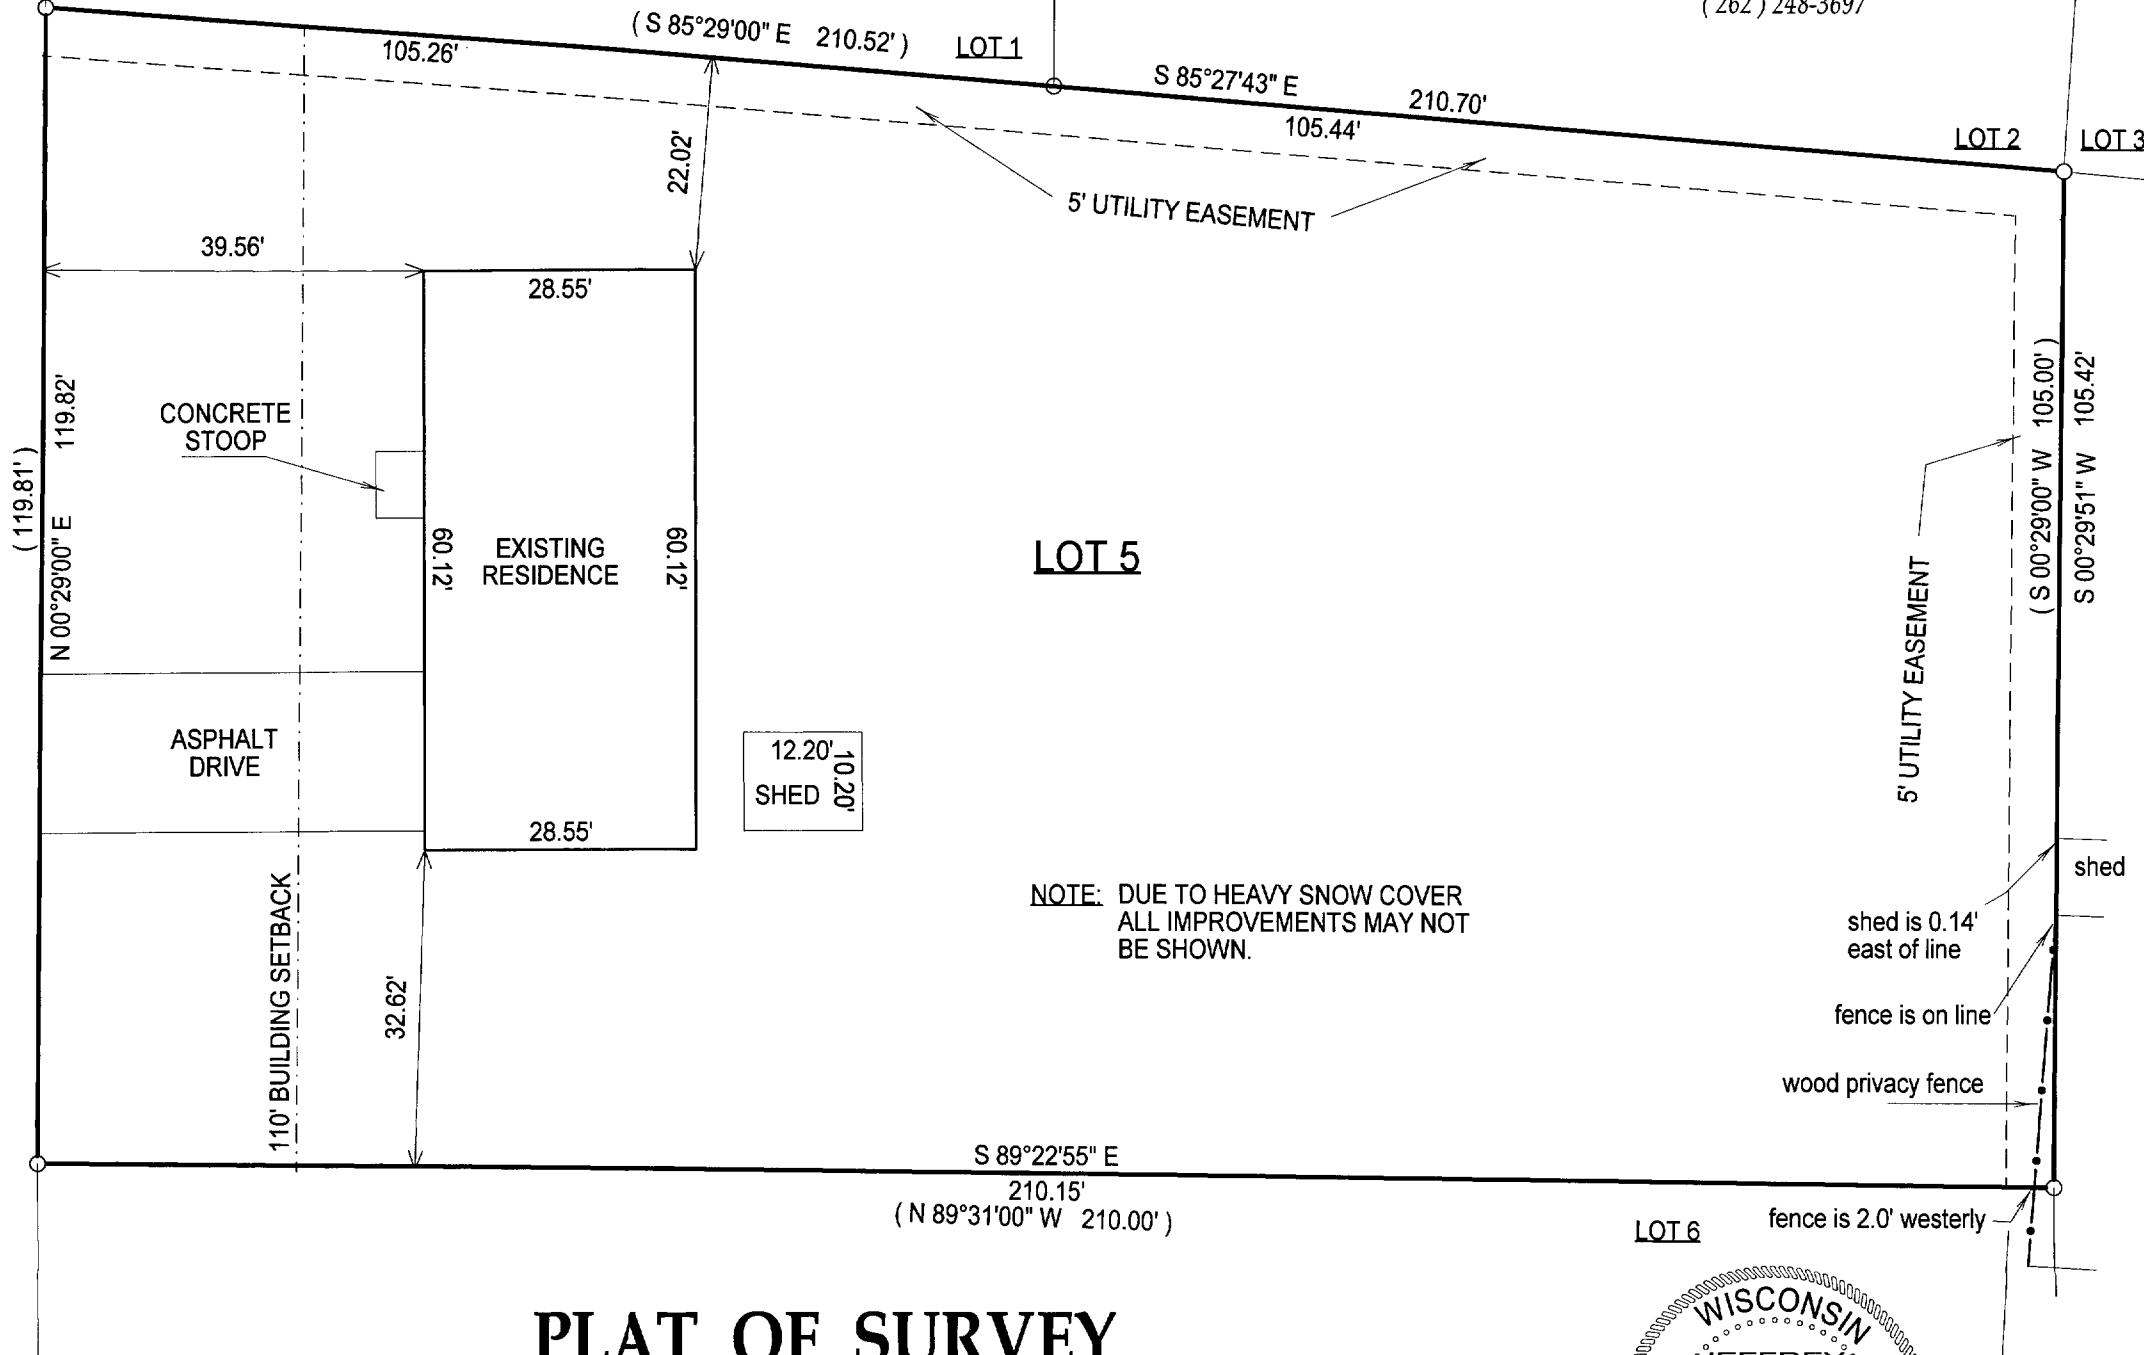

PLAT OF SURVEY

- OF -

LOT 5 GREEN ACRES SUBDIVISION, ACCORDING TO THE RECORDED PLAT THEREOF,
CITY OF ELKHORN, WALWORTH COUNTY, WISCONSIN, LOCATED IN THE NW 1/4 OF
THE NW 1/4 OF SECTION 8, TOWN 2 NORTH, RANGE 17 EAST.

COMPARE LEGAL DESCRIPTION ABOVE AND DRAWING WITH DEED. FOR BUILDING RESTRICTIONS AND
EASEMENTS NOT SHOWN, REFER TO DEED, ABSTRACT SOURCES AND LOCAL MUNICIPAL CODES. NOTIFY
THE SURVEYOR IMMEDIATELY OF ANY DISCREPANCY.


"I hereby certify that I have surveyed the above described property and that
the above map, to the best of my knowledge and belief, is a true representation
thereof and shows the size and location of all visible structures, apparent
easements and encroachments if any."
This survey is made for the present owners of the property, and those who
purchase, mortgage, or guarantee the title thereto, within one year from
the date hereof.

- () = RECORDED AS
- = FOUND IRON BAR
- = FOUND IRON PIPE
- = SET IRON BAR
- = SET IRON PIPE

SCALE: 1" = 20'

JOB #: 04-044

TAX ID #: YGR00005

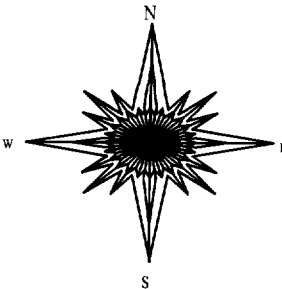

DATED THIS 9 TH, DAY OF FEBRUARY 2004.

MAR 3



JEFFREY L. KIMPS S-2436
Wisconsin Registered Land Surveyor
(original if signed in red)

KW

004-1721