


59-30


4-173B

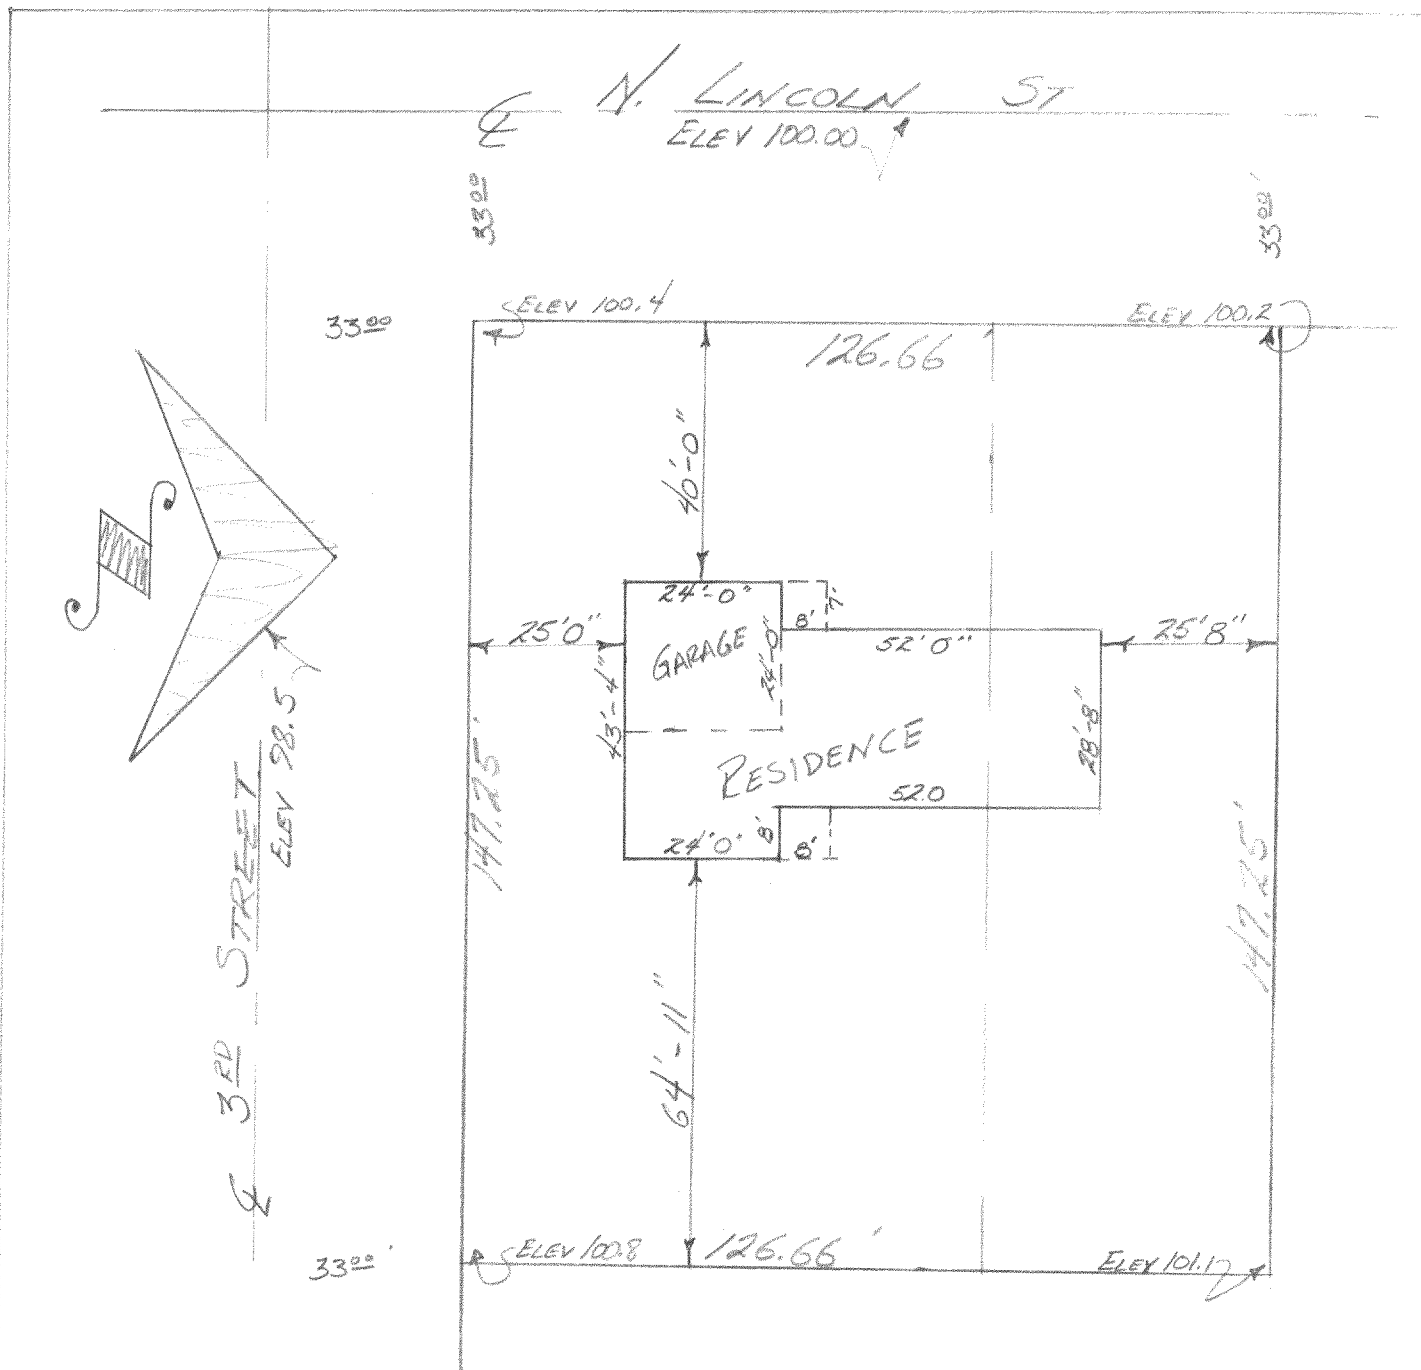

DESCRIPTION: Lot 1 and the South 44.83 feet of lot 2, of Block 1 Tree Towns Subdivision in the City of Elkhorn, Walworth County, Wisconsin.

CERTIFICATE: I James F Biagi, surveyor, do hereby certify that I have surveyed the above described property, and that the location of all the improvements are as shown on the drawing above

SIGNED AND SEALED THIS 15TH DAY OF AUGUST 1959

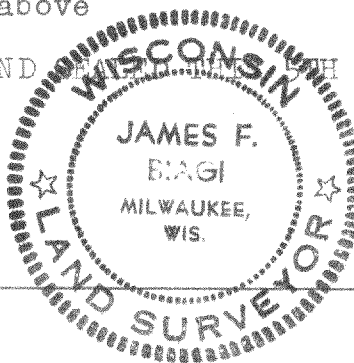

James F. Biagi
Surveyor (212)

YTT-1

4-173B