


PLAT OF SURVEY
LOT 7 OF FAIRWAYS EDGE BUSINESS PARK
TOWN OF SUGAR CREEK, WALWORTH COUNTY, WISCONSIN


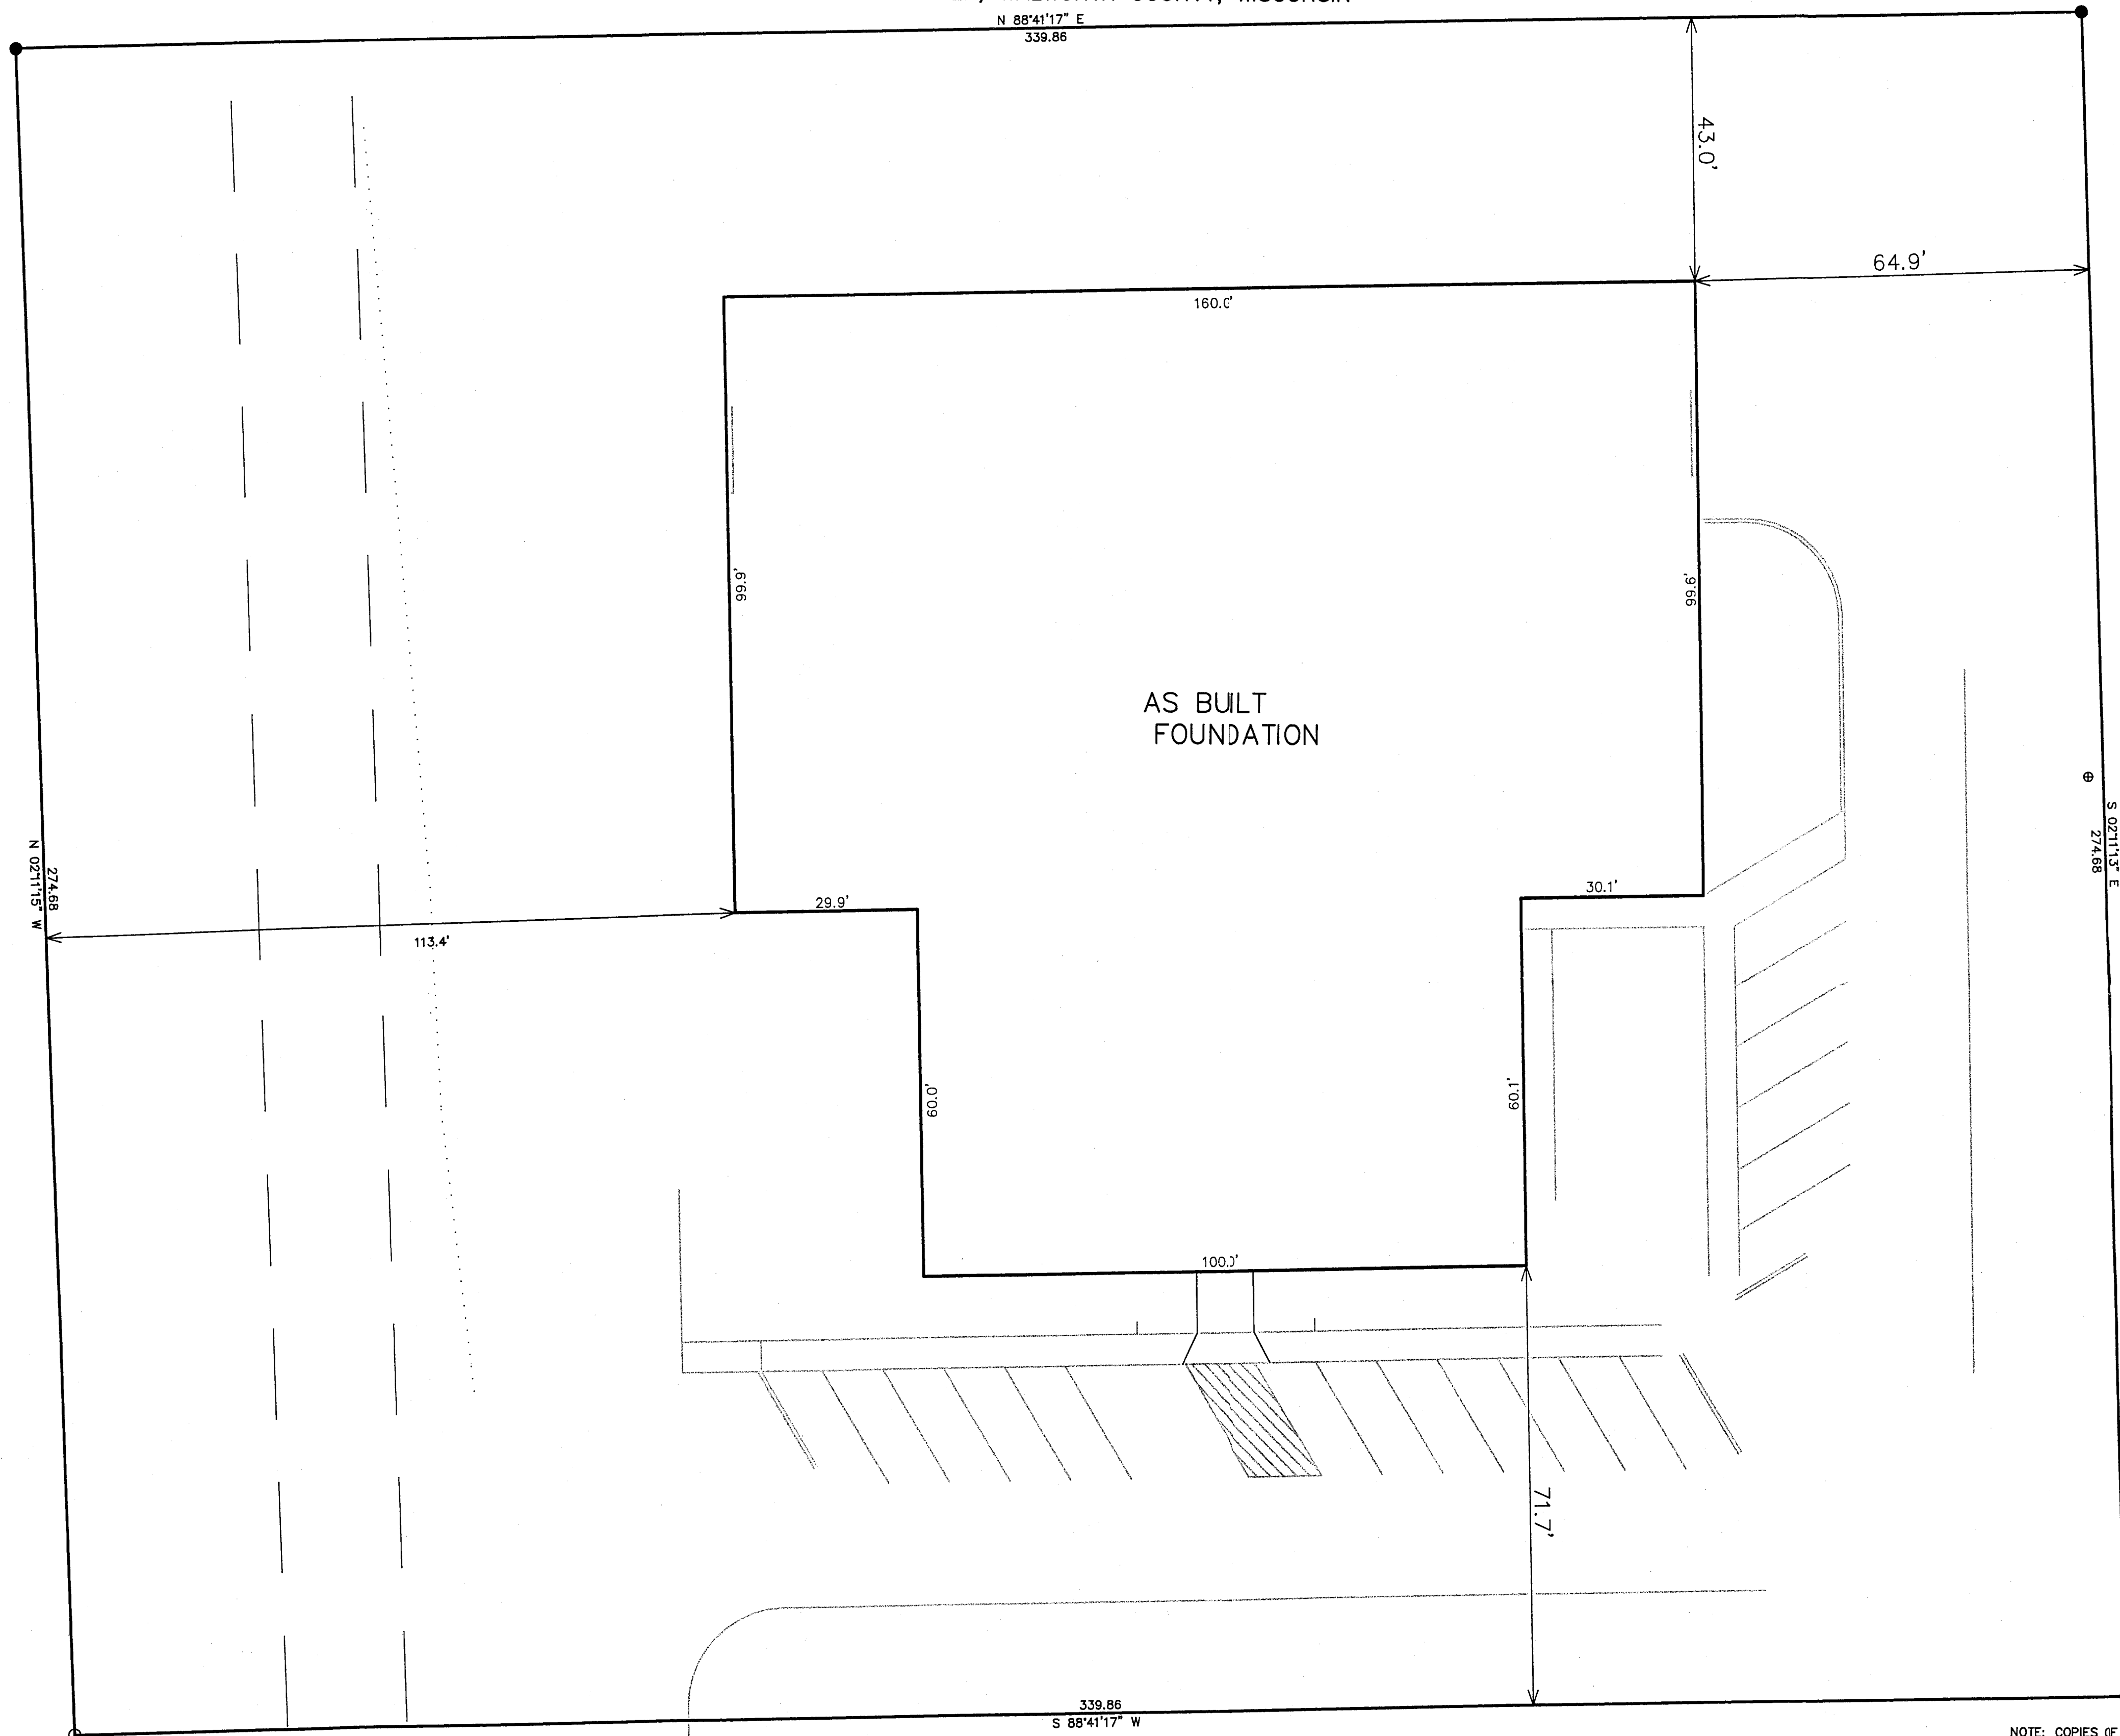


LEGEND
○ = FOUND IRON PIPE STAKE
● = SET IRON REBAR STAKE

NOTE: COPIES OF THIS MAP TO WHICH THE FOLLOWING CERTIFICATE WILL APPLY SHOW SURVEYOR'S ORIGINAL SEAL AND SIGNATURE IN RED INK. COPIES BY ANY OTHER MEANS MAY HAVE ALTERATIONS WHICH DO NOT REPRESENT THE SURVEYOR'S WORK PRODUCT.

I HEREBY CERTIFY THAT THE ABOVE DESCRIBED PROPERTY HAS BEEN SURVEYED UNDER MY DIRECTION AND THAT THE ABOVE MAP IS A TRUE REPRESENTATION THEREOF AND SHOWS THE SIZE AND LOCATION OF THE PROPERTY AND ITS EXTERIOR BOUNDARIES. THIS SURVEY IS MADE FOR THE USE OF THE PRESENT OWNERS OF THE PROPERTY, AND ALSO THOSE WHO PURCHASE, MORTGAGE, OR GUARANTEE THE TITLE THERETO WITHIN ONE YEAR FROM THE DATE HEREOF.

DATED: 5-26-2004
Peter S. Gordon R.L.S. 2101

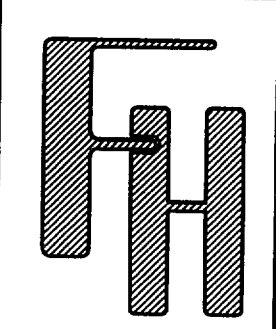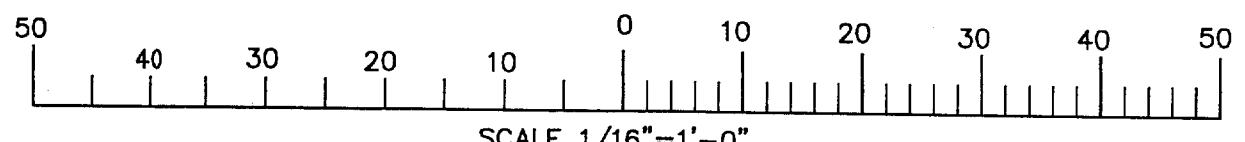

CORPORATE OFFICE SITE
L&G SHILTS ENTERPRISES
CITY OF ELKHORN, WALWORTH CO., WISCONSIN

FARRIS, HANSEN & ASSOCIATES, INC.
ENGINEERING - ARCHITECTURE - SURVEYING
7 RIDGWAY COURT P.O. BOX 437
ELKHORN, WISCONSIN 53121
OFFICE: (262) 723-2098 FAX: (262) 723-5966

REVISIONS	

PROJECT NO.	6343
DATE	07/31/03
SHEET NO.	1 OF 1

5/26/2004 X:\Projects\6343\0000\Survey
REV 23 2003

YFE 00007

004-1748