


61-58


12
11
10
9
8
7
6
5
4
3
2
1
t

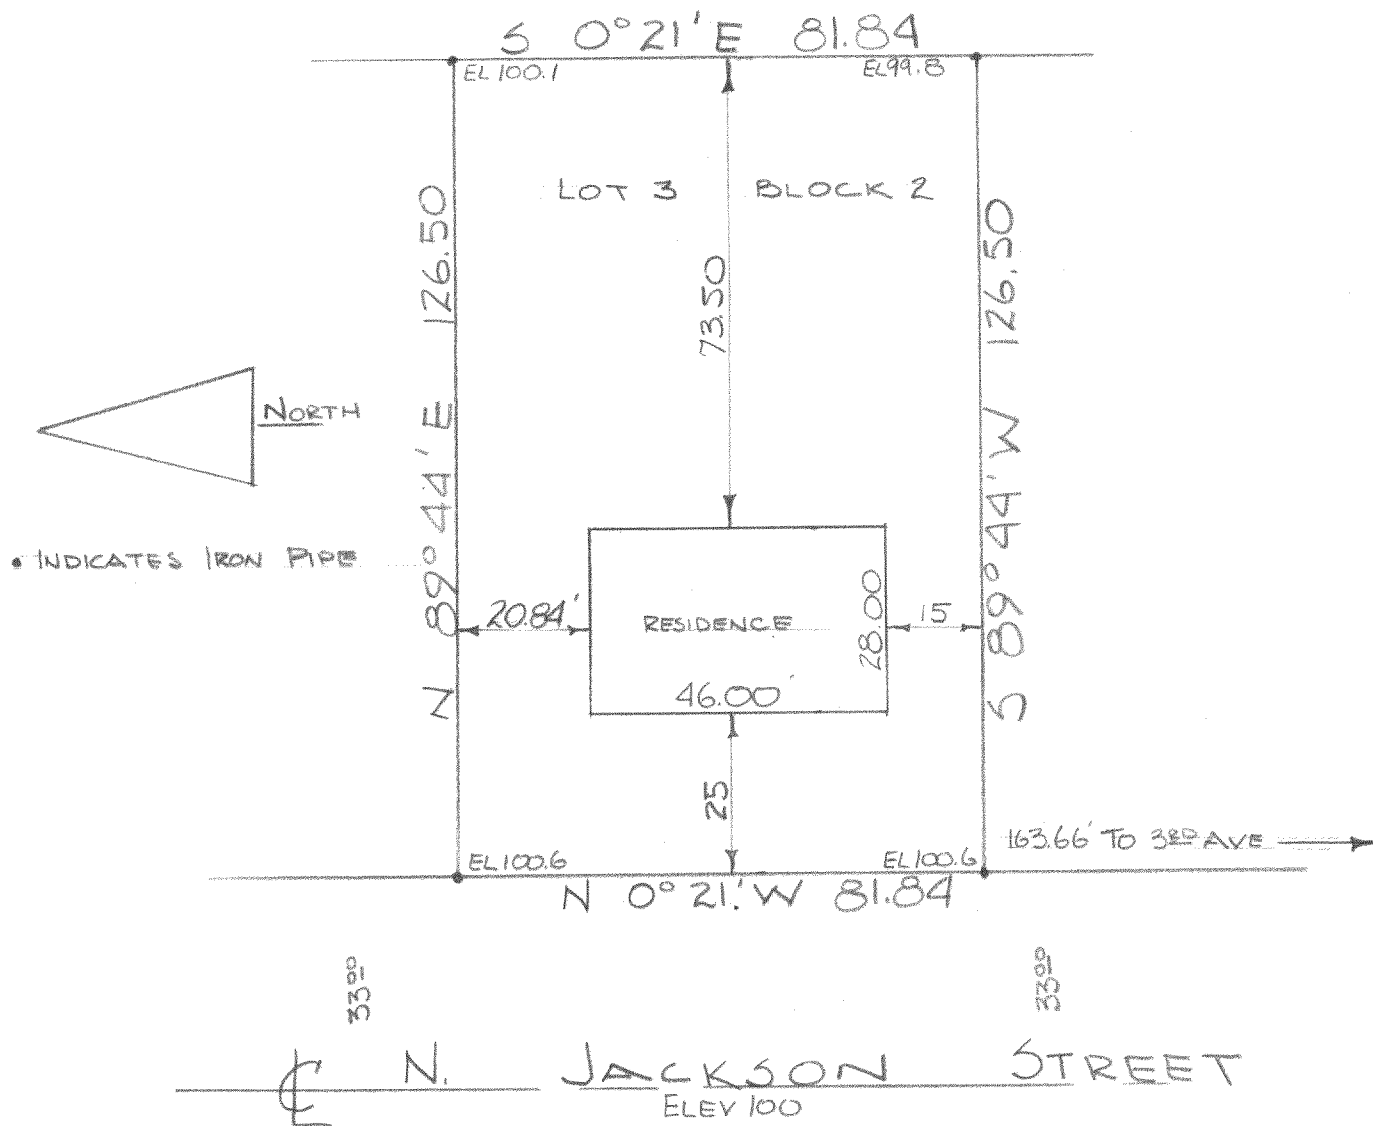

DESCRIPTION: Lot 3 of Block 2 of Tree Towns Subdivision in the City of Elkhorn, Walworth County, Wisconsin.

CERTIFICATE: I, James F. Biagi, surveyor do hereby certify that I have surveyed the property hereon described and that the location of the improvements are as shown on the above drawing.

July 7, 1961.

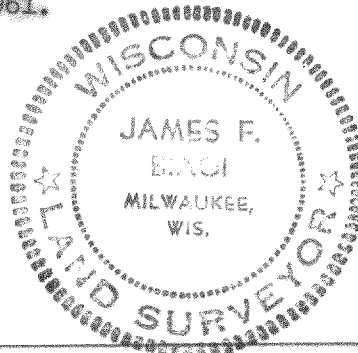

James F. Biagi

2851-7

YTT5-15

4-178B