


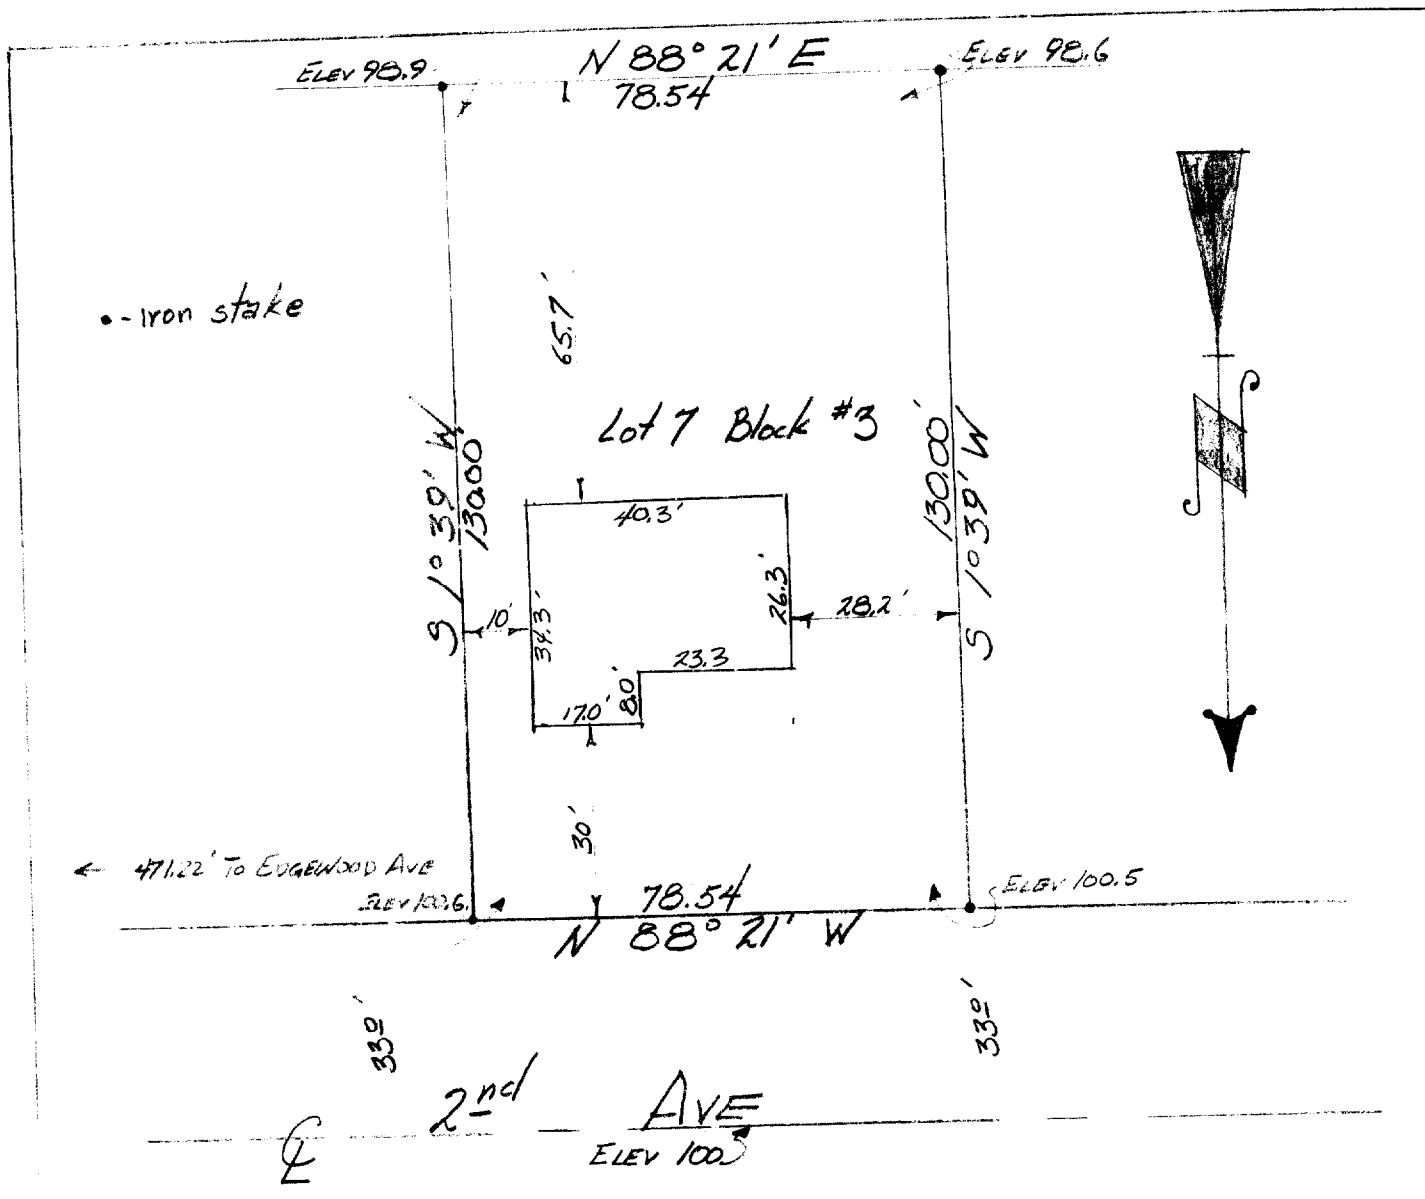


DESCRIPTION: Lot 7 of Block 3 of Edgewood Subdivision in the City of Elkhorn, Walworth County, Wisconsin.

CERTIFICATE:

I, James F. Biagi, surveyor, do hereby certify that I have surveyed the property hereon described, and that the locations of all the improvements are as shown above.

Signed and Sealed this 31 st day of October, 1959.

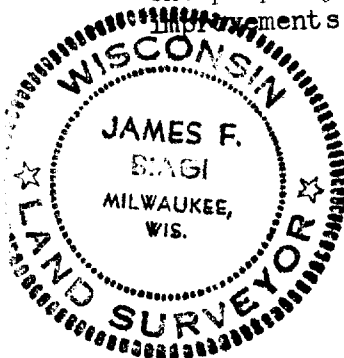

James F. Biagi
James F. Biagi, Surveyor