


DUNHAM & RASMUSSEN
SURVEYING & ENGINEERING
DELAVER, WISCONSIN

N

SCALE: 1"=10'

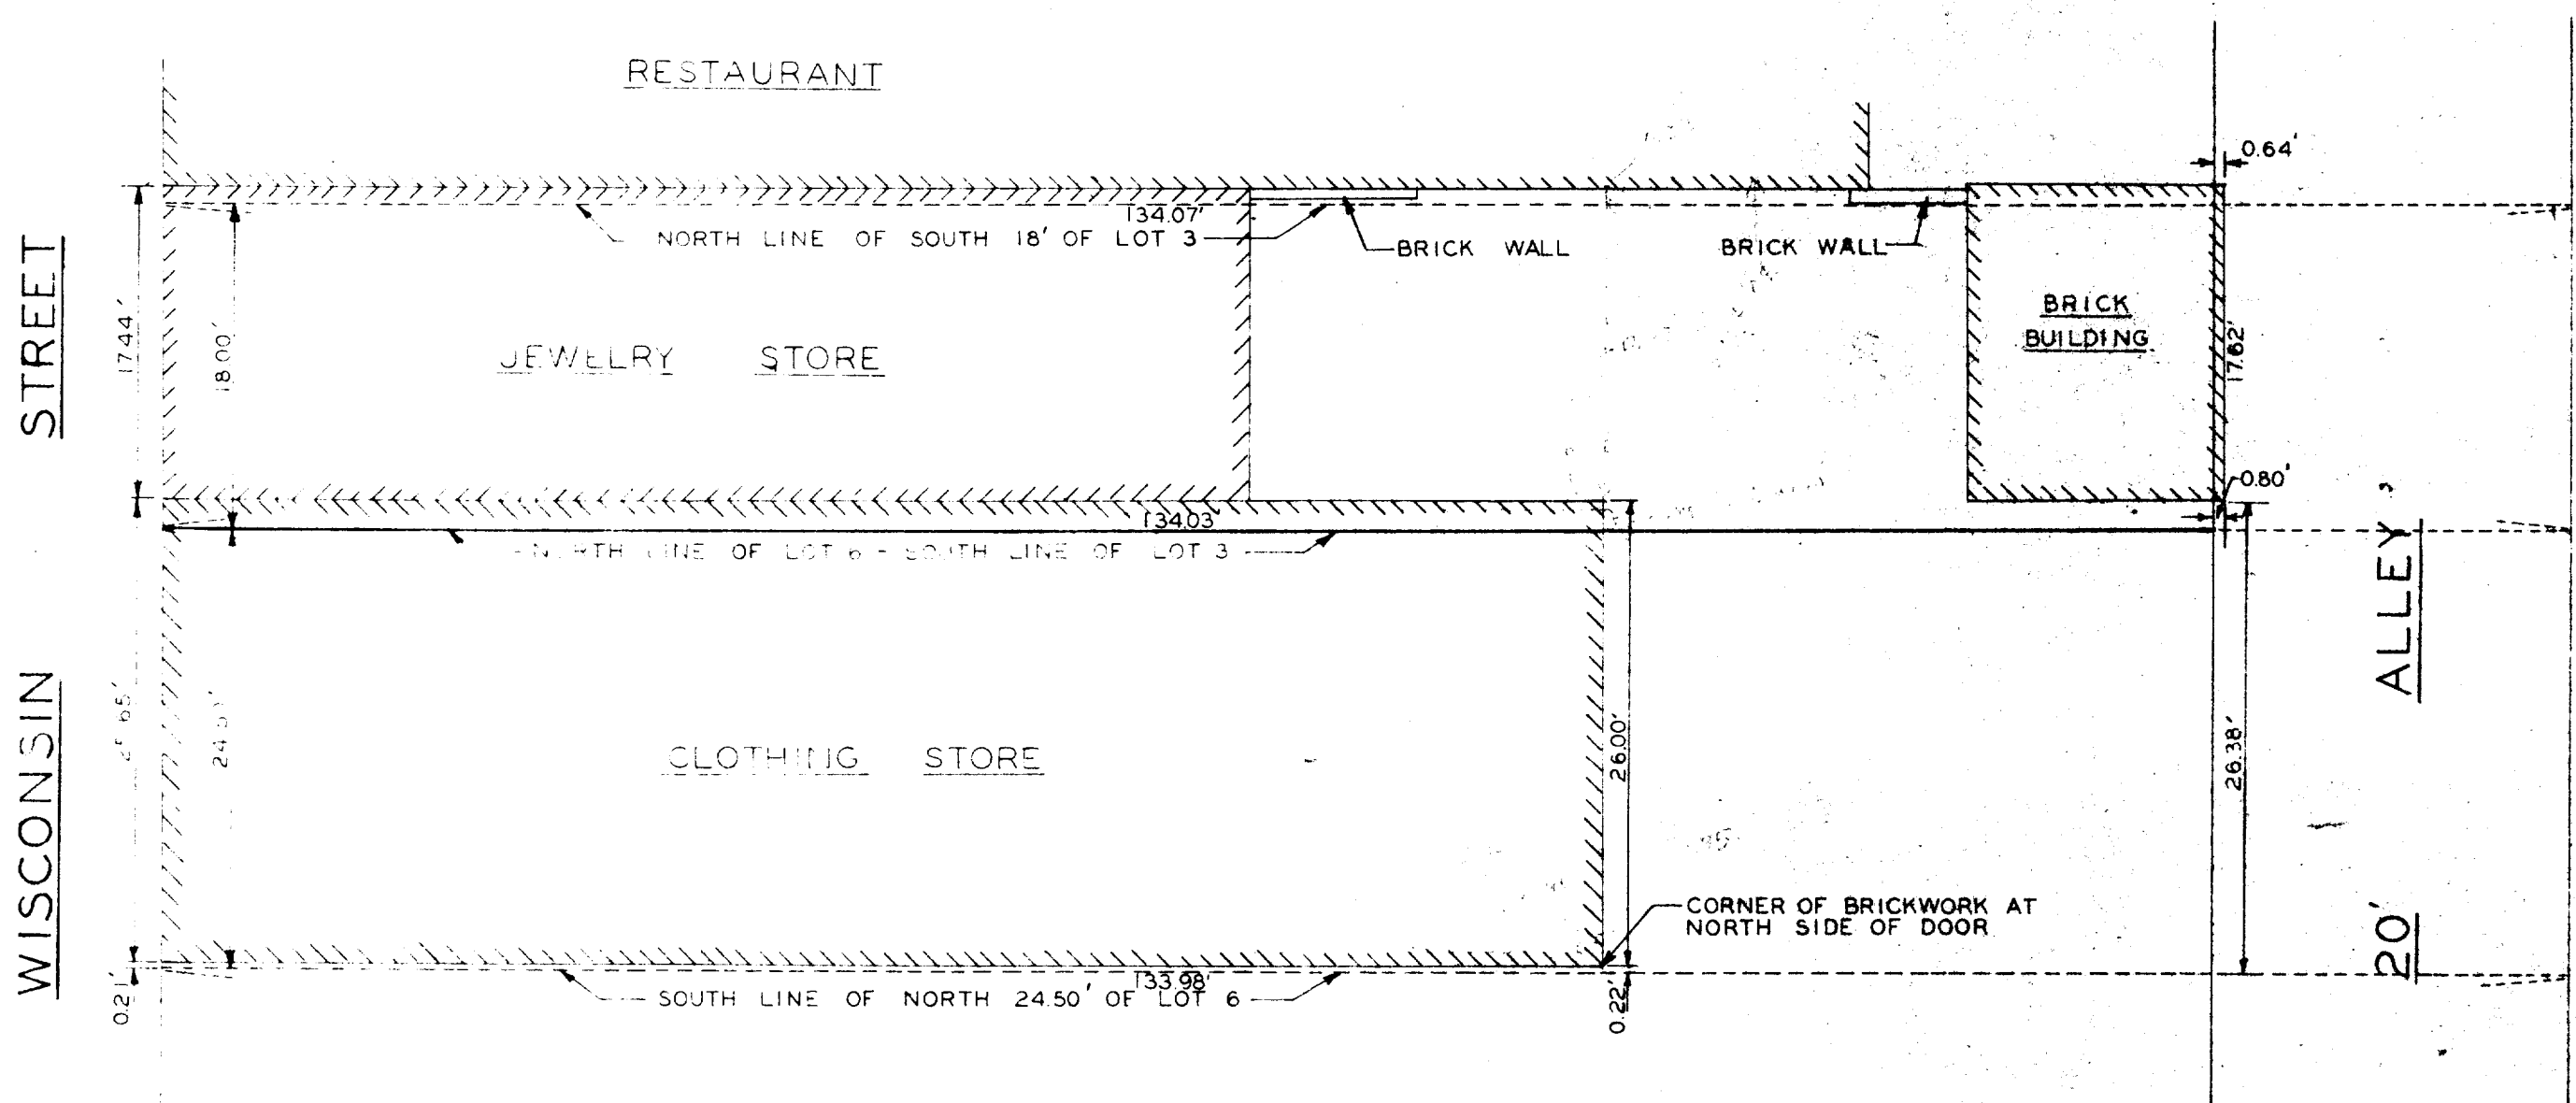

Plat of Survey of part of Lots 3 & 6 in Block No. 25 of the Village
of Elkhorn, Walworth County, Wisconsin.
November 1960

George T. Dunham, Surveyor