


L

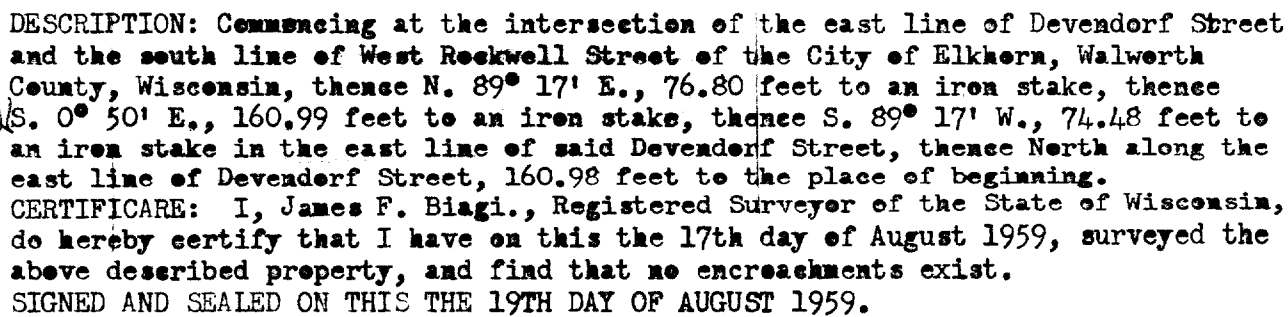


4-180B

STREET

DEVENDORF

33

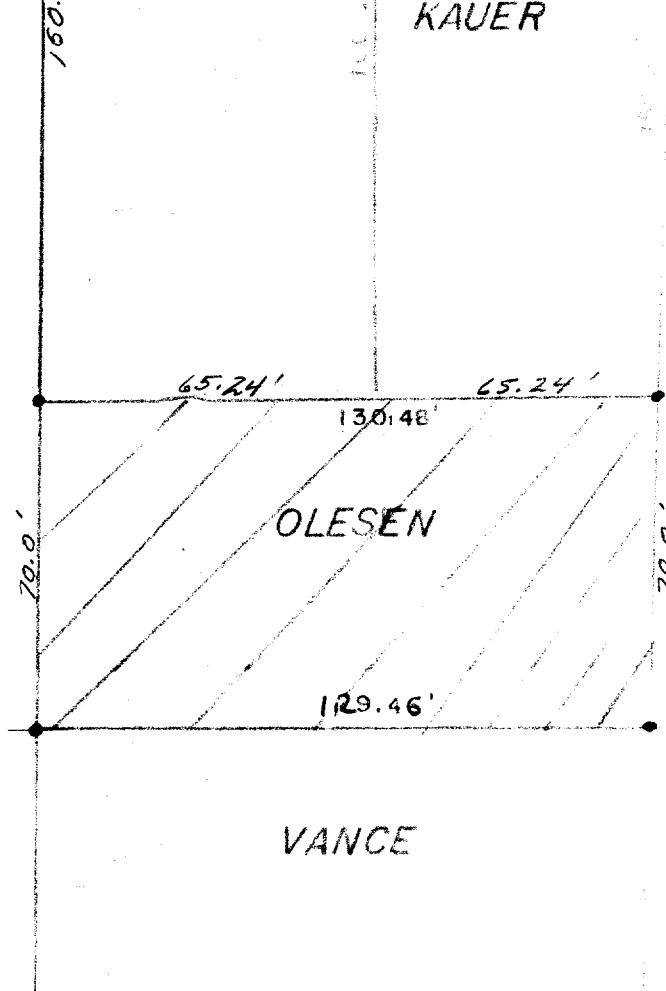

4-180B

Description:

Commencing at an iron stake in the east line of Devendorf Street of the City of Elkhorn, Walworth County, Wisconsin, that is 230.98 feet South of the south line of West Rockwell Street of said city, thence S. 89° 17' E., 129.46 feet to an iron stake, thence N. 00° 50' W., 70.0 feet to an iron stake thence N. 89° 17' W., 130.48 feet to an iron stake, in the east line of said Devendorf Street, thence South in the east line of said Devendorf Street, 70.0 feet to the place of beginning.

Certificate:

I, hereby certify that I have on this the 18th day of October, surveyed the above described property, and find that no encroachments exist.

Joseph M. Biagi, Registered Surveyor
Elkhorn Wisconsin.

V-SW-33
33A

NH 1-2-16

4-180B