


121-4

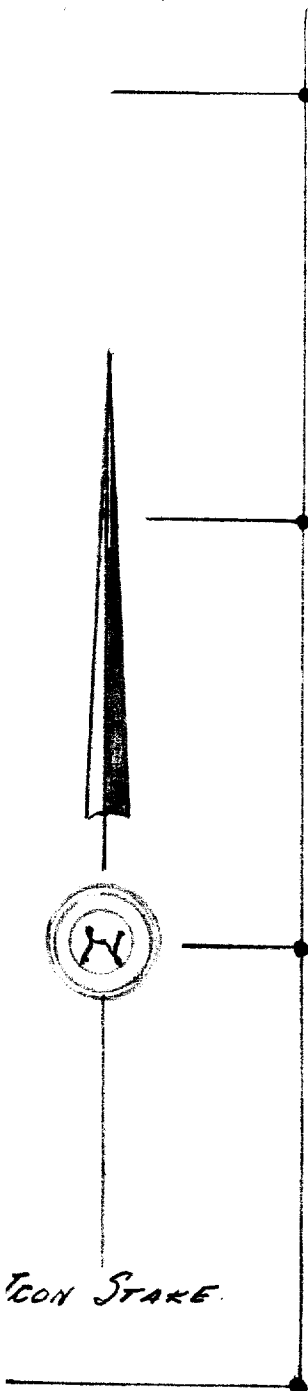


66.0'

ST.

SOUTH CHURCH

ST.

58-46

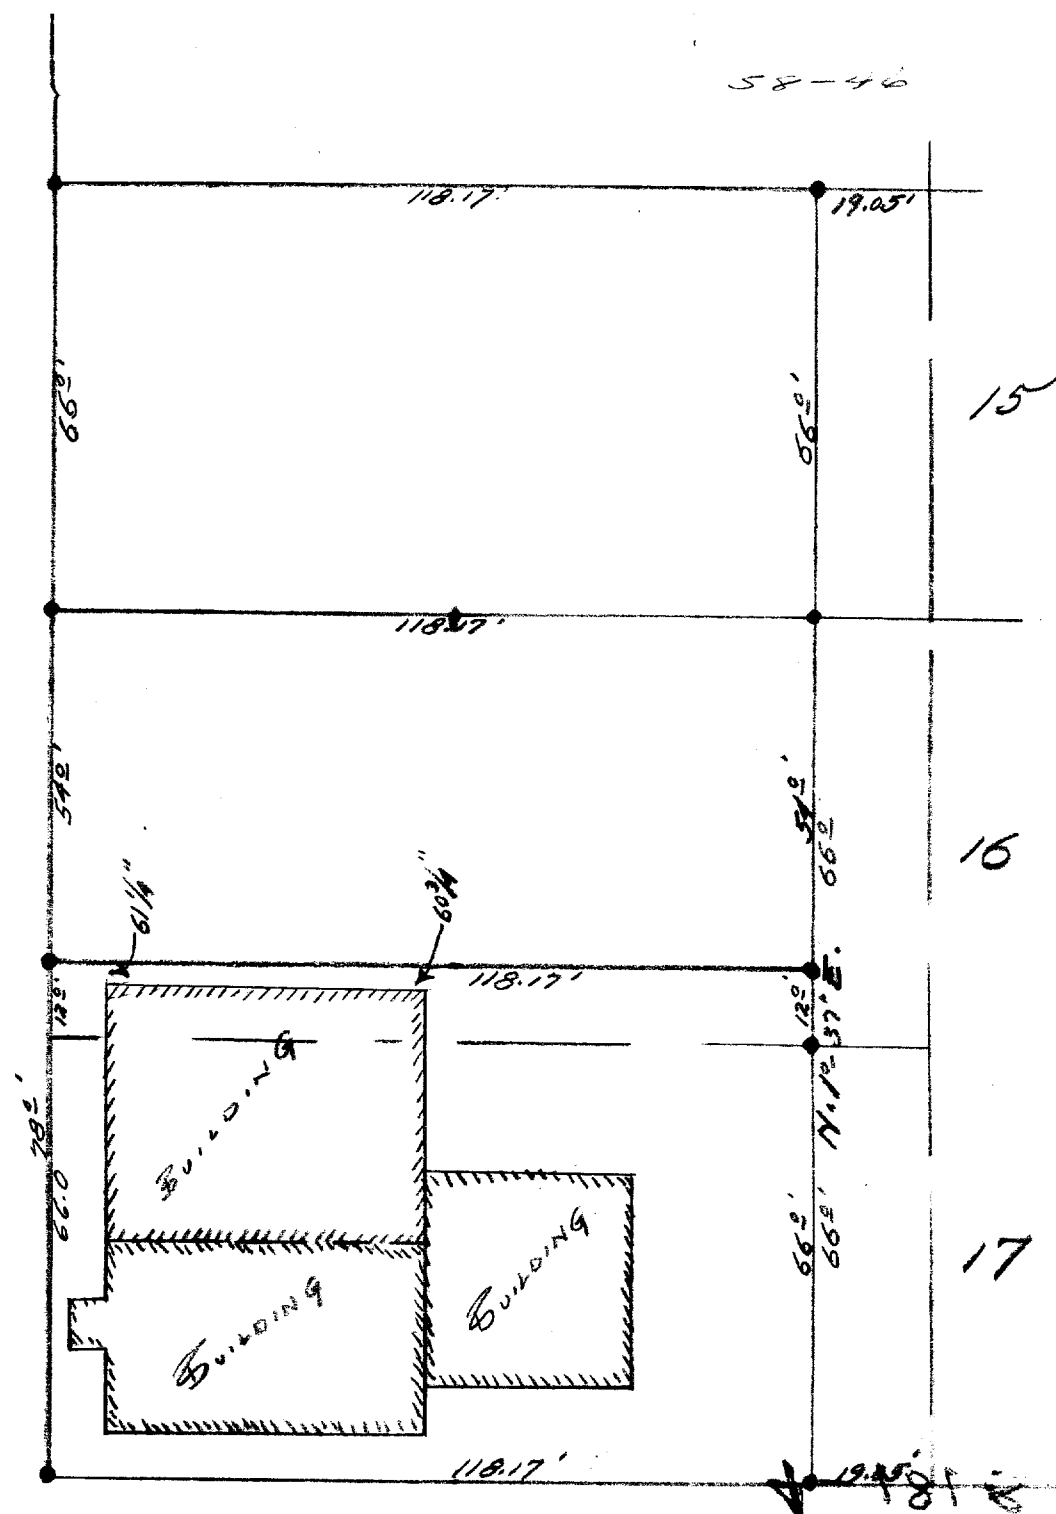

WEST

CENTRAILIA

ST.

7-181B

U-SW-48.48A.52 NE 1-1-2