


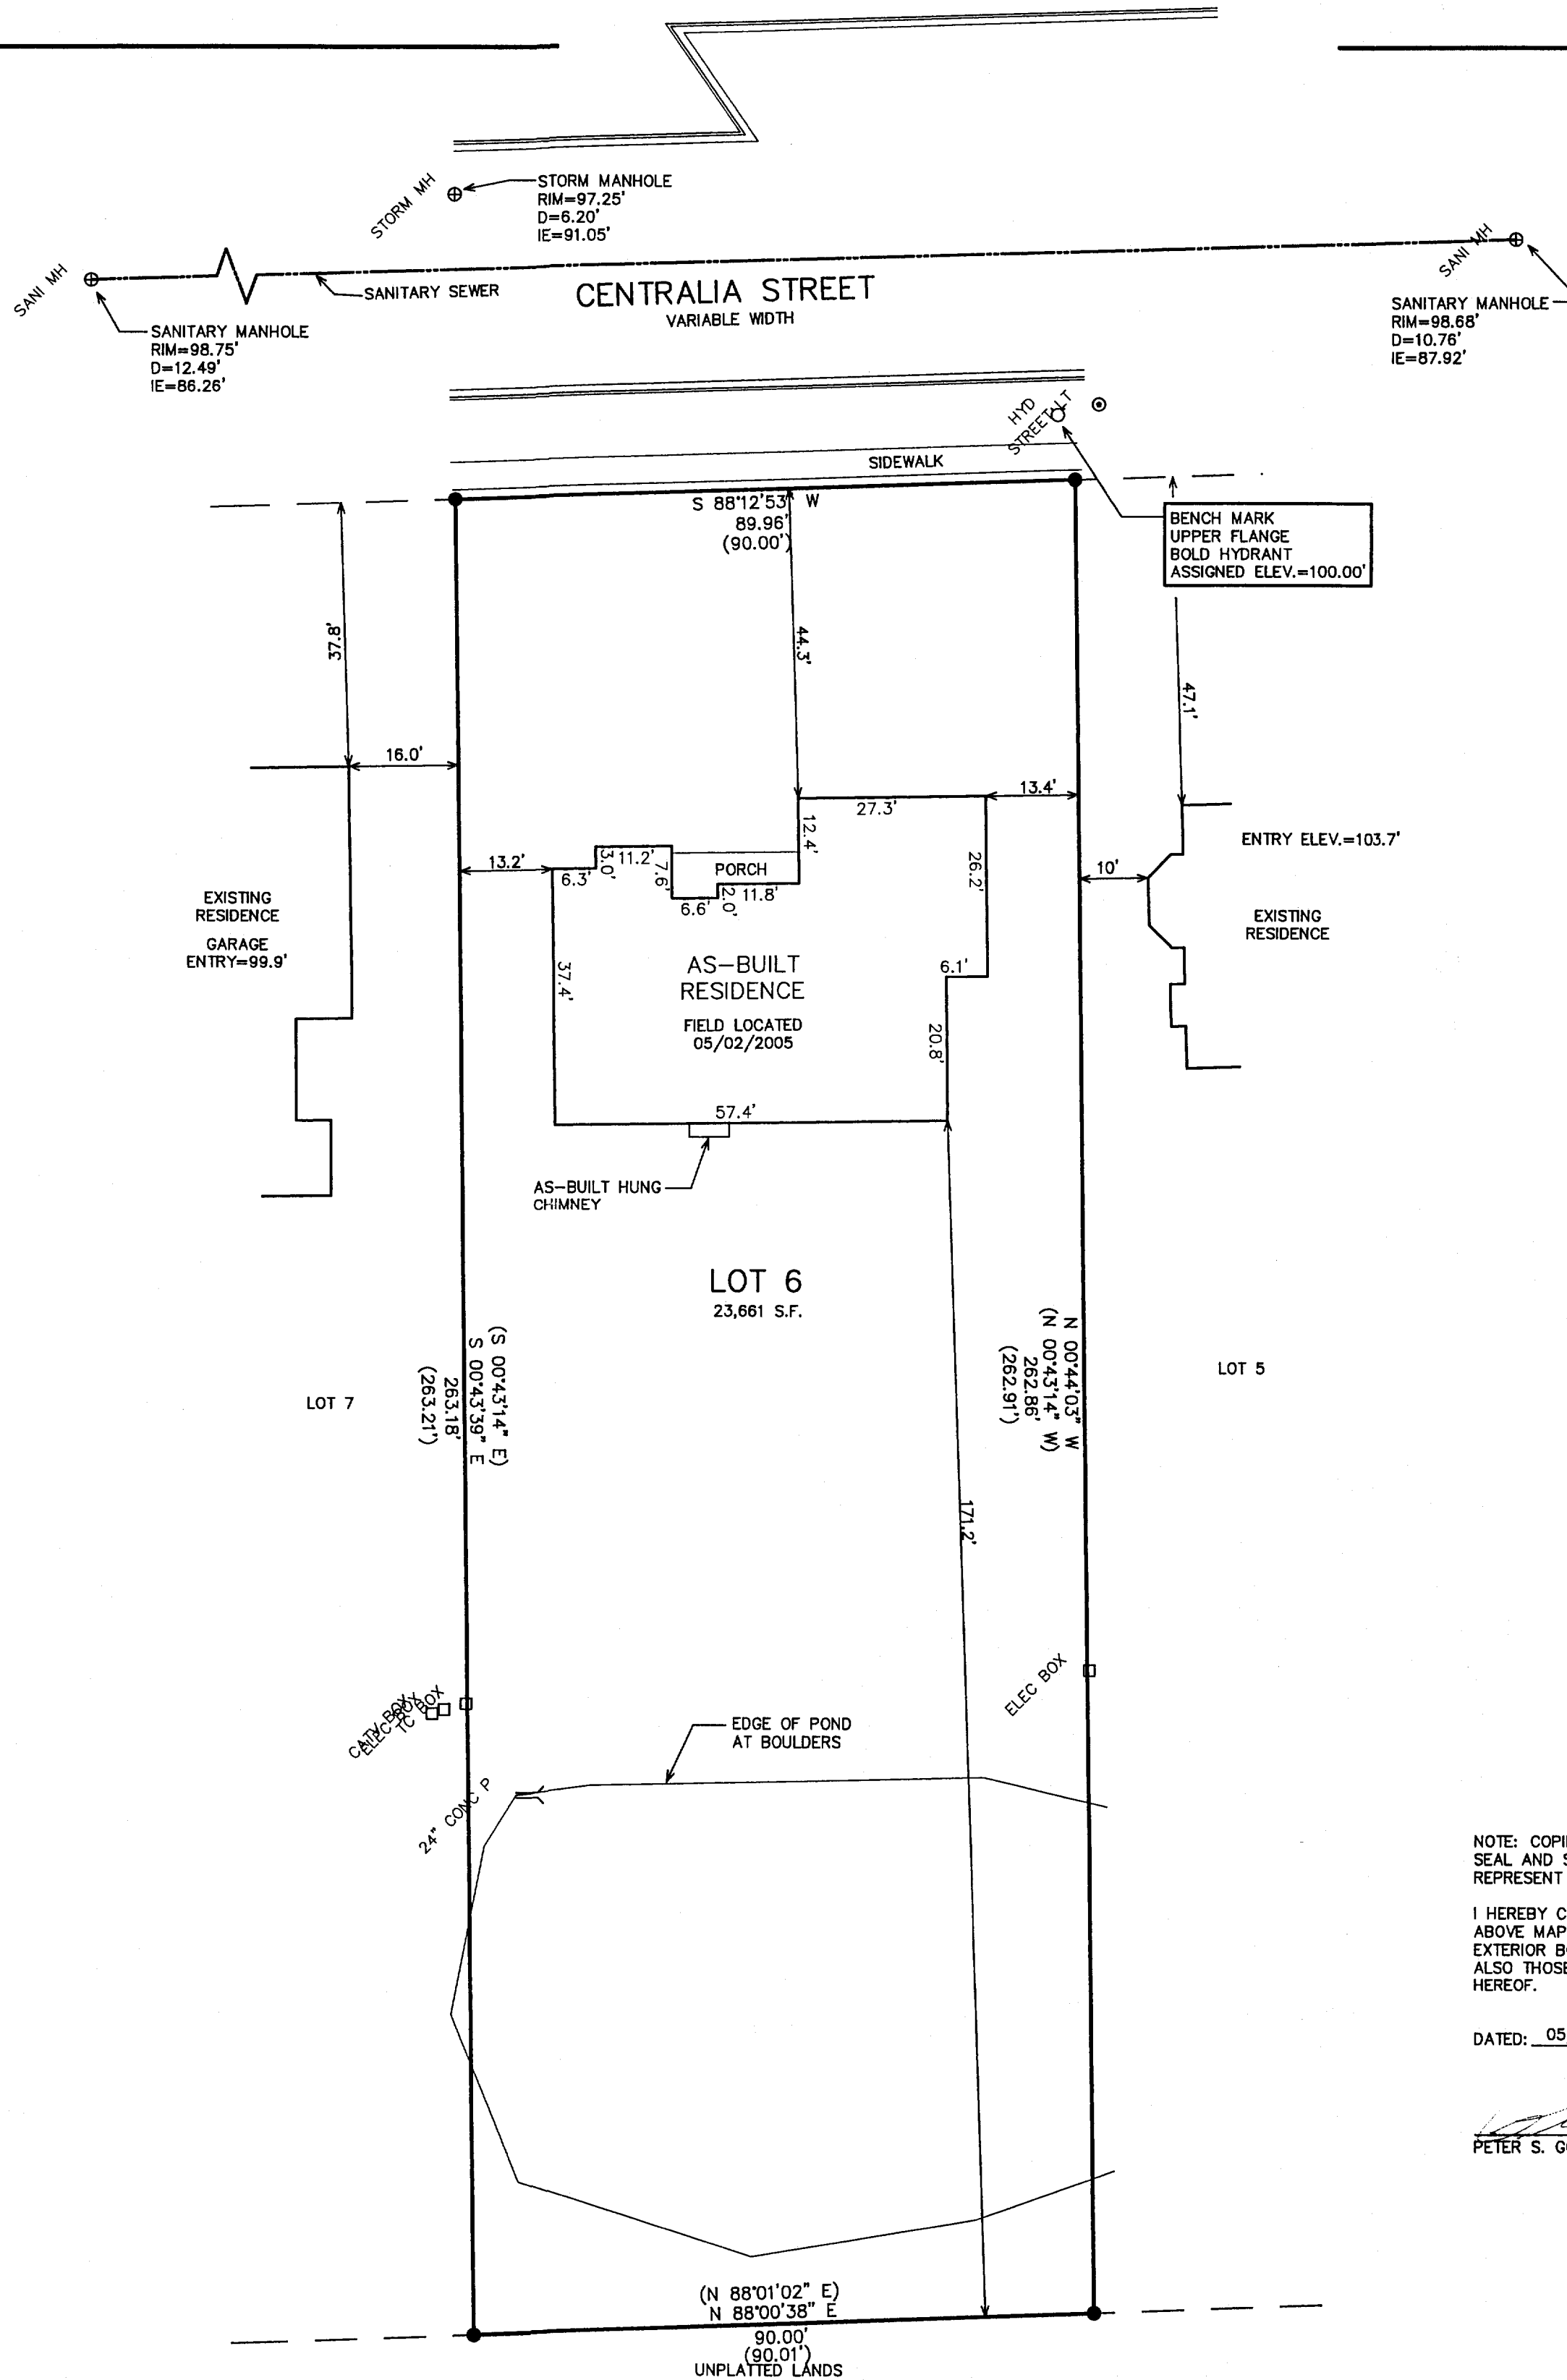

PLAT OF SURVEY
LOT 6 OF ALDER SUBDIVISION
LOCATED IN THE NW 1/4 OF SECTION 1,
TOWN 2 NORTH, RANGE 16 EAST,
CITY OF ELKHORN, WALWORTH COUNTY, WISCONSIN



- LEGEND
- = FOUND IRON REBAR STAKE
 - (XXX) = RECORDED AS
 - T.F. = TOP OF FOUNDATION GRADE
 - G.E. = GARAGE ENTRY GRADE

NOTE: COPIES OF THIS MAP TO WHICH THE FOLLOWING CERTIFICATE WILL APPLY SHOW THE SURVEYOR'S ORIGINAL SEAL AND SIGNATURE IN RED INK. COPIES BY ANY OTHER MEANS MAY HAVE ALTERATIONS WHICH DO NOT REPRESENT THE SURVEYOR'S WORK PRODUCT.


I HEREBY CERTIFY THAT THE ABOVE DESCRIBED PROPERTY HAS BEEN SURVEYED UNDER MY DIRECTION AND THAT THE ABOVE MAP IS A TRUE REPRESENTATION THEREOF AND SHOWS THE SIZE AND LOCATION OF THE PROPERTY AND ITS EXTERIOR BOUNDARIES. THIS SURVEY IS MADE FOR THE USE OF THE PRESENT OWNERS OF THE PROPERTY, AND ALSO THOSE WHO PURCHASE, MORTGAGE, OR GUARANTEE THE TITLE THERETO WITHIN ONE YEAR FROM THE DATE HEREOF.

DATED: 05/22/2003


Peter S. Gordon
PETER S. GORDON R.L.S. 2101

05/03/2005
SHOW SIZE &
LOCATION OF
AS-BUILT
RESIDENCE &
IMPROVEMENTS

MAY 23 2005

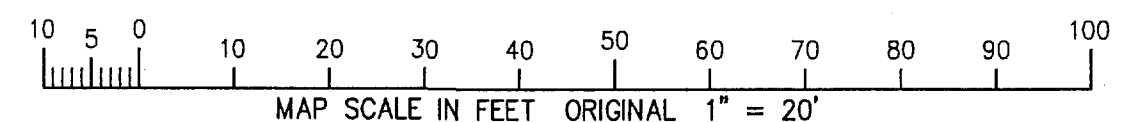

ASSIGNED SOUTH LINE OF
CENTRALIA STREET
N 88°12'53" E

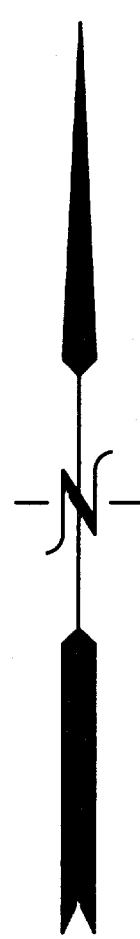

WORK ORDERED BY -
PAT MCCOLE - MARQUIS CONSTRUCTION
2827 COUNTY TRUNK "K"
FRANKSVILLE, WI 53126

FARRIS, HANSEN & ASSOCIATES, INC.
ENGINEERING - ARCHITECTURE - SURVEYING
7 RIDGWAY COURT P.O. BOX 437
ELKHORN, WISCONSIN 53121
OFFICE: (262) 723-2098 FAX: (262) 723-5886

REVISIONS
10/08/2004
SHOW SIZE &
LOCATION OF
PROPOSED
RESIDENCE
11/01/2004
SHOW SIZE &
LOCATION OF
PROPOSED
DECK

PROJECT NO.
6280
DATE:
05/22/03
SHEET NO.
1 OF 1