



PLAT OF SURVEY OF PART OF LOT 7 IN BLOCK 5 ARNOLDS ADDITION TO THE VILLAGE (NOW CITY) OF ELKHORN, WALWORTH COUNTY, WIS. DESCRIBED AS FOLLOWS: BEGIN AT THE INTERSECTION OF THE NORTH LINE OF GENEVA ST. AND THE EASTERLY LINE OF THE OLD C.M. ST. P. & R. RAILROAD, THENCE S89°13'E 165.98 FEET, THENCE N0°41'E 243.78 FEET, TO THE CENTERLINE OF THE OLD WIS. CENTRAL RAILROAD, THENCE N39°41'W, ALONG SAID CENTERLINE, 1.95 FEET, THENCE S34°40'05"W 295.44 FEET TO THE POINT OF BEGINNING.

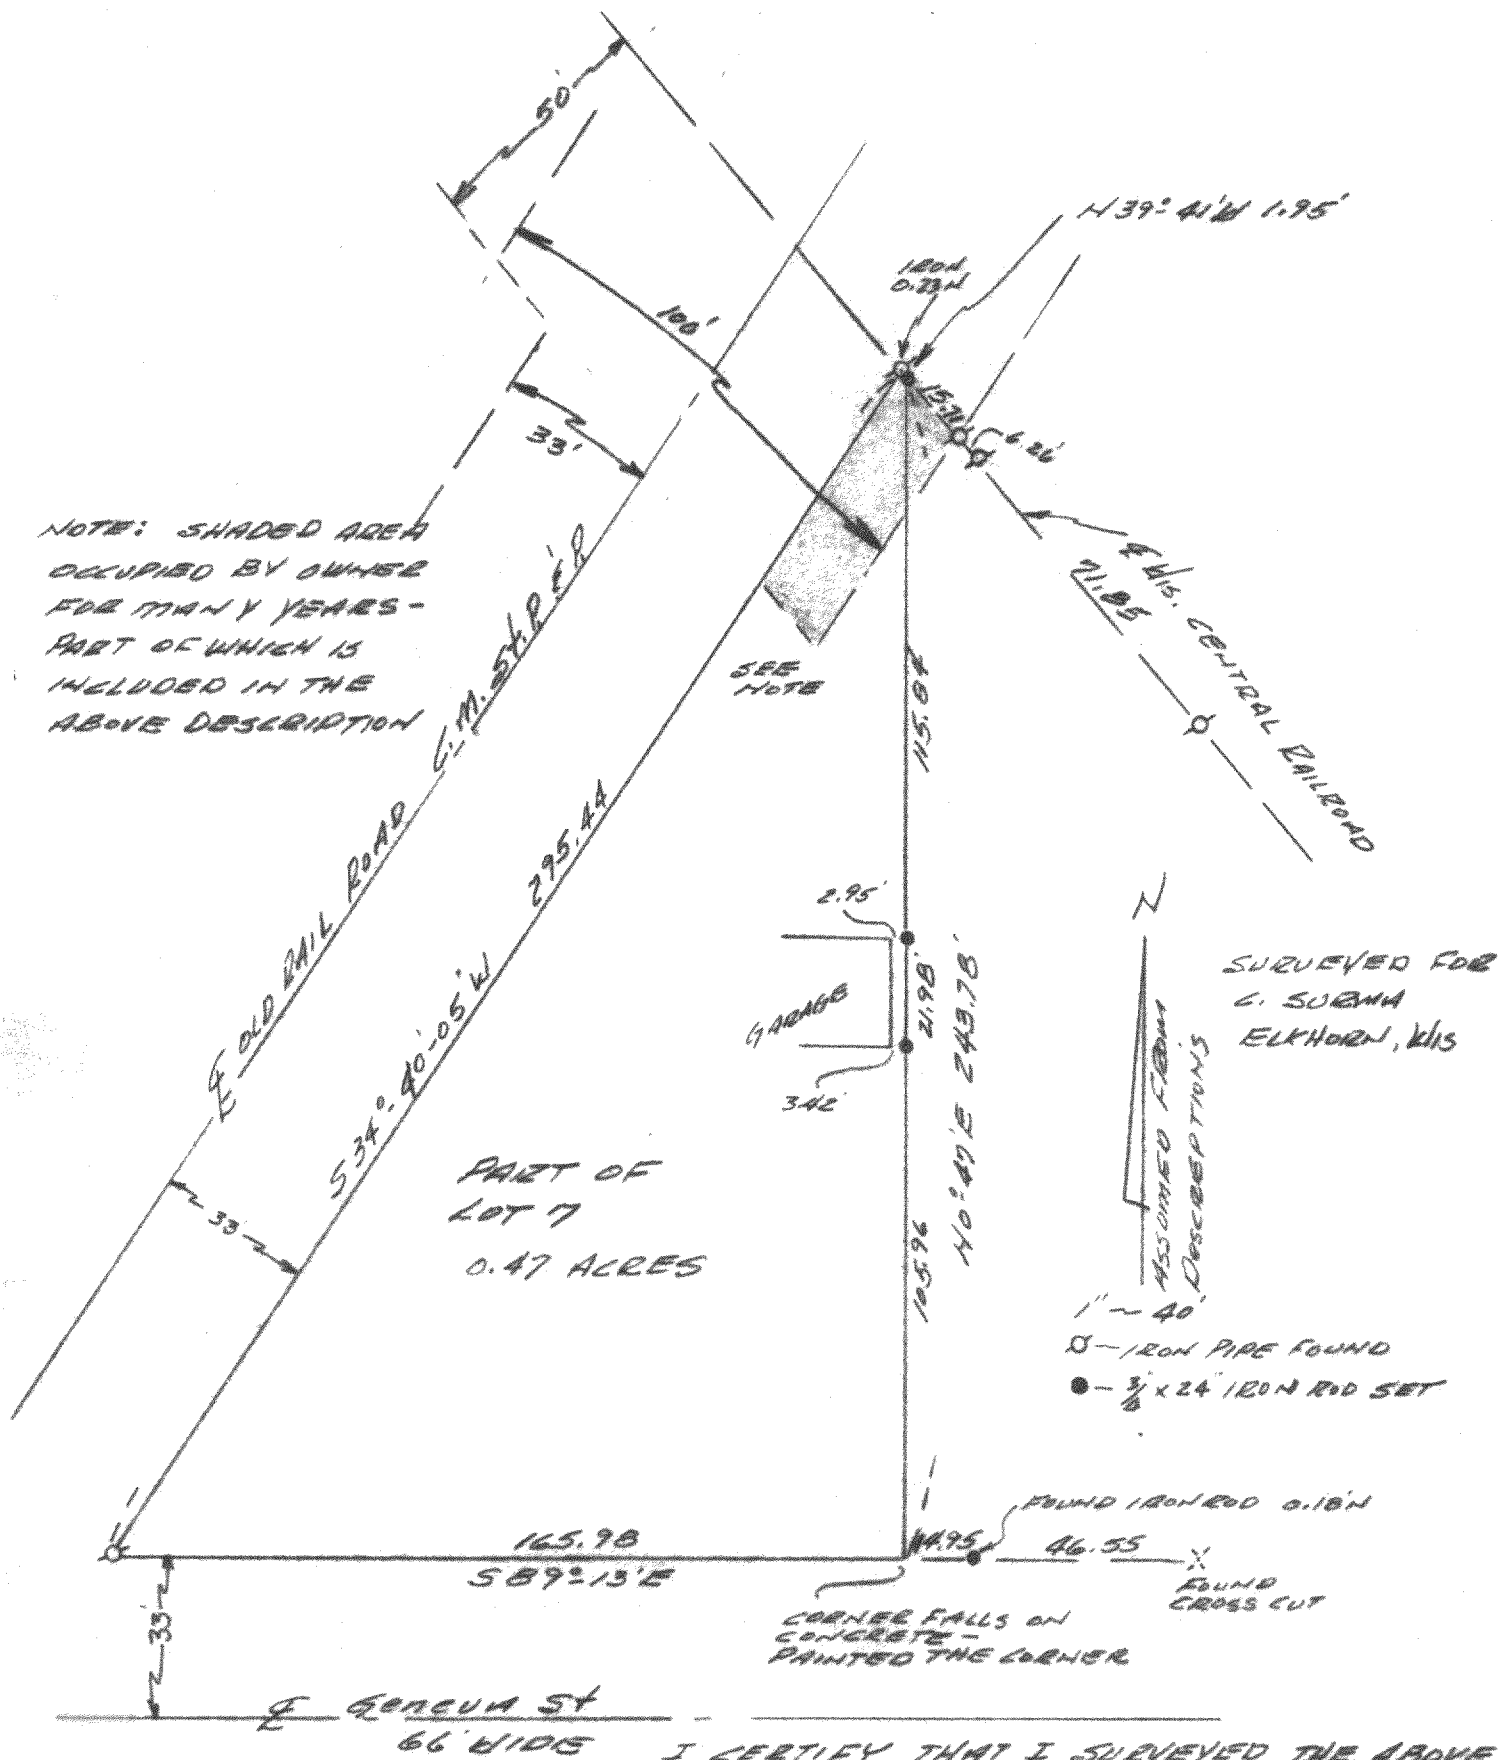

I CERTIFY THAT I SURVEYED THE ABOVE DESCRIBE PROPERTY & THAT THE PLAT SHOWN HEREON IS AN ACCURATE SURVEY & A TRUE REPRESENTATION THEREOF & CORRECTLY SHOWS BOUNDARY LINES OF SAID PROPERTY.

APRIL 10, 1977

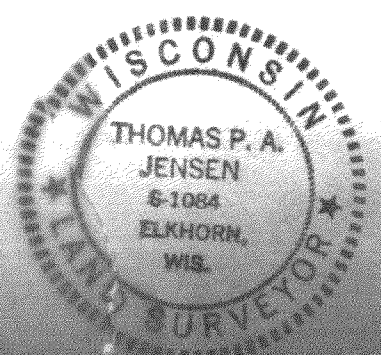

Thomas P. A. Jensen

THOMAS P. A. JENSEN R.L.S. 1084

JENSEN SURVEYING & MAPPING

ELKHORN, WISCONSIN 4-187J

YAG-33