

# PLAT OF SURVEY

**RSV**  
**ENGINEERING, INC.**


Engineers • Land Surveyors • Environmental Scientists  
801 MAIN STREET MUKWONAGO, WISCONSIN 53149 (262)363-2004

FOR: INFINITY BUILDERS

RECERTIFICATION: 04/21/2005

DATE: 12/06/2004

DESCRIPTION: BEING ALL THAT PART OF LOT 140 THE PINES SUBDIVISION,  
LOCATED IN PART OF THE NW, NE, SW, AND SE 1/4'S OF THE SW 1/4 AND  
THE SW AND NW 1/4'S OF THE SE 1/4 OF SECTION 5, TOWN 2 NORTH,  
RANGE 17 EAST, CITY OF ELKHORN, WALWORTH COUNTY, WISCONSIN.

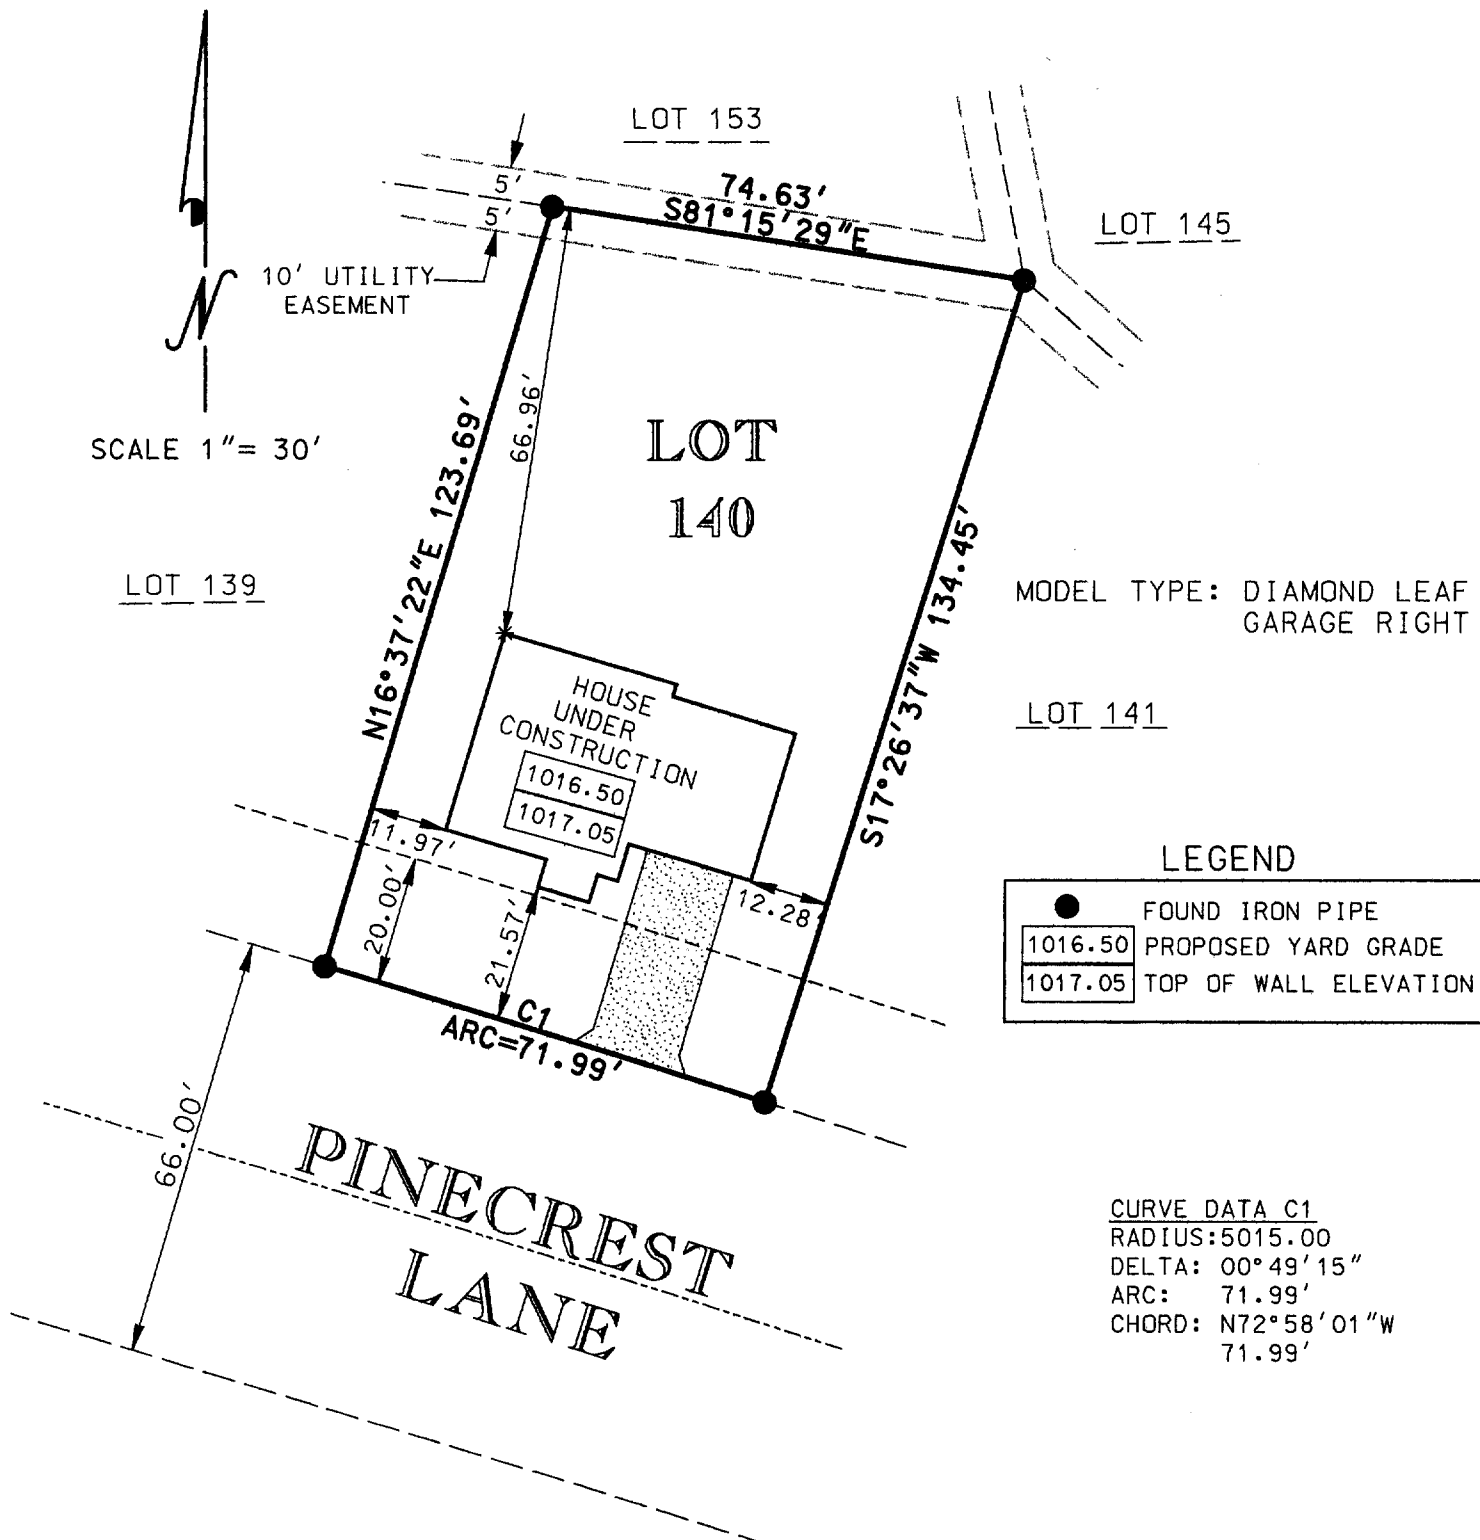

SCALE 1" = 30'

MODEL TYPE: DIAMOND LEAF  
GARAGE RIGHT

## LEGEND

|         |                       |
|---------|-----------------------|
| ●       | FOUND IRON PIPE       |
| 1016.50 | PROPOSED YARD GRADE   |
| 1017.05 | TOP OF WALL ELEVATION |

CURVE DATA C1  
RADIUS: 5015.00  
DELTA: 00° 49' 15"  
ARC: 71.99'  
CHORD: N72° 58' 01" W  
71.99'

I PAUL H. VAN HENKELUM R.L.S. # 1931 HEREBY  
CERTIFY THAT THIS SURVEY WAS MADE IN  
ACCORDANCE WITH THE MINIMUM STANDARDS FOR  
PROPERTY SURVEYS (CHAPTER A-E7) STATE OF  
WISCONSIN AND HAS BEEN PREPARED UNDER MY  
DIRECTION AND CONTROL AND IS CORRECT TO THE  
BEST OF MY KNOWLEDGE AND BELIEF.



PAUL H. VAN HENKELUM, R.L.S. # 1931  
RSV DATA 6/04 SURVEYS/J04279recrt.dgn

UPI 00140

004-1882