


WEST WALWORTH AVE

50-8

4-188B

DEVENDORF STREET

WEST GENEVA ST

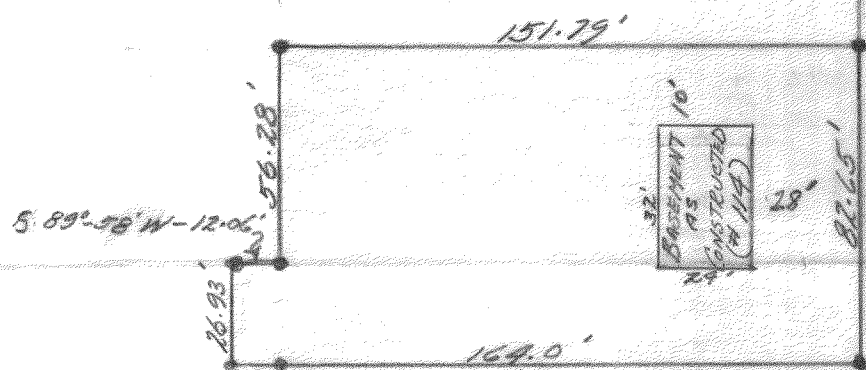

DESCRIPTION: A parcel of land located in the Northwest Quarter of Section 1, Town 2, north, Range 16 east of the 4th P.M., Walworth County, Wisconsin, described as follows: Commencing at the intersection of the south line of West Walworth Street, and the west line of Devendorf Street of the City of Elkhorn, Wisconsin, thence South along the west line of said Devendorf Street, 305.30 feet to the place of beginning; thence West at right angles to said street 151.79 feet, thence South 56.28 feet, thence South $89^{\circ} 58'$ West, 12.06 feet, thence South 26.93 feet, thence East 164.0 feet to the west line of Devendorf Street, thence North along said street 82.65 feet to the place of beginning.

CERTIFICATE: State of Wisconsin) ss
Walworth County.)

I, JOSEPH M. BIAGI, do hereby certify, that I, have made the above survey according to official records; that the survey of the lot and the information relative to the location of the building on the lot, all as shown on the above survey, is true and correct as indicated and marked on the above map.

SIGNED AND SEALED ON THIS THE 17TH DAY OF JULY 1950.

Joseph M. Biagi, Professional Engineer
Elkhorn Wisconsin.

U-SW-37E

4-188B

4-188B