


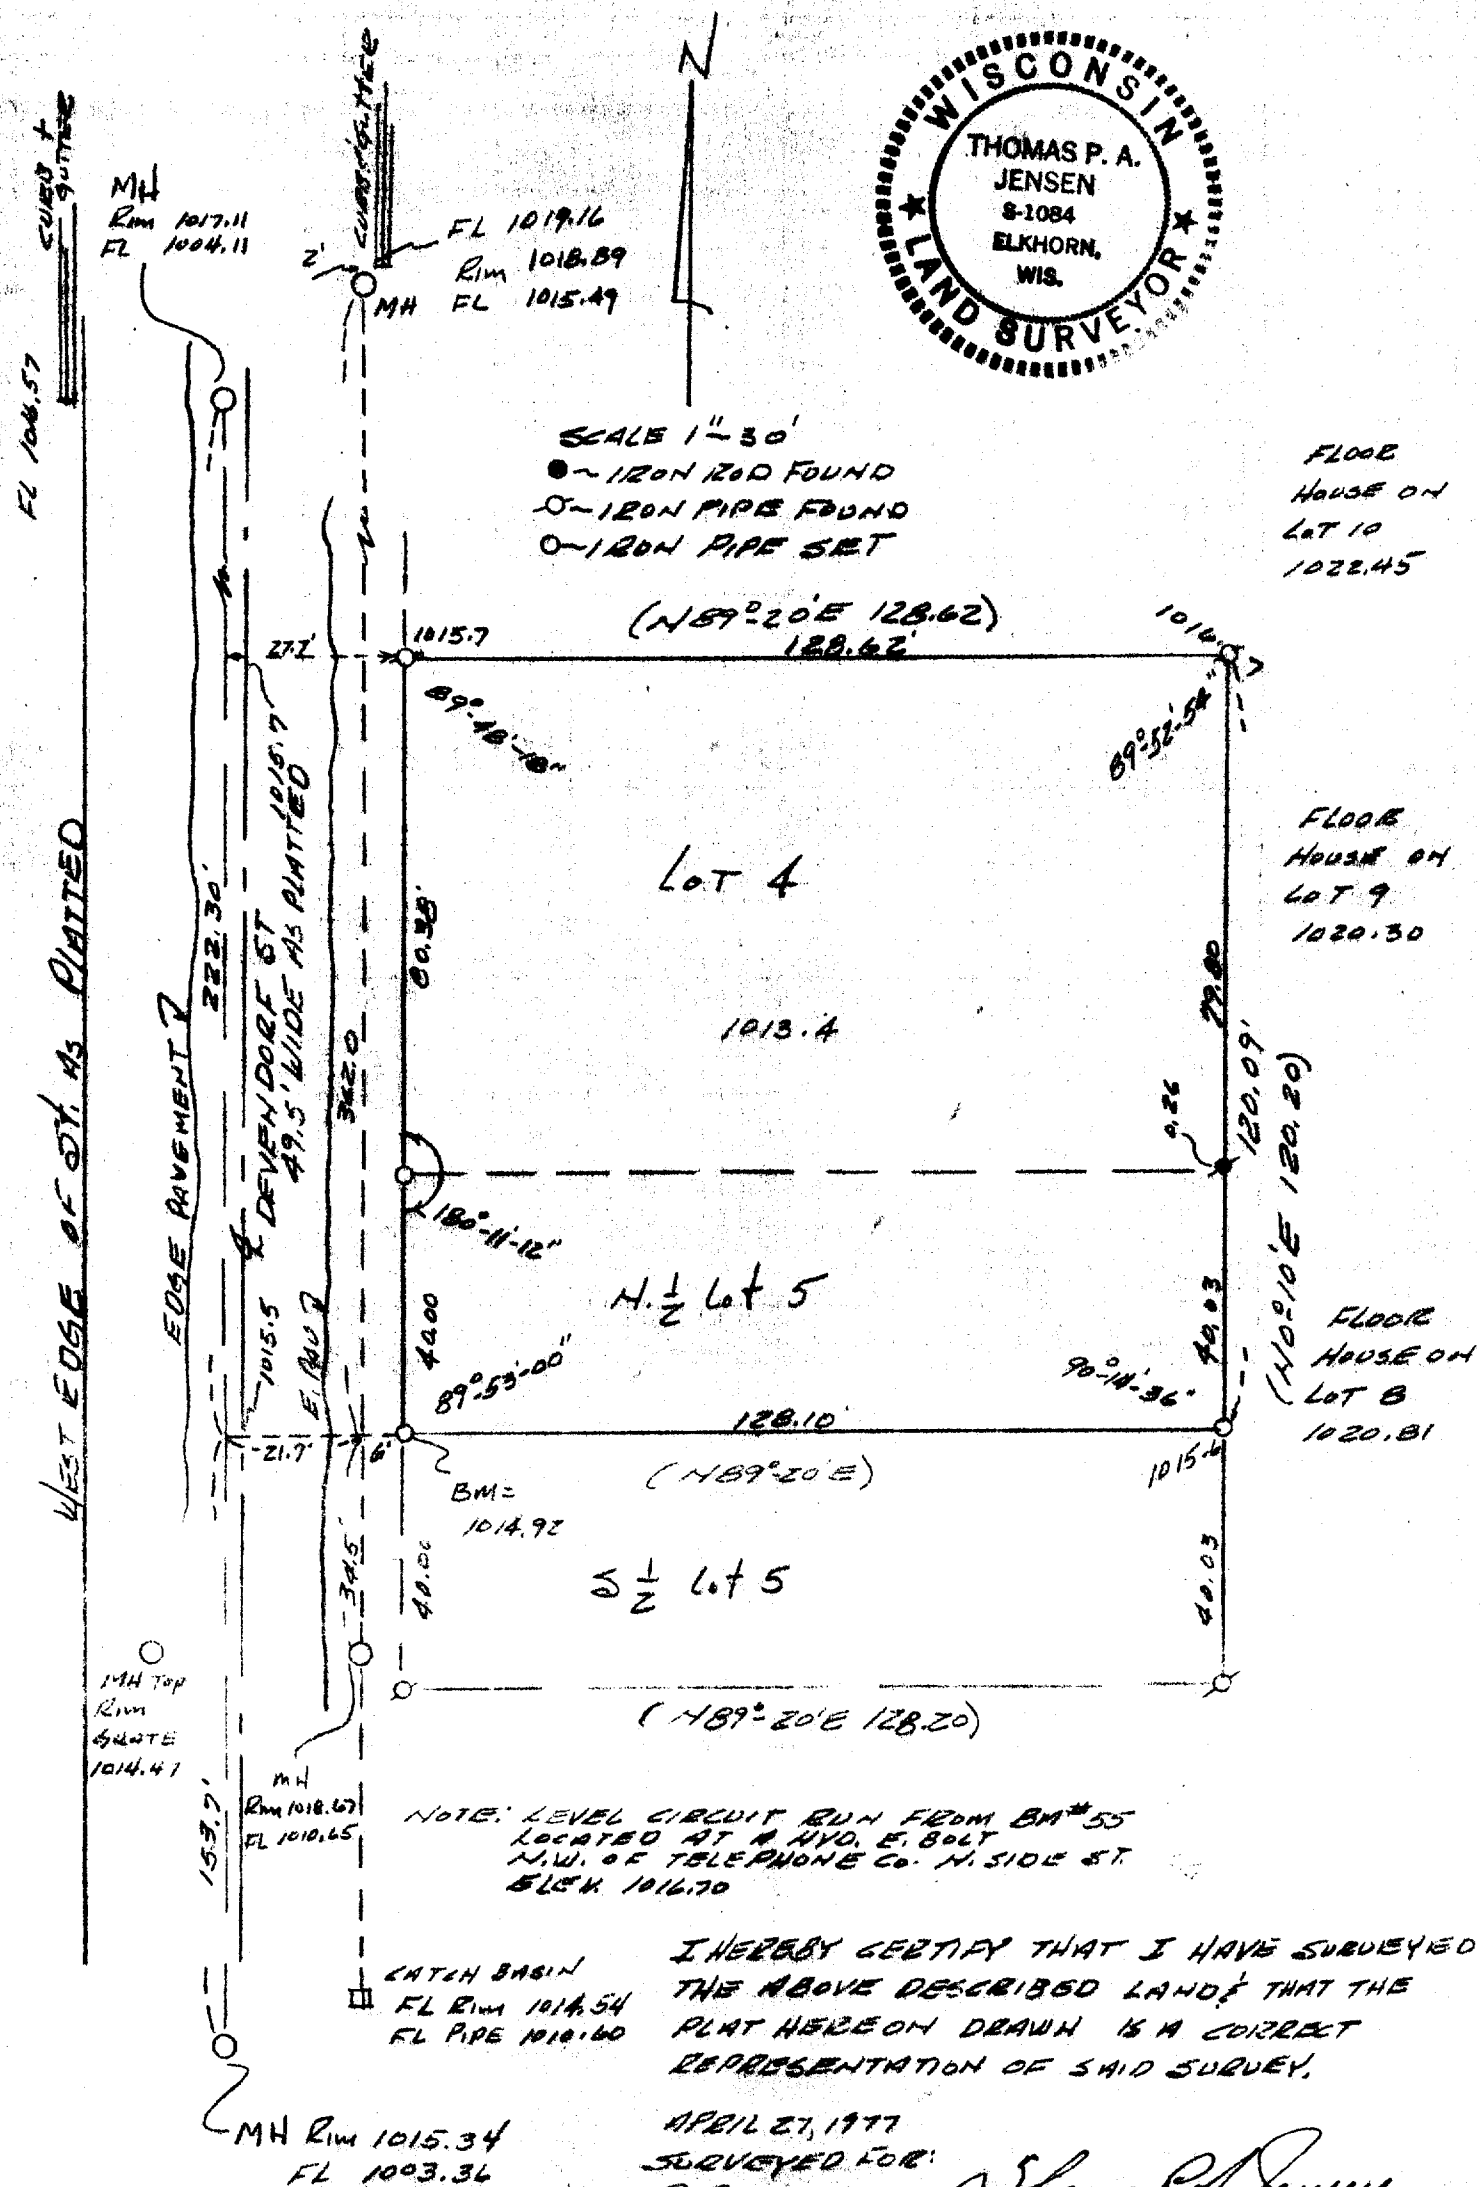

Job # A77.015

Thomas P.A. Jensen
JENSEN SURVEYING & MAPPING
ELK, WIS

4-189

YJA2.53