


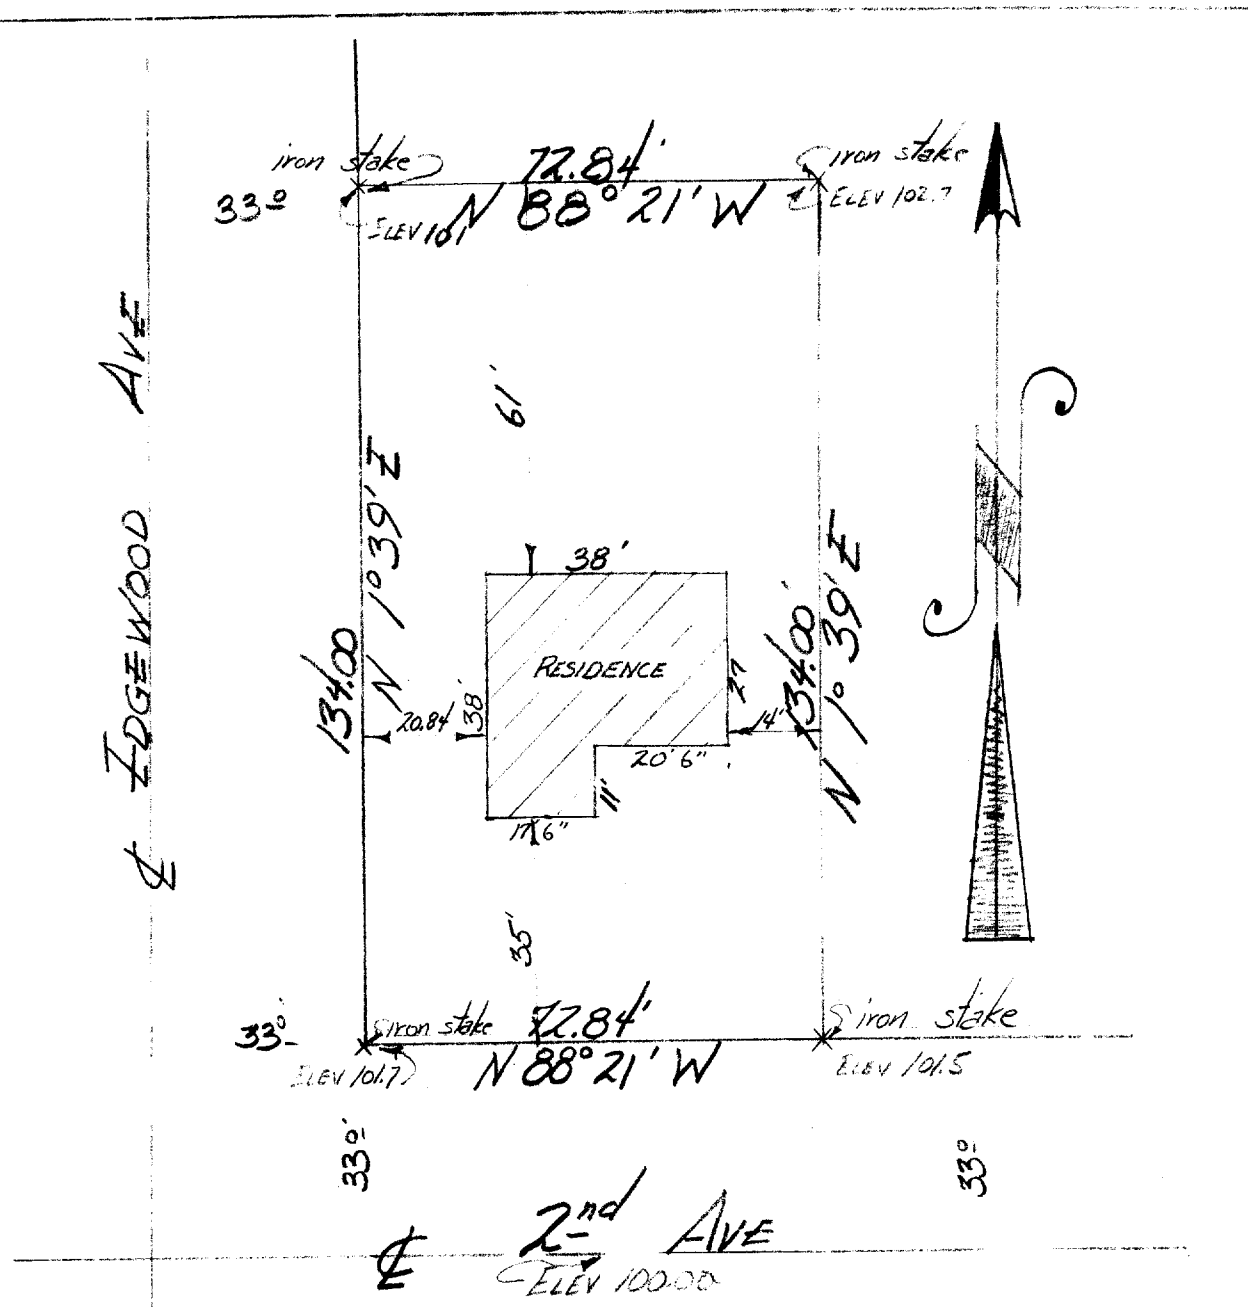

DESCRIPTION: Lot 1 of Block 2 of Edgewood Addition to the City of Elkhorn, Walworth County, Wisconsin.

CERTIFICATE: I, James F. Biagi, Surveyor Do hereby certify that I have surveyed and staked the above described property, and that the measurements and bearings on the boundary lines are in accordance with the official records on file in the Register of Deeds Office, Walworth, County, Wisconsin.

SIGNED AND SEALED 14 APRIL, 1959

James F. Biagi
James F. Biagi (272)

Re-certified, that as of this day July 22nd, 1959., buildings are located on the above described property as indicated hereon.

James F. Biagi
James F. Biagi, Surveyor.