

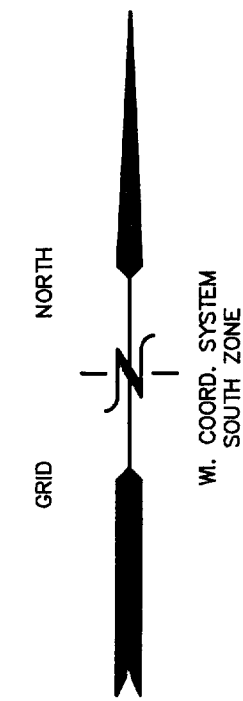
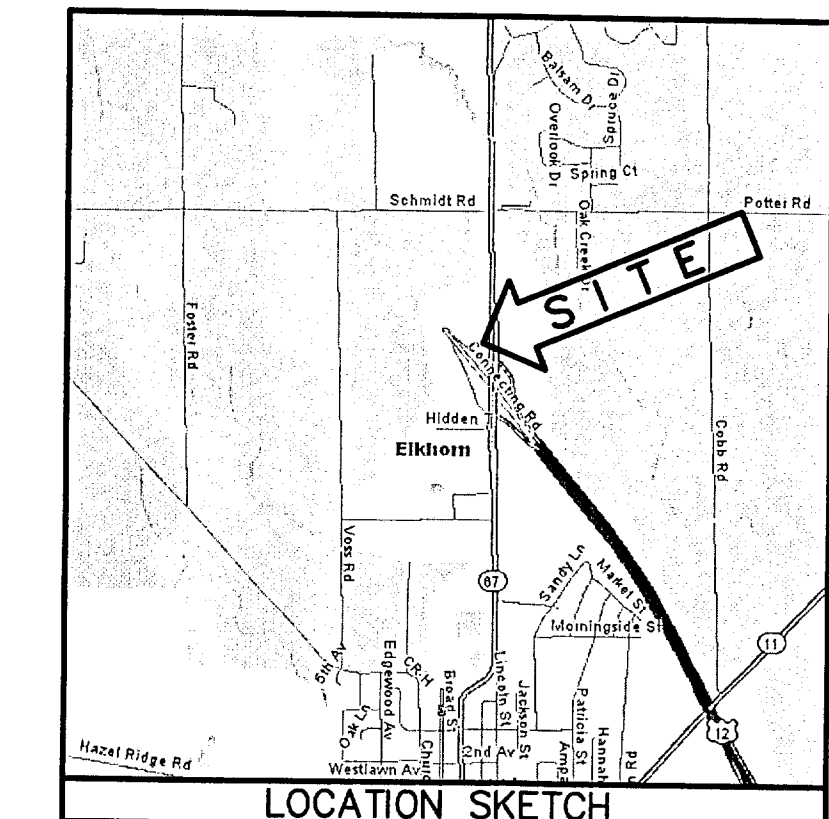


PLAT OF SURVEY
AS-BUILT MAPPING
LOT 4 OF CERTIFIED SURVEY MAP NO. 2247 LESS
THE NORTHERLY 33' OF SAID LOT 4
CITY OF ELKHORN, WALWORTH COUNTY, WISCONSIN

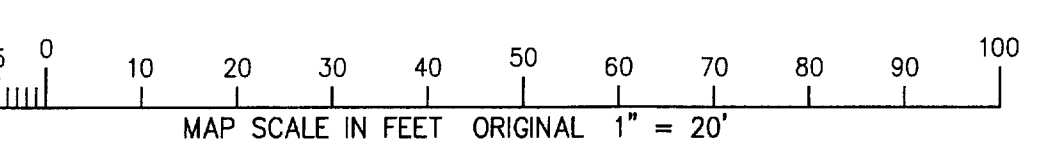

WM. CONDO. SYSTEM
SOUTH ZONE

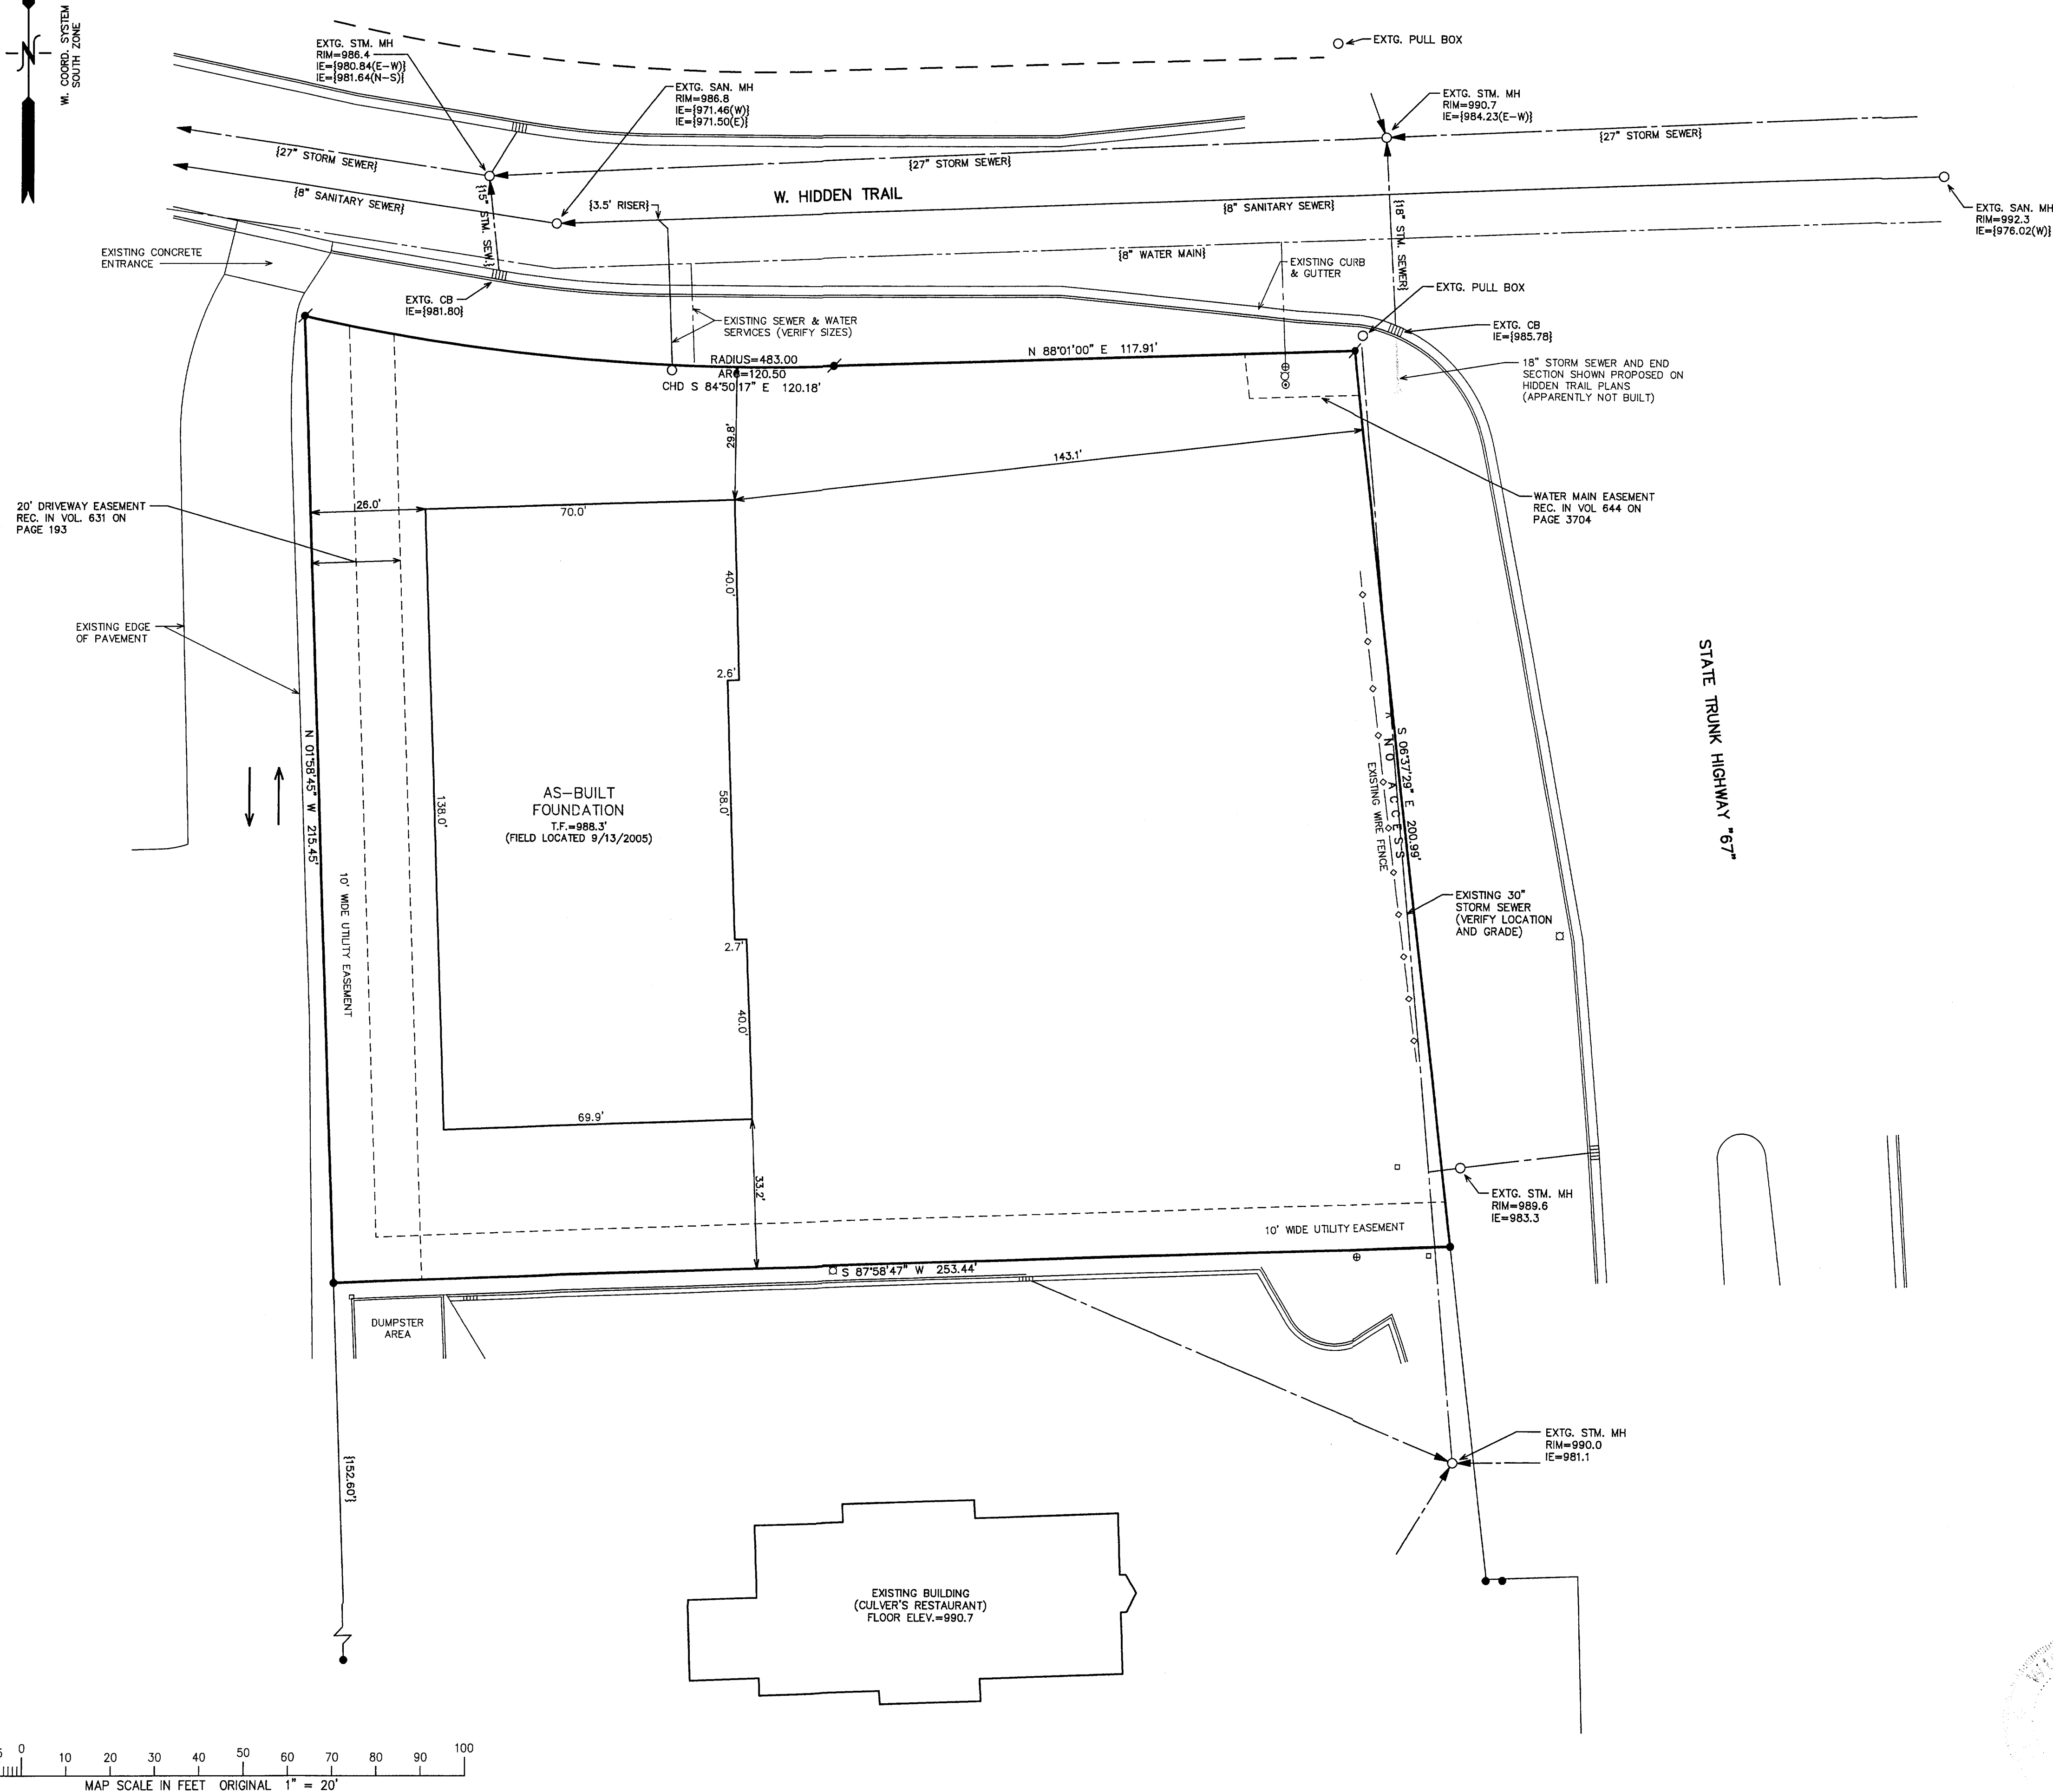


- LEGEND
- = SET IRON REBAR STAKE
 - = FOUND IRON REBAR STAKE
 - = MANHOLE LOCATED
 - = HYDRANT LOCATED
 - ⊕ = VALVE LOCATED
 - ⊙ = GAS WARNING POST LOCATED
 - = LIGHT POLE LOCATED
 - = UTILITY CONTROL BOX LOCATED
 - {XXX} = RECORDED AS

NOTE: COPIES OF THIS MAP TO WHICH THE FOLLOWING CERTIFICATE
WILL APPLY SHOW THE SURVEYOR'S ORIGINAL SEAL AND SIGNATURE
IN RED INK. COPIES BY ANY OTHER MEANS MAY HAVE ALTERATIONS
WHICH DO NOT REPRESENT THE SURVEYOR'S WORK PRODUCT.

I HEREBY CERTIFY THAT THE ABOVE DESCRIBED PROPERTY HAS BEEN
SURVEYED UNDER MY DIRECTION AND THAT THE ABOVE MAP IS A TRUE
REPRESENTATION THEREOF AND SHOWS THE SIZE AND LOCATION OF
THE PROPERTY AND ITS EXTERIOR BOUNDARIES. THIS SURVEY IS
MADE FOR THE USE OF THE PRESENT OWNERS OF THE PROPERTY, AND
ALSO THOSE WHO PURCHASE, MORTGAGE, OR GUARANTEE THE TITLE
THERE TO WITHIN ONE YEAR FROM THE DATE HEREOF.

DATED: OCTOBER 7, 2005

Peter S. Gordon
PETER S. GORDON R.L.S. 2101

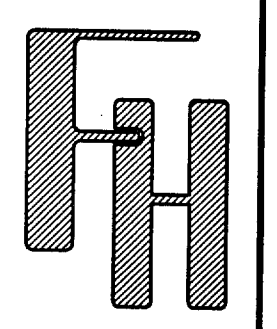

PLAT OF SURVEY
AS-BUILT MAPPING

CITY OF ELKHORN, WALWORTH COUNTY, WISCONSIN

LAND-OWNER -
STEVE MILLS
BEAR REALTY, INC.
4011 - 80th STREET
KENOSHA, WI. 53142

FARRIS, HANSEN & ASSOCIATES, INC.
ENGINEERING - ARCHITECTURE - SURVEYING
7 RIDGWAY COURT P.O. BOX 437
ELKHORN, WISCONSIN 53121
OFFICE: (262) 723-2088 FAX: (262) 723-5886

REVISIONS

PROJECT NO.
5916.03
DATE
10/07/05
SHEET NO.
1 of 1

Friday, October 07, 2005 9:11 AM
X:\Projects\9916\DOAD\ASBUILT.dwg

YA2247-4

004-1948