


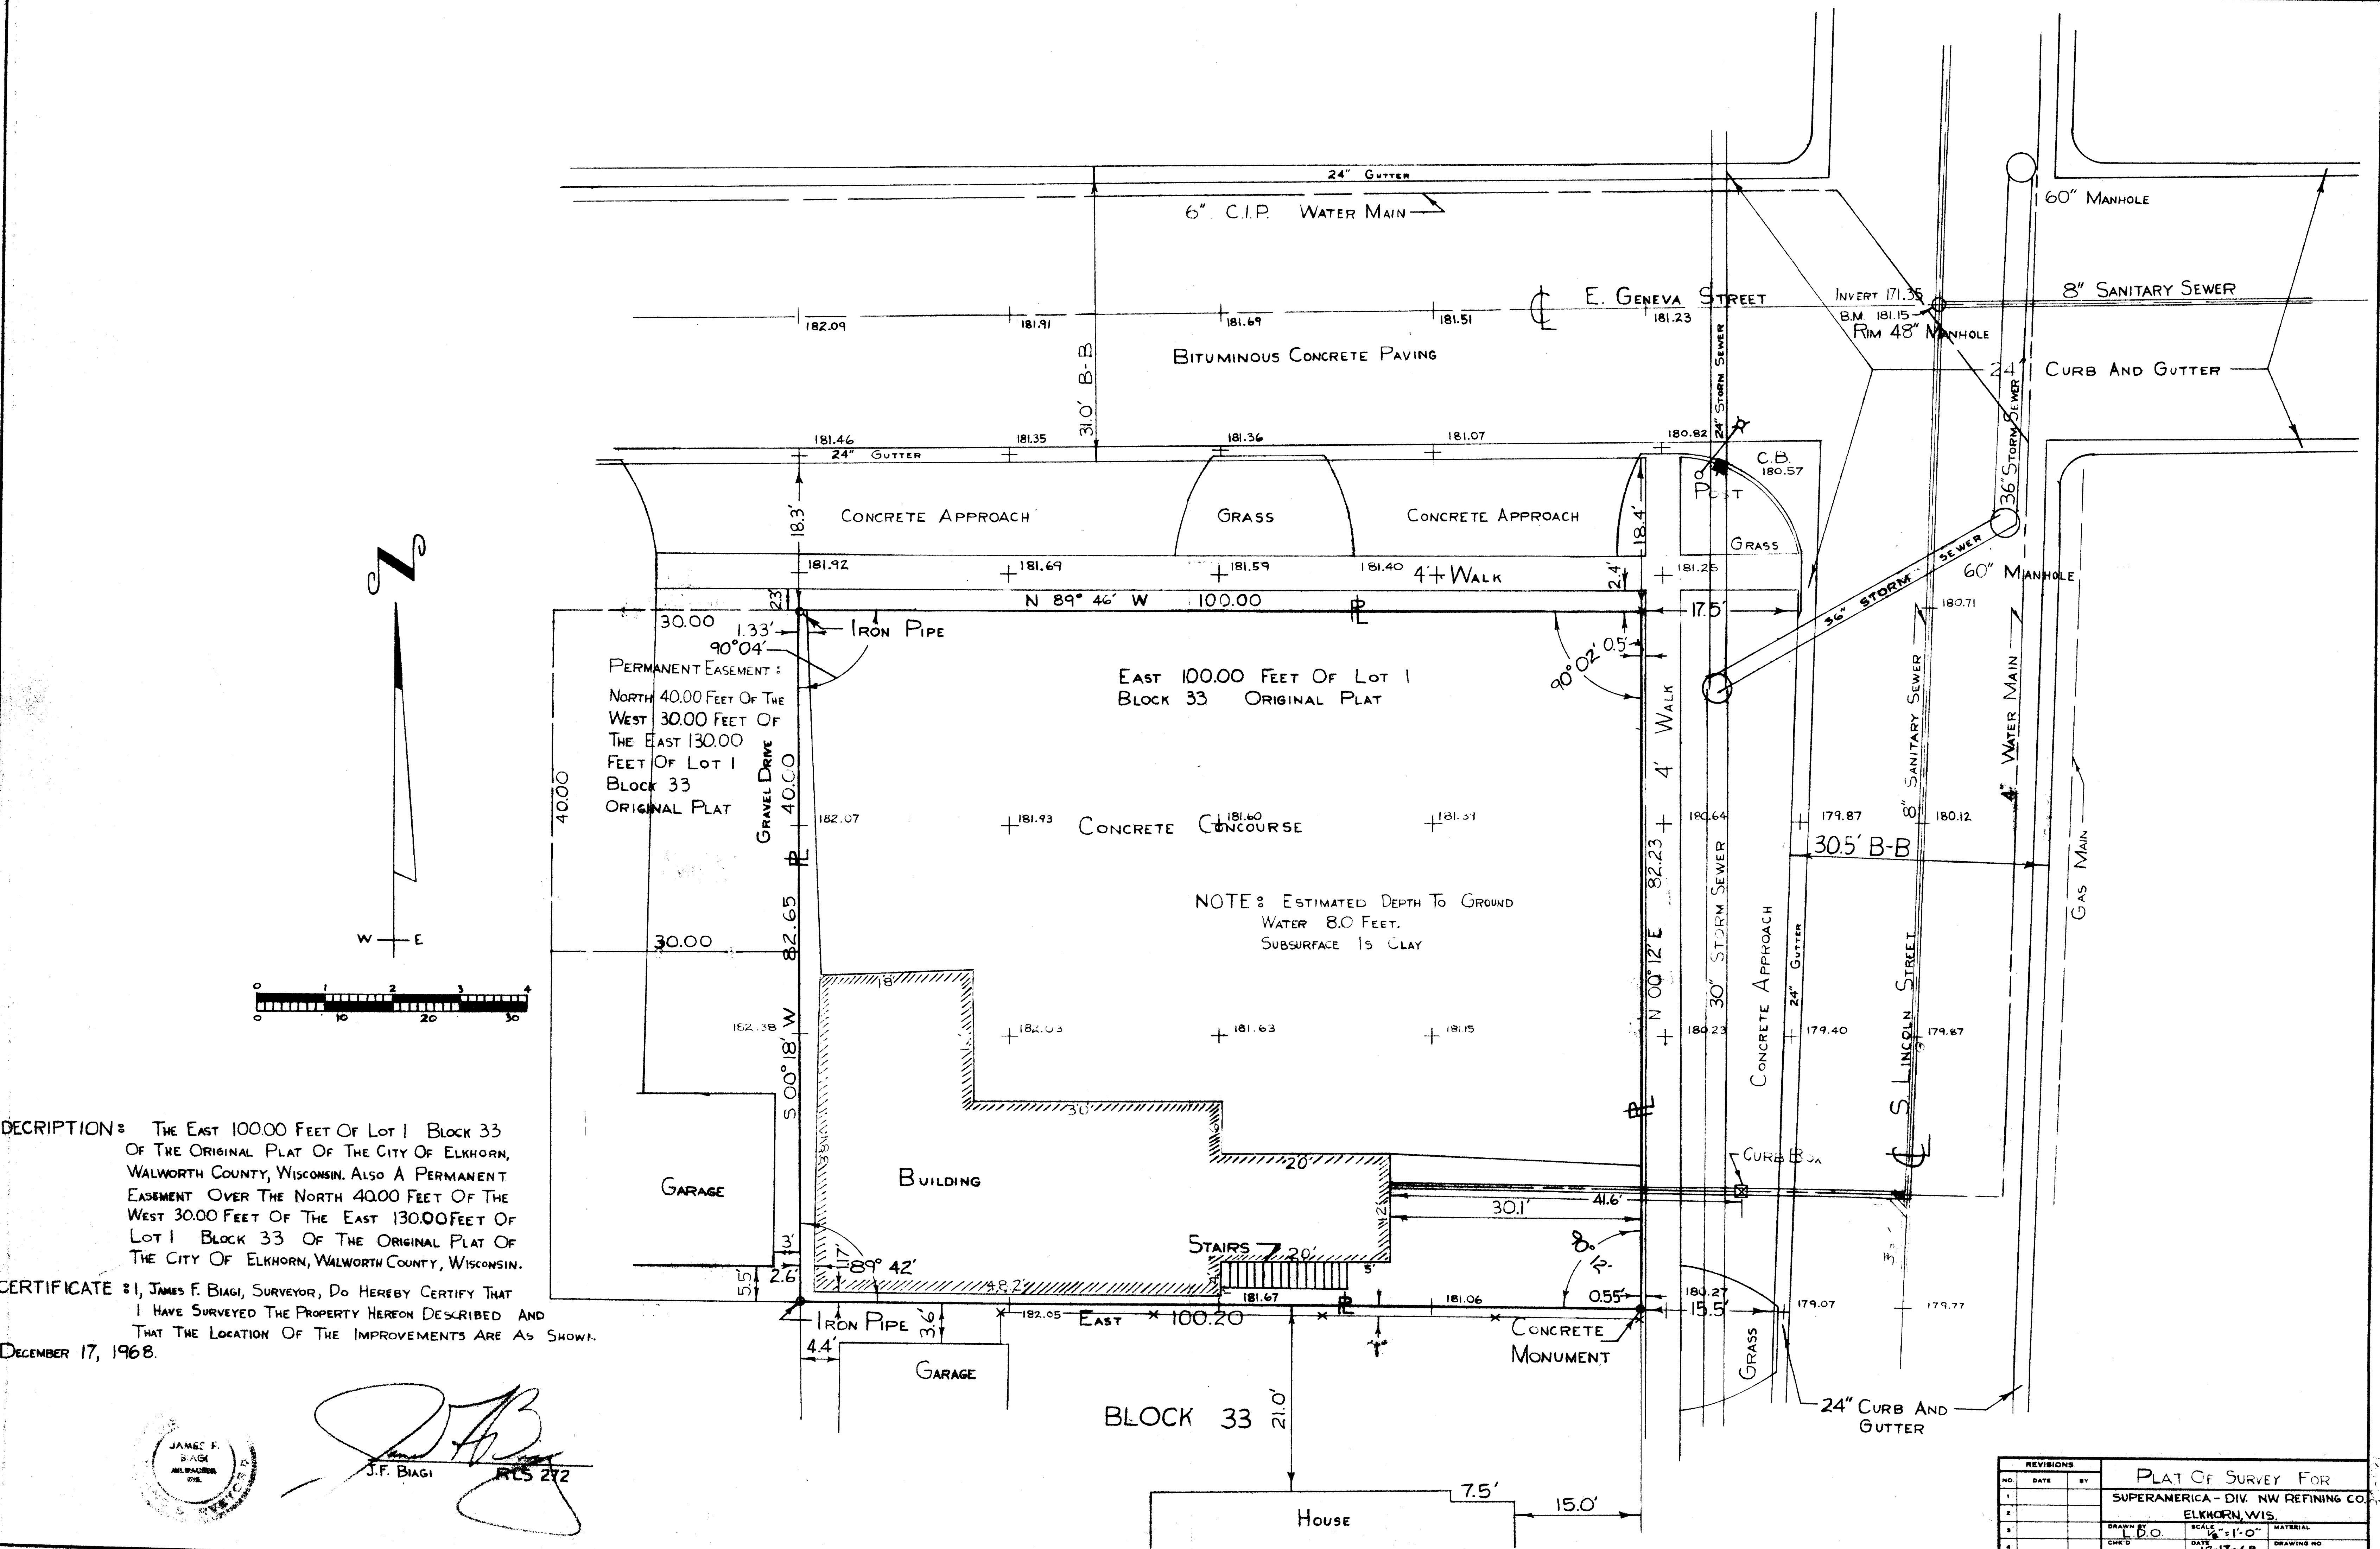

DESCRIPTION: THE EAST 100.00 FEET OF LOT 1 BLOCK 33 OF THE ORIGINAL PLAT OF THE CITY OF ELKHORN, WALWORTH COUNTY, WISCONSIN. ALSO A PERMANENT EASEMENT OVER THE NORTH 40.00 FEET OF THE WEST 30.00 FEET OF THE EAST 130.00 FEET OF LOT 1 BLOCK 33 OF THE ORIGINAL PLAT OF THE CITY OF ELKHORN, WALWORTH COUNTY, WISCONSIN.

CERTIFICATE: I, JAMES F. BIAGI, SURVEYOR, DO HEREBY CERTIFY THAT I HAVE SURVEYED THE PROPERTY HEREON DESCRIBED AND THAT THE LOCATION OF THE IMPROVEMENTS ARE AS SHOWN.

DECEMBER 17, 1968.



[Signature]
J.F. BIAGI
SLS 272

REVISIONS			PLAT OF SURVEY FOR	
NO.	DATE	BY	SUPERAMERICA - DIV. NW REFINING CO.	
1			ELKHORN, WIS.	
2			DRAWN BY L.D.O.	
3			SCALE 1/2" = 1'-0"	
4			DATE 12-17-68	
5			DRAWING NO. 4-196	