


PLAT OF SURVEY

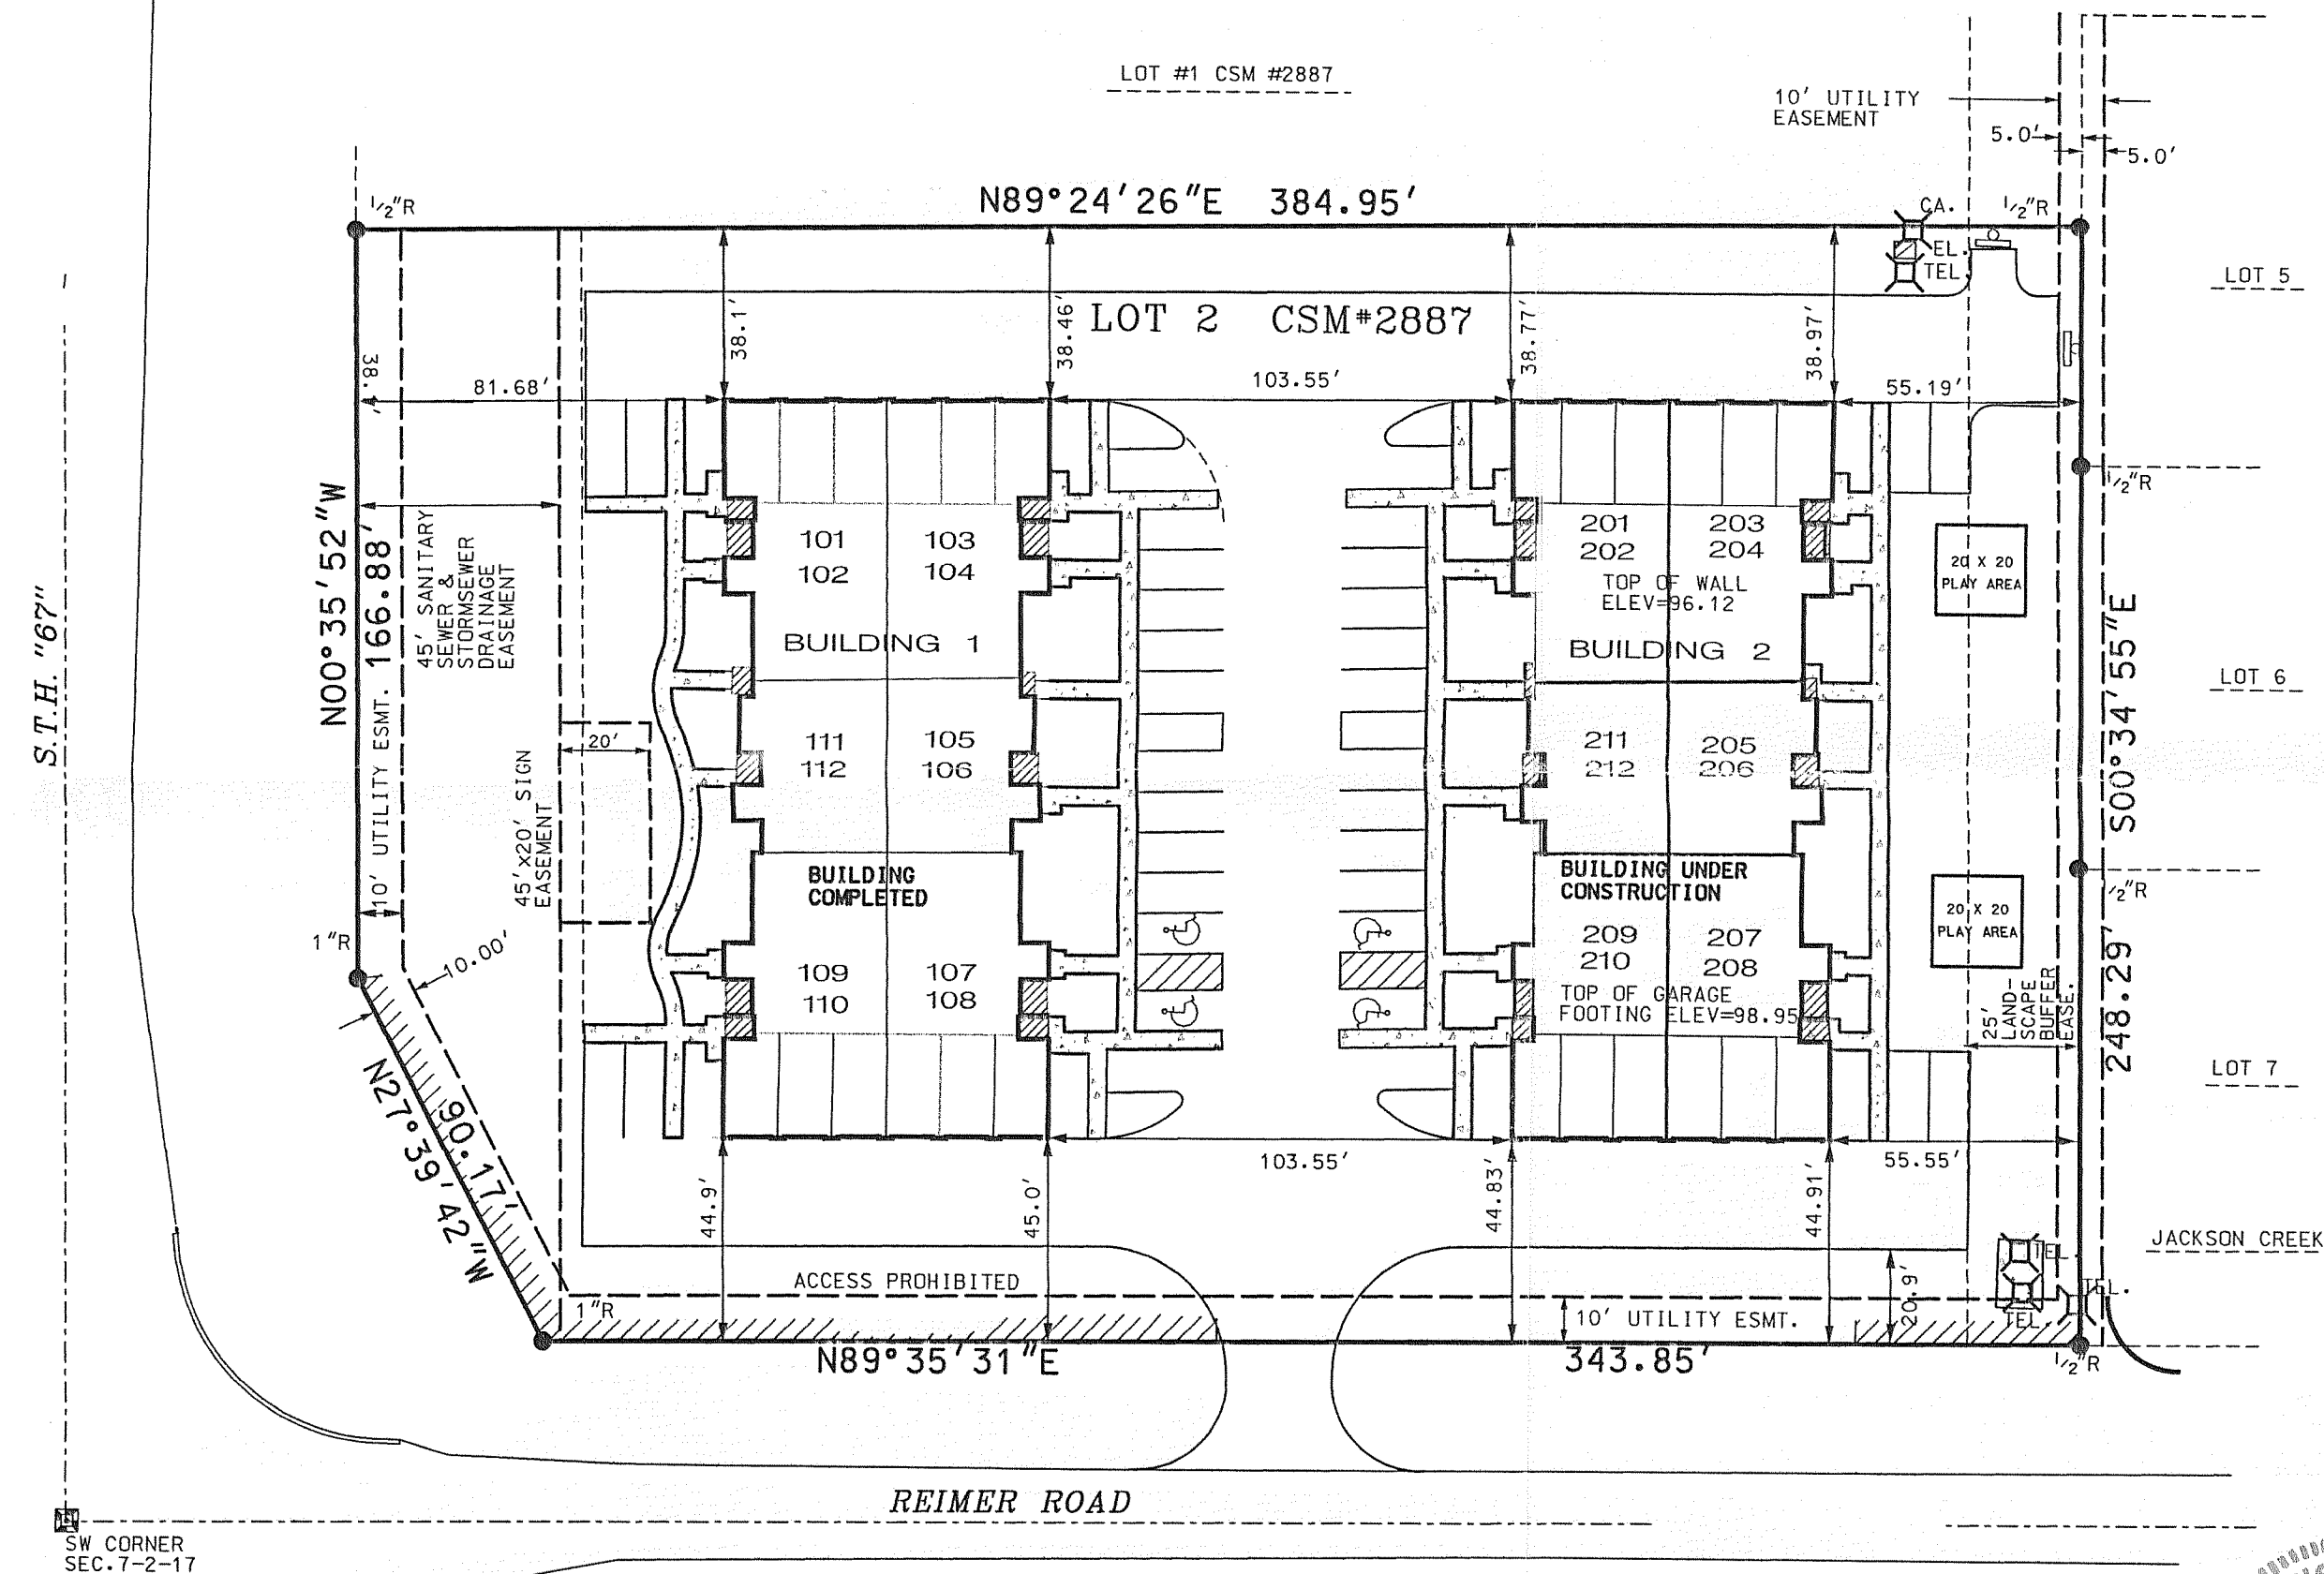

LEGEND	
$\frac{1}{2}$ "R	FOUND IRON ROD
1"R	
CA TEL	CABLE & TELEPHONE PEDISTAL
$\diamond$	POWER POLE
EL	ELECTRICAL PEDISTAL
WM	PROPOSED WATER METER
EM	PROPOSED ELECTRIC AND GAS METER

RECERTIFICATION DATE: 02/14/2005

PLAT OF SURVEY

FOR: SCOTT SIMON GROUP
DATE: 11/02/2004
PROJECT NO. 03182



Scale 1" = 40'

LEGAL DESCRIPTION:

LOT 2 OF C.S.M. NO. 2887, BEING A DIVISION OF OUTLOT 1 OF JACKSON CREEK SUBDIVISION LOCATED IN THE SW $\frac{1}{4}$ OF THE SW $\frac{1}{4}$ OF SECTION 7, TOWN 2 NORTH, RANGE 17 EAST, CITY OF ELKHORN, WALWORTH COUNTY, WISCONSIN.



I PAUL H. VAN HENKELUM R.L.S. # 1931 HEREBY CERTIFY THAT THIS SURVEY WAS MADE IN ACCORDANCE WITH THE MINIMUM STANDARDS FOR PROPERTY SURVEYS (CHAPTER A-E7) STATE OF WISCONSIN AND HAS BEEN PREPARED UNDER MY DIRECTION AND CONTROL AND IS CORRECT TO THE BEST OF MY KNOWLEDGE AND BELIEF.

Paul H. Van Henkelum
PAUL H. VAN HENKELUM, R.L.S. # 1931

NO.	REVISIONS	BY	DATE

RSV
ENGINEERING, INC.

Engineers Land Surveyors Environmental Scientists
801 MAIN STREET MUKWONAGO, WISCONSIN 53149 (262) 363-2004

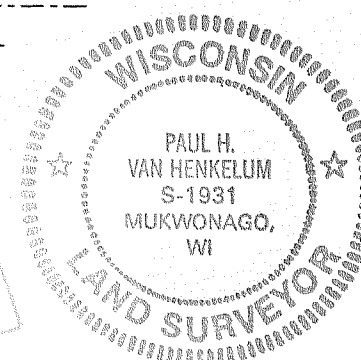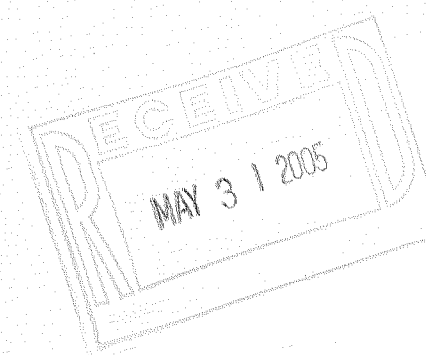

YJCVI-106 YJCVI-201 YJCVI-202 YJCVI-203 YJCVI-205
YJCVI-101 YJCVI-102 YJCVI-104 YJCVI-204 YJCVI-206
YJCVI-103 YJCVI-105

004-1980