


ABELL
SURVEYING & MAPPING

1140 SEQUOIA STREET • DELAVAN, WISCONSIN 53115
262-728-6737

LIMITED BUILDING AND MAINTENANCE
EASEMENT INCLUDING RIGHT OF INGRESS
AND EGRESS OVER THE SOUTH 15.1 FEET
OF LOT 8, STOPPING 5 FEET WEST OF THE
EXISTING HOUSE DWELLING ON LOT 9,
RECORDED IN DOCUMENT NO. 647892.

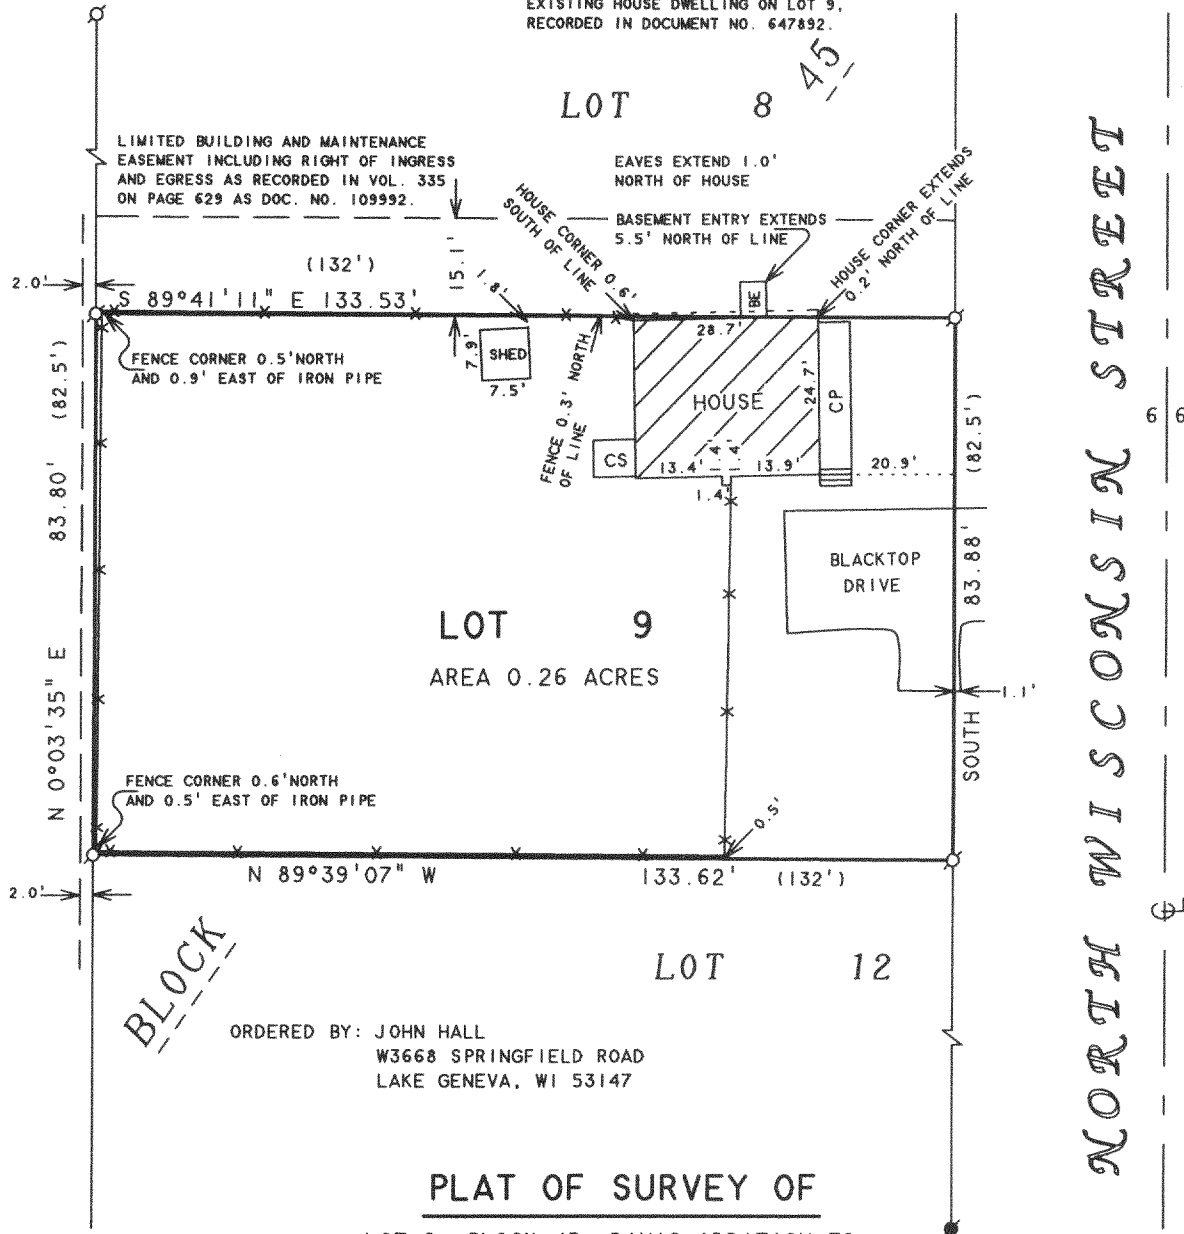

NOTE: BEARINGS ARE REFERENCED TO
EXISTING SURVEY RECORDS.

LOT 9, BLOCK 45, DAVIS ADDITION TO
THE CITY OF ELKHORN, WALWORTH COUNTY,
WISCONSIN.

REVISED AND RECERTIFIED: JANUARY 4, 2006 AND JANUARY 10, 2006

ORDERED BY: SHOREWEST REALTORS
830 E. GENEVA STREET
DELAVAN, WI 53115

I HEREBY CERTIFY THAT I HAVE SURVEYED THE ABOVE DESCRIBED PROPERTY AND THAT THE
ABOVE MAP IS A TRUE REPRESENTATION THEREOF AND SHOWS THE SIZE AND LOCATION OF
THE PROPERTY, ITS EXTERIOR BOUNDARIES, THE LOCATION OF ALL VISIBLE STRUCTURES
AND DIMENSIONS OF ALL PRINCIPAL BUILDINGS THEREON, BOUNDARY FENCES, APPARENT
EASEMENTS, ROADWAYS AND VISIBLE ENCROACHMENTS, IF ANY, TO THE BEST OF MY
KNOWLEDGE AND BELIEF.

THIS SURVEY IS MADE FOR THE USE OF THE PRESENT OWNERS OF THE PROPERTY, AND ALSO
THOSE WHO PURCHASE, MORTGAGE, OR GUARANTEE THE TITLE THERETO WITHIN ONE (1) YEAR
FROM DATE HEREON.

David F. Abell
DAVID F. ABELL
WISCONSIN REGISTERED LAND SURVEYOR, S-1596

March 31, 1995 REVISED DATE APRIL 4, 1995
DATE JOB NUMBER - 95030B
NOTE: THIS IS NOT A CERTIFIED COPY UNLESS SEALED.

- LEGEND
- - IRON PIPE FOUND
 - - IRON ROD FOUND
 - CS - CONCRETE STOOP
 - CP - COVERED PORCH
 - BE - BASEMENT ENTRY
 - * - CHAINLINK FENCE
 - - OVERHEAD UTILITY LINES
 - () - RECORDED AS

YD-61

004-1988