


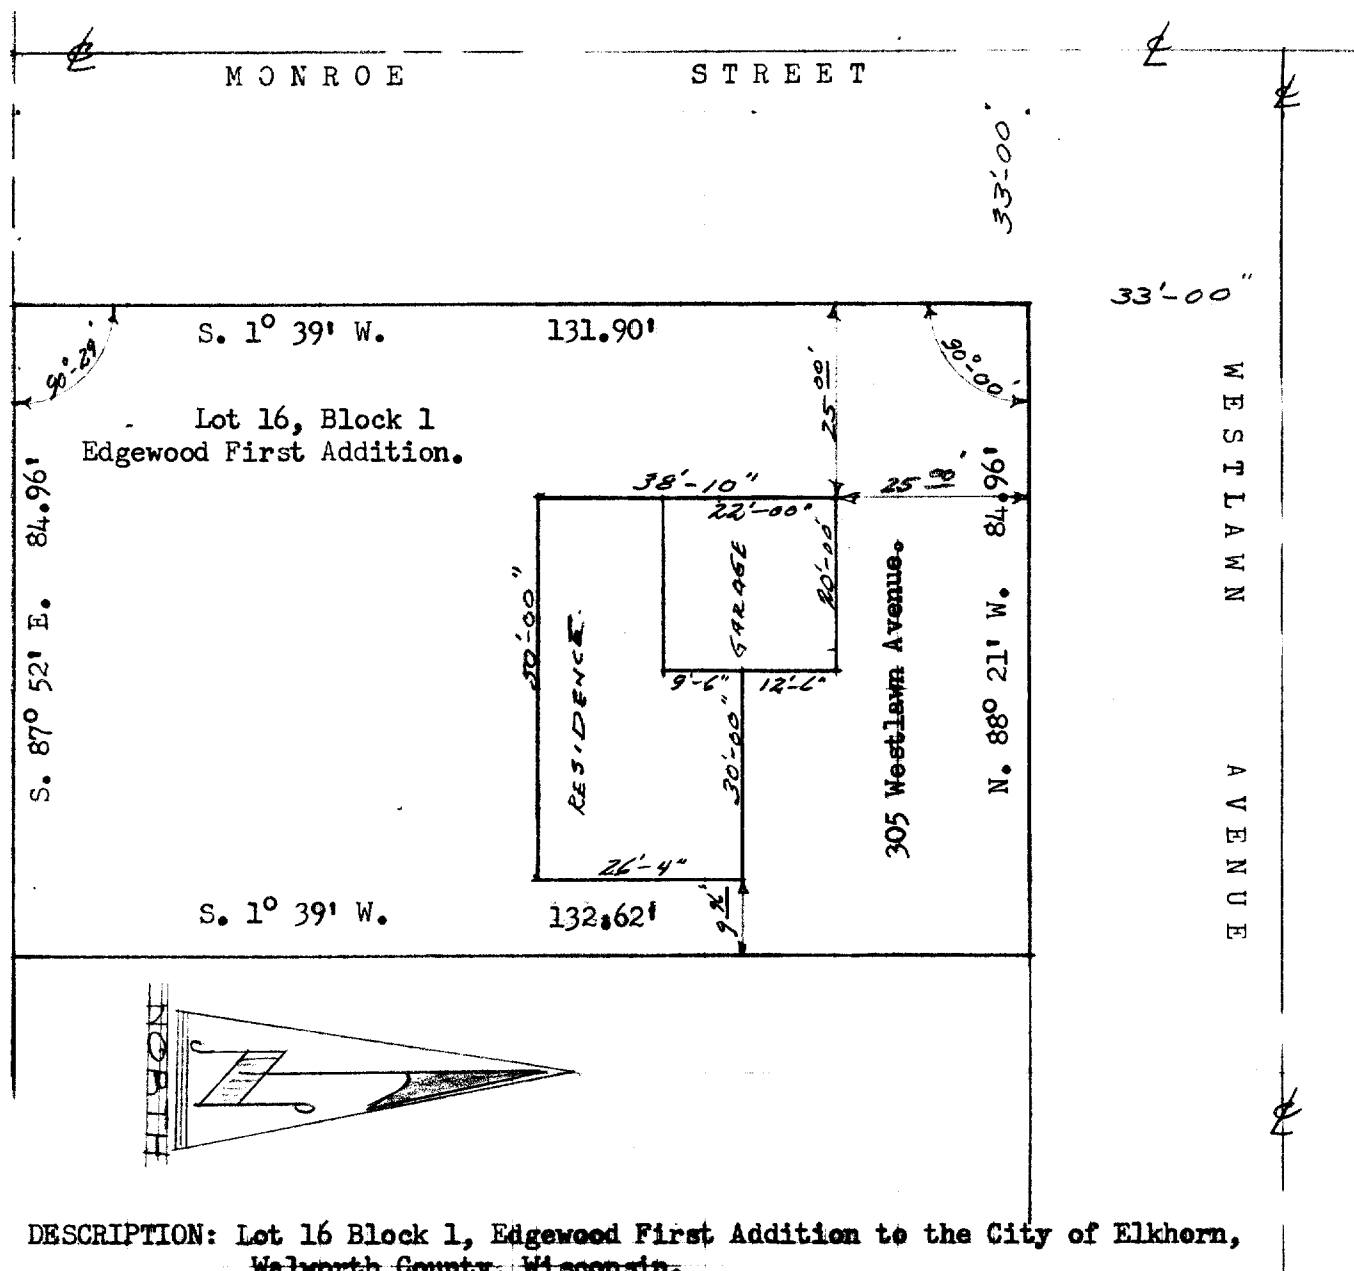


DESCRIPTION: Lot 16 Block 1, Edgewood First Addition to the City of Elkhorn,
Walworth County, Wisconsin.

CERTIFICATE: I, James F. Biagi, Surveyor do hereby certify that I have surveyed
the property hereon described on this the 16th day of December, 1965.

Dated: December 16th 1965.

James F. Biagi
James F. Biagi, RLS 272
Elkhorn, Wisconsin

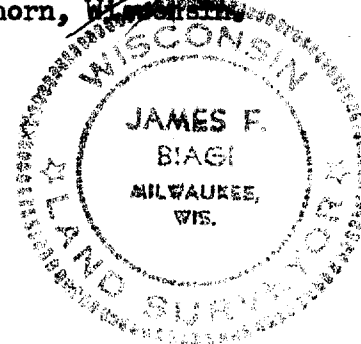

4EAL-13

4-18