
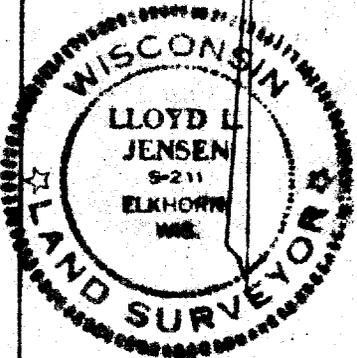


# PLAT OF SURVEY

OF

A DRIVEWAY EASEMENT LOCATED IN PART OF LOTS ONE AND FOUR OF BLOCK 22, ROCKWELL'S ADDITION TO THE CITY OF ELKHORN, WALWORTH COUNTY, WISCONSIN, THE CENTERLINE OF WHICH IS DESCRIBED AS FOLLOWS, TO-WIT: BEGIN AT A POINT ON THE NORTH LINE OF SAID LOT ONE, 49.5 FEET EAST OF THE NORTHWEST CORNER OF SAID LOT ONE; THENCE SOUTH ALONG A LINE PARALLEL TO THE WEST LINE OF SAID BLOCK 22, 113.19 FEET TO THE END OF THE 12 FOOT DRIVEWAY EASEMENT.

COURT ST.

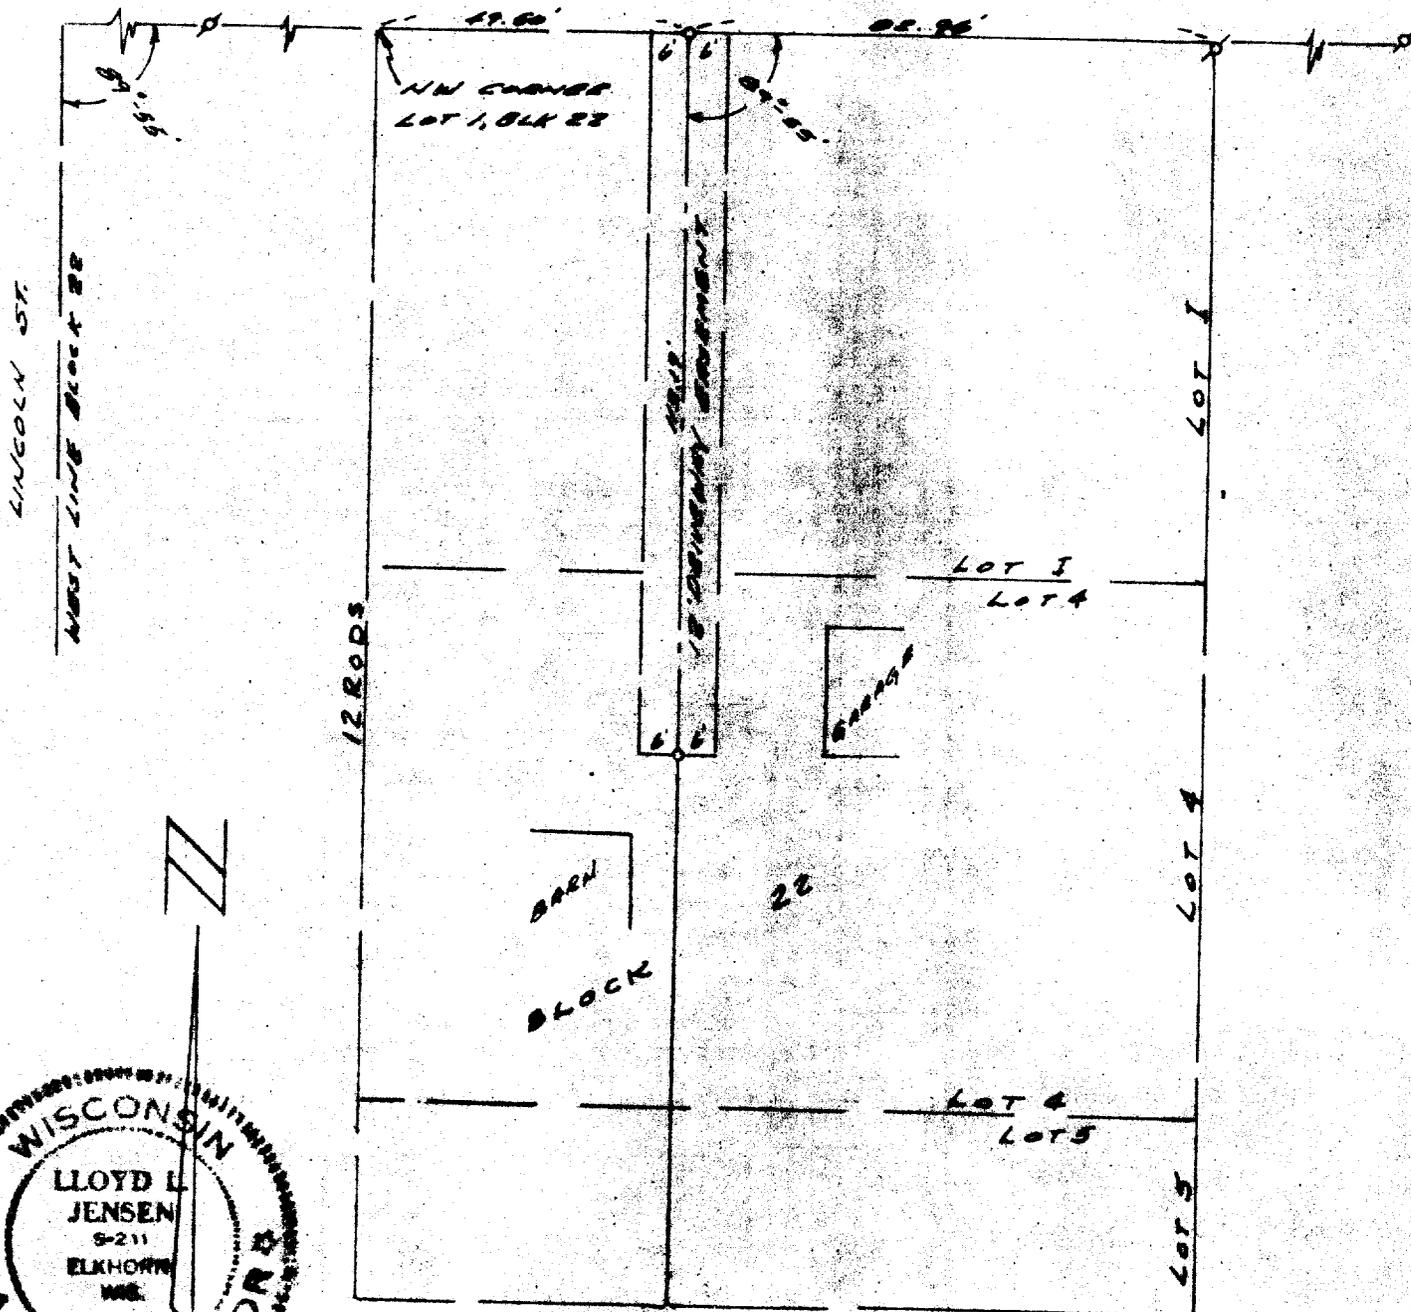

SURVEY AND PLAT BY

**JENSEN & JOHNSON, INC.**

CIVIL ENGINEERS AND SURVEYORS

Elkhorn, Wisconsin

**LEGEND**

- — Iron Pipe 5/8"
- — Concrete Monument
- Scale 1" = 50'
- 12.00' DRIVEWAY EASEMENT

WE CERTIFY: That we have surveyed the above described property and that the plat above shown is an accurate survey and a true representation thereof and correctly shows the exterior boundary lines and all divisions of said property.

Date OCT. 1946

*Lloyd L. Jensen*  
**LLOYD L. JENSEN,**

Wisconsin Registered Land Surveyor, No. S-211

4-200J ✓

Y Rvs-15, 16