


CARROLL CONNOR

O-INDICATES IRON PIPE

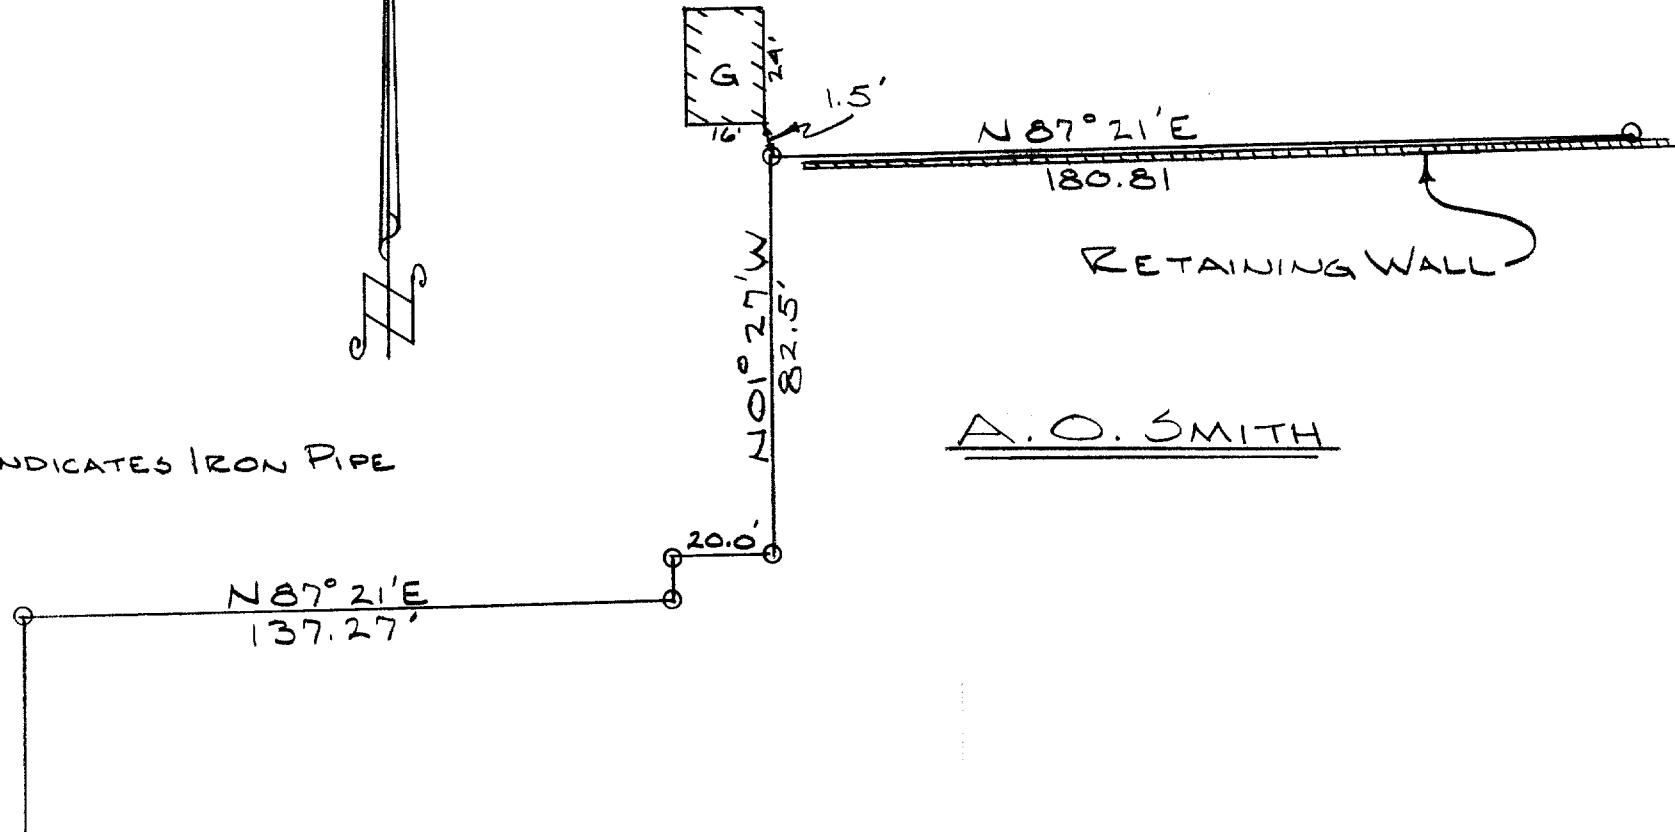

A.O. SMITH

#47-70

EK-49 30

4-201