
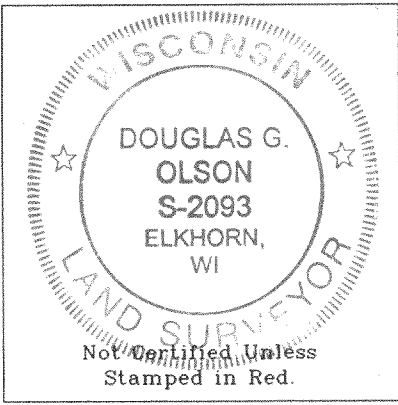


Plat of Survey

of
Lot 27 of Hearthstone of Elkhorn,
located in the Northeast 1/4 of Section 25, Town 3 North,
Range 16 East, City of Elkhorn, Walworth County, Wisconsin.

Surveyed for: **Chuck Cochran**
1031 North Pheasant Way
Elkhorn, Wisconsin. 53121

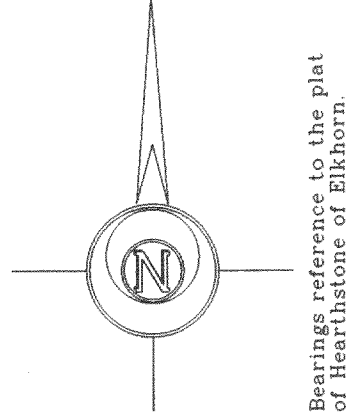

Rec'd
May 11 2006
JMF

- Notes: 1) This survey plat is not certified unless signed and sealed in red ink.
- 2) This survey is subject to Wisconsin lien laws. This Plat of Survey is the notice of intent to file lien. Lien waiver required.

Copyright c 2005 by Jensen & Olson Land Surveying, LLC.


All rights reserved. No part of this survey plat may be reproduced or transmitted in any form by any means - graphic, electronic, or mechanical, including photocopying, tracing, or information storage and retrieval systems - without permission in writing from Douglas G. Olson, Jensen & Olson Land Surveying, LLC.

I hereby certify that I have surveyed the above described property and the map hereon is correct to the best of my professional knowledge and belief and shows the size and location of the property, its exterior boundaries, the location and dimensions of all visible structures thereon, boundary fences, apparent easements and roadways and visible encroachments, if any.

This survey is made for the exclusive use of the present owners of property, and also those who purchase, mortgage or guarantee title thereto, within one year from the date hereof.

Douglas G. Olson
Wisconsin Registered Land Surveyor - 2093


Survey Date: November 7, 2005.
Revisions:

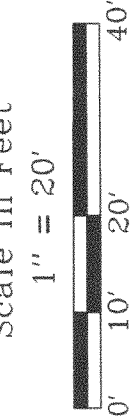

Jensen & Olson Land Surveying, LLC
45 South Wisconsin Street P.O. Box 322
Elkhorn, Wisconsin. 53121
Telephone (262) 723-3434
Facsimile (262) 723-8044

- Legend**
- + Found Chiselled Cross Cut
 - Found Iron Pipe
 - Set Iron Rod, 3/4" dia.
 - Set Chiselled Cross Cut
 - () Recorded Information
 - ⊗ Utility Pedestal
 - ⊗ Fire Hydrant
 - ⊗ Asphalt Surface
 - ⊗ Concrete

Sheet 1 of 1 Sheets
Job Reference Number
2005.148
2005.148

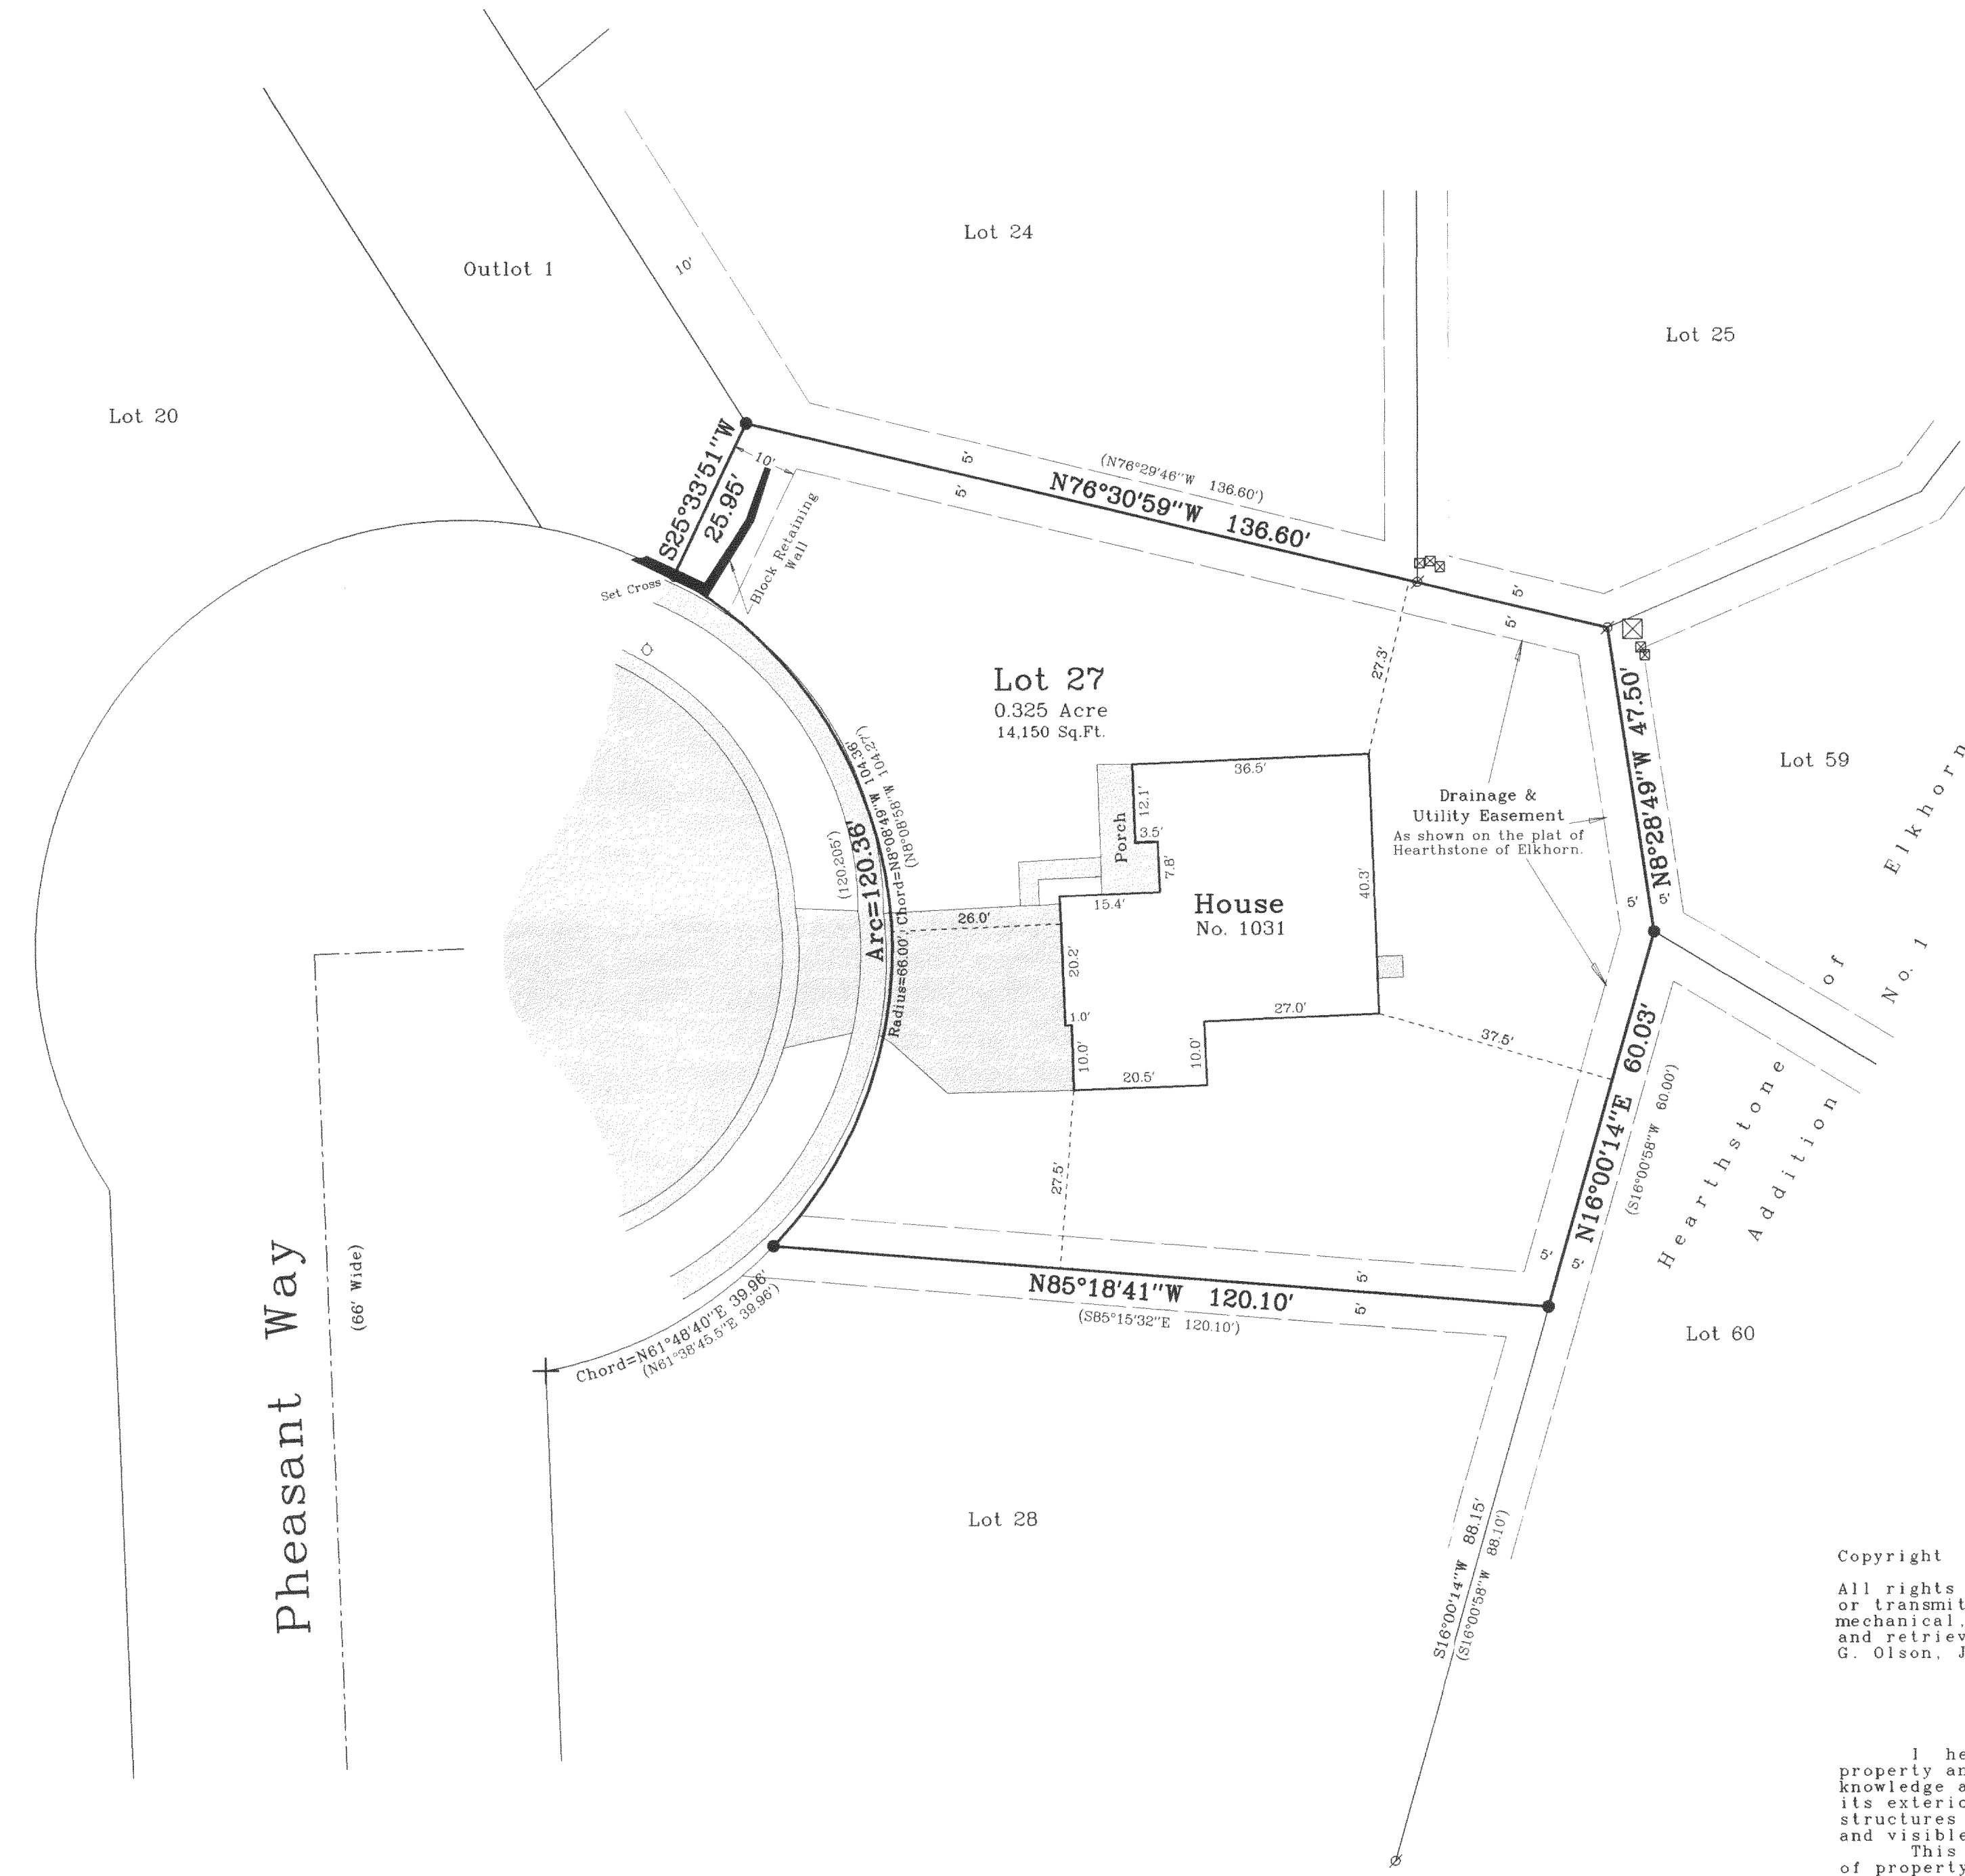

YHE-21

004-2036