



Page Street

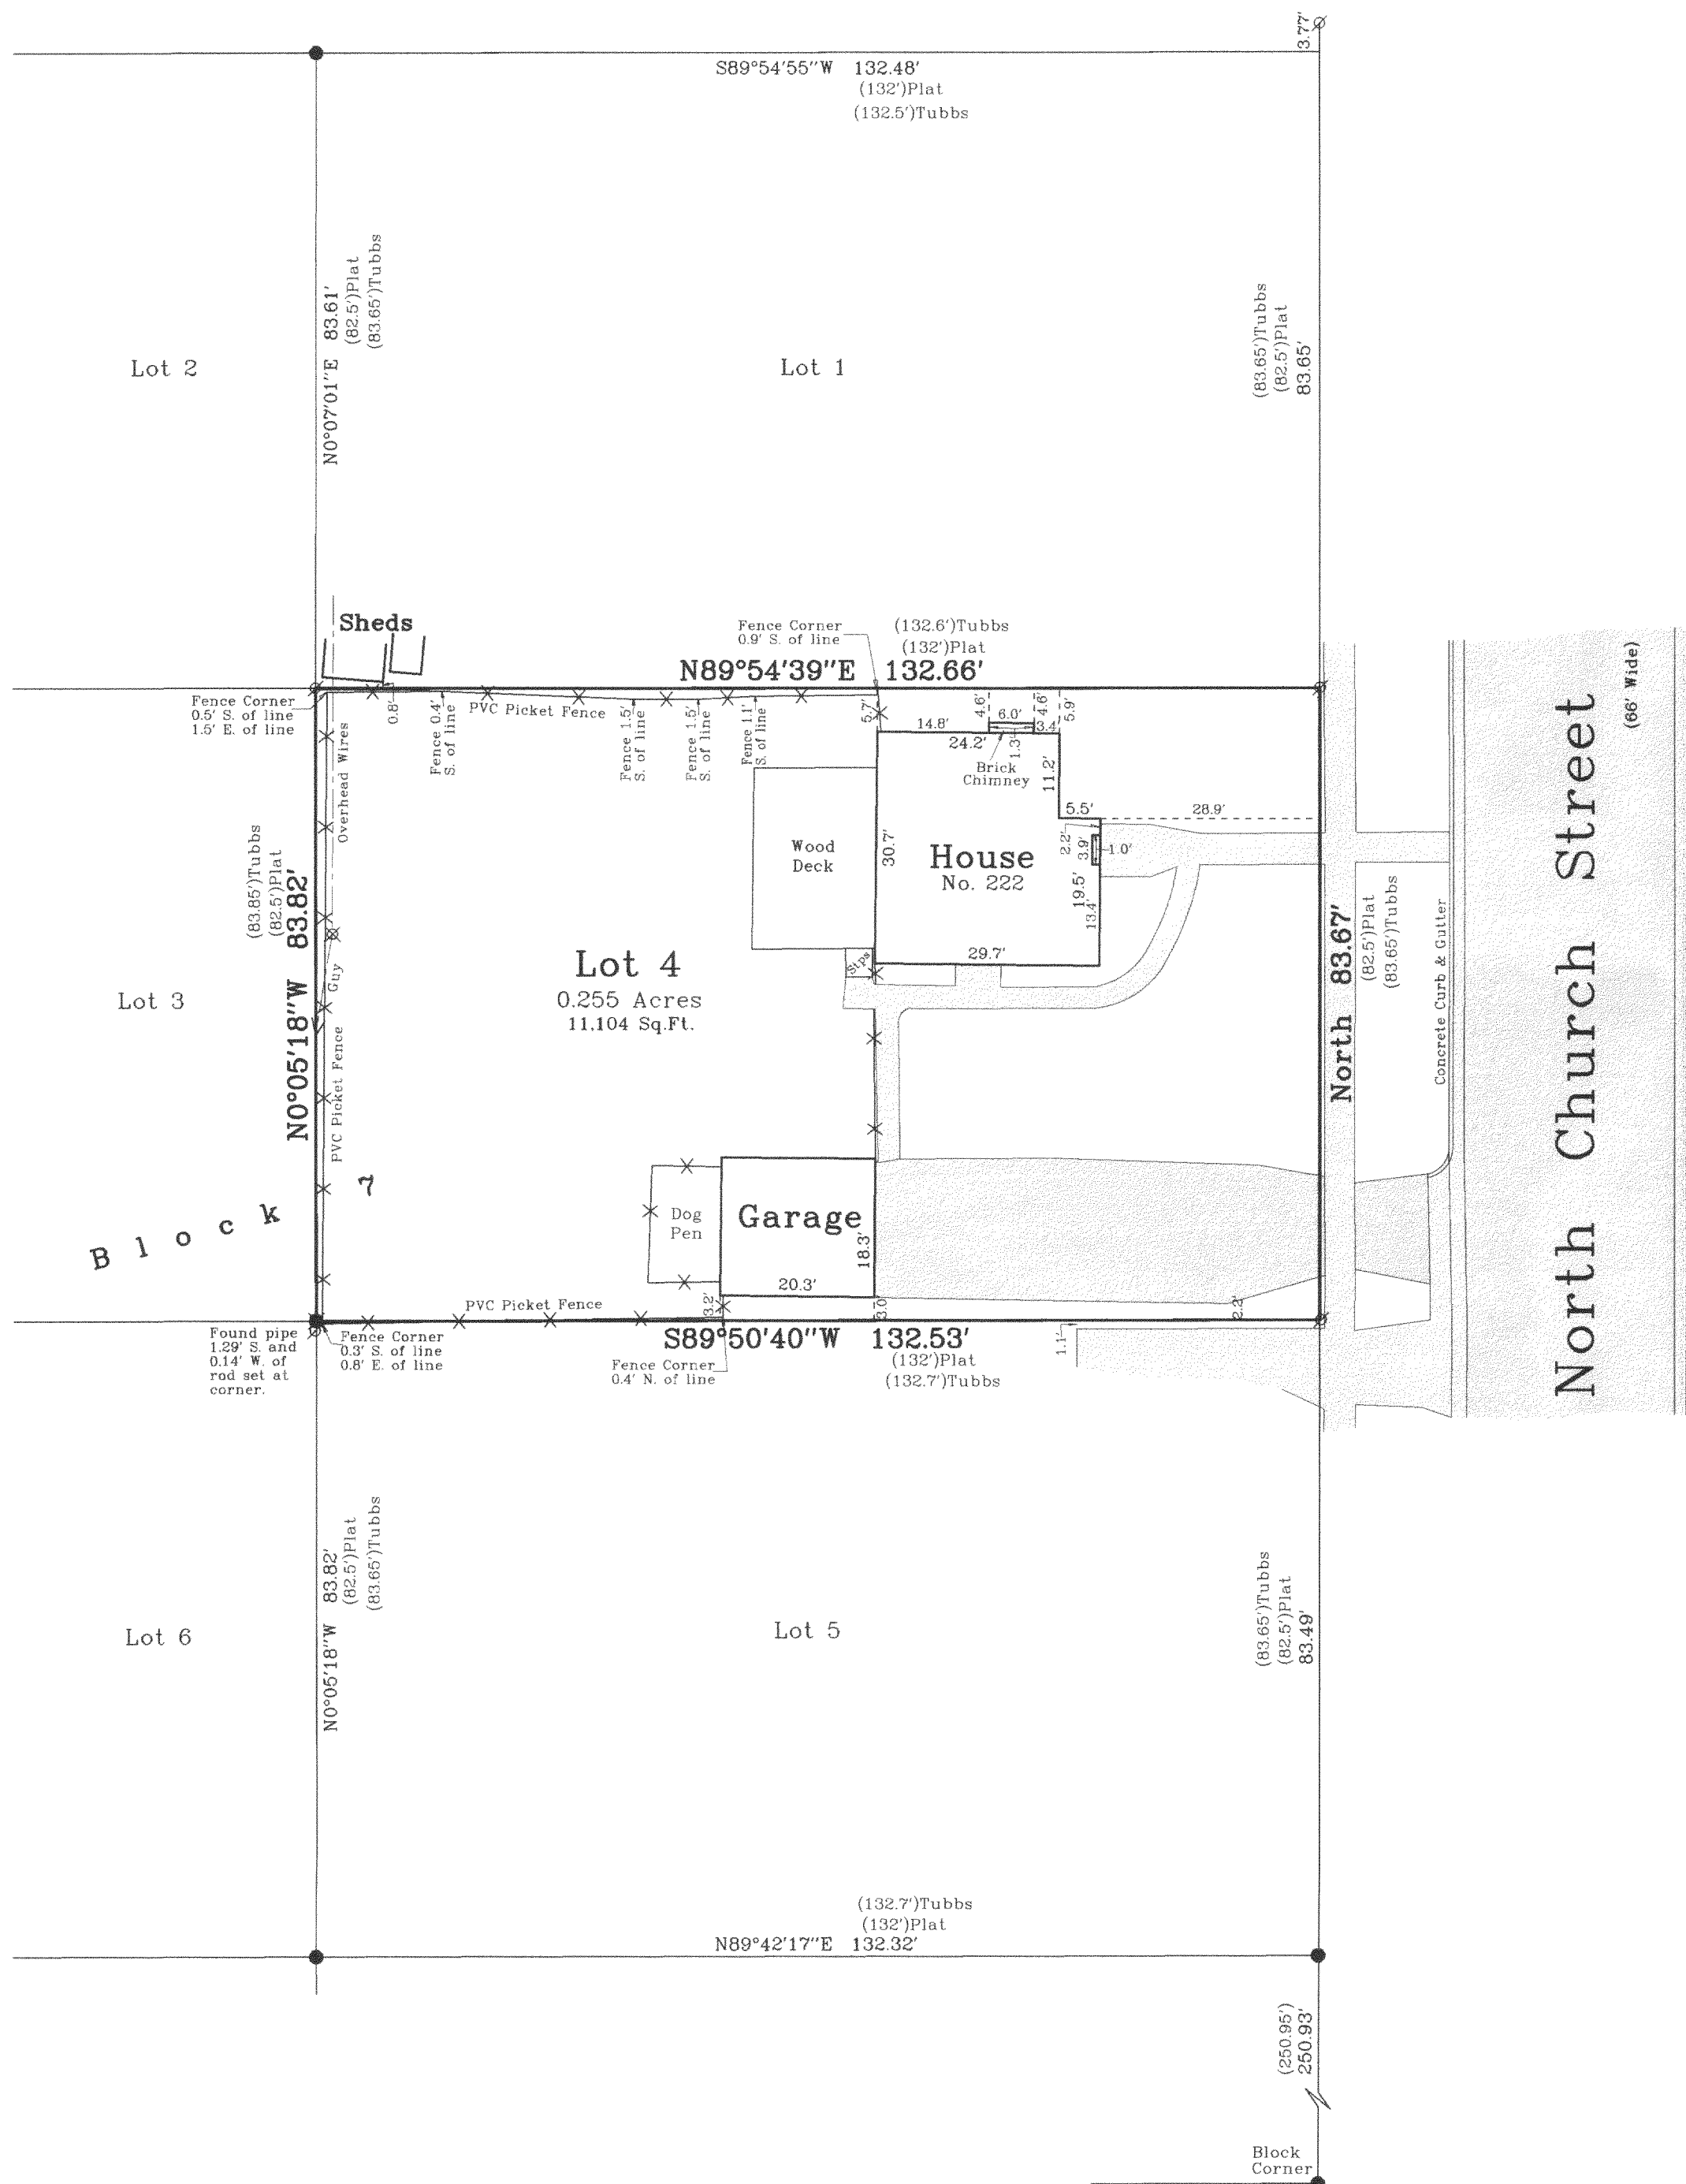


Plat of Survey

of
Lot 4 of Block 7 of the Original Plat of the
Village (now city) of Elkhorn,
located in the Southeast 1/4 of Section 36, Town 3 North,
Range 16 East, City of Elkhorn, Walworth County, Wisconsin.

Surveyed for:
Godfrey, Leibsle, Blackbourn & Howarth, S.C.
354 Seymour Court ** Post Office Box 260
Elkhorn, Wisconsin. 53121

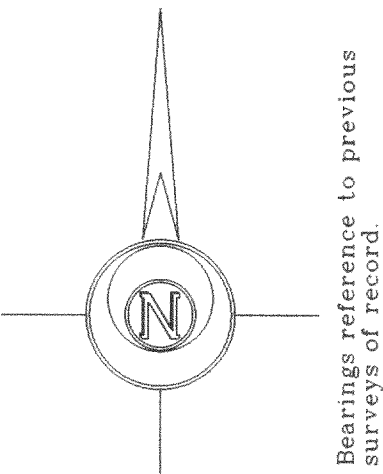

Note:
(82.5')Plat - Indicates dimension as shown on the Original Plat of the City of Elkhorn.
(83.65')Tubbs - Indicates dimension as shown on Mr. Tubbs' survey of the City of Elkhorn.

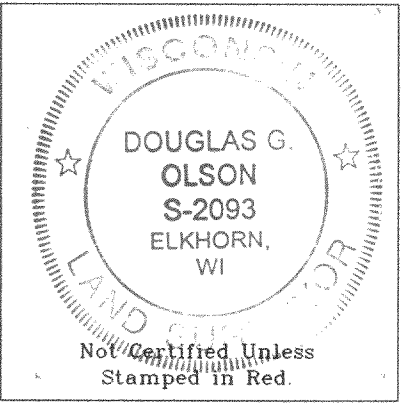

Notes: 1) This survey plat is not
certified unless signed
and sealed in red ink.
2) This survey is subject to Wisconsin lien laws.
This Plat of Survey is the notice of intent
to file lien. Lien waiver required.

Copyright c 2005 by Jensen & Olson Land Surveying, LLC.
All rights reserved. No part of this survey plat may be reproduced
or transmitted in any form by any means - graphic, electronic, or
mechanical, including photocopying, tracing, or information storage
and retrieval systems - without permission in writing from Douglas
G. Olson, Jensen & Olson Land Surveying, LLC.

I, Douglas G. Olson, Wisconsin Registered Land Surveyor,
do hereby certify that this survey was performed by me or under my
direction in full compliance with the owner's/agent's instructions
and Chapter A-E 7 of the Wisconsin Administrative Code "Minimum
Standards for Property Surveys"; and that this map is an accurate
representation thereof to the best of my knowledge and belief.

Douglas G. Olson
Wisconsin Registered Land Surveyor - 2093

Survey Date: December 20, 2005	
Revisions:	
Scale in Feet 1" = 20' 0' 10' 20' 40'	
Jensen & Olson Land Surveying, LLC 45 South Wisconsin Street P.O. Box 322 Elkhorn, Wisconsin. 53121 Telephone (262) 723-3434 Facsimile (262) 723-8044	
Legend Found Iron Pipe Found Iron Rod Set Iron Rod, 3/4" dia. Recorded Information (See Note) Concrete Surface Utility Pole Asphalt Surface	Sheet 1 of 1 Sheets Job Reference Number 2005.167 2005.167