

Plat of Survey

of

Lot 7, except the South 4 Feet of thereof,
in Block 1 of Tree Towns Subdivision,

located in the Northwest 1/4 of Section 31, Town 3 North,
Range 17 East, City of Elkhorn, Walworth County, Wisconsin.

Surveyed for: **Pat Jankowski**

624 North Jackson Street
Elkhorn, Wisconsin. 53121

Detail
1"=5'

Lot 6


Lot 7

9" dia. stump
Center of stump
0.6' E. of line.


7" dia. stump
Center of stump
0.1' E. of line.

9" dia. stump
Center of stump
0.1' W. of line.

6" dia. stump
Center of stump
0.3' E. of line.

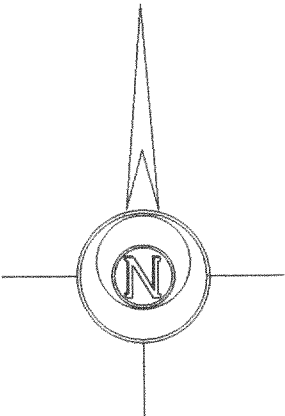

Bearings reference to the plat of
Tree Towns Subdivision.

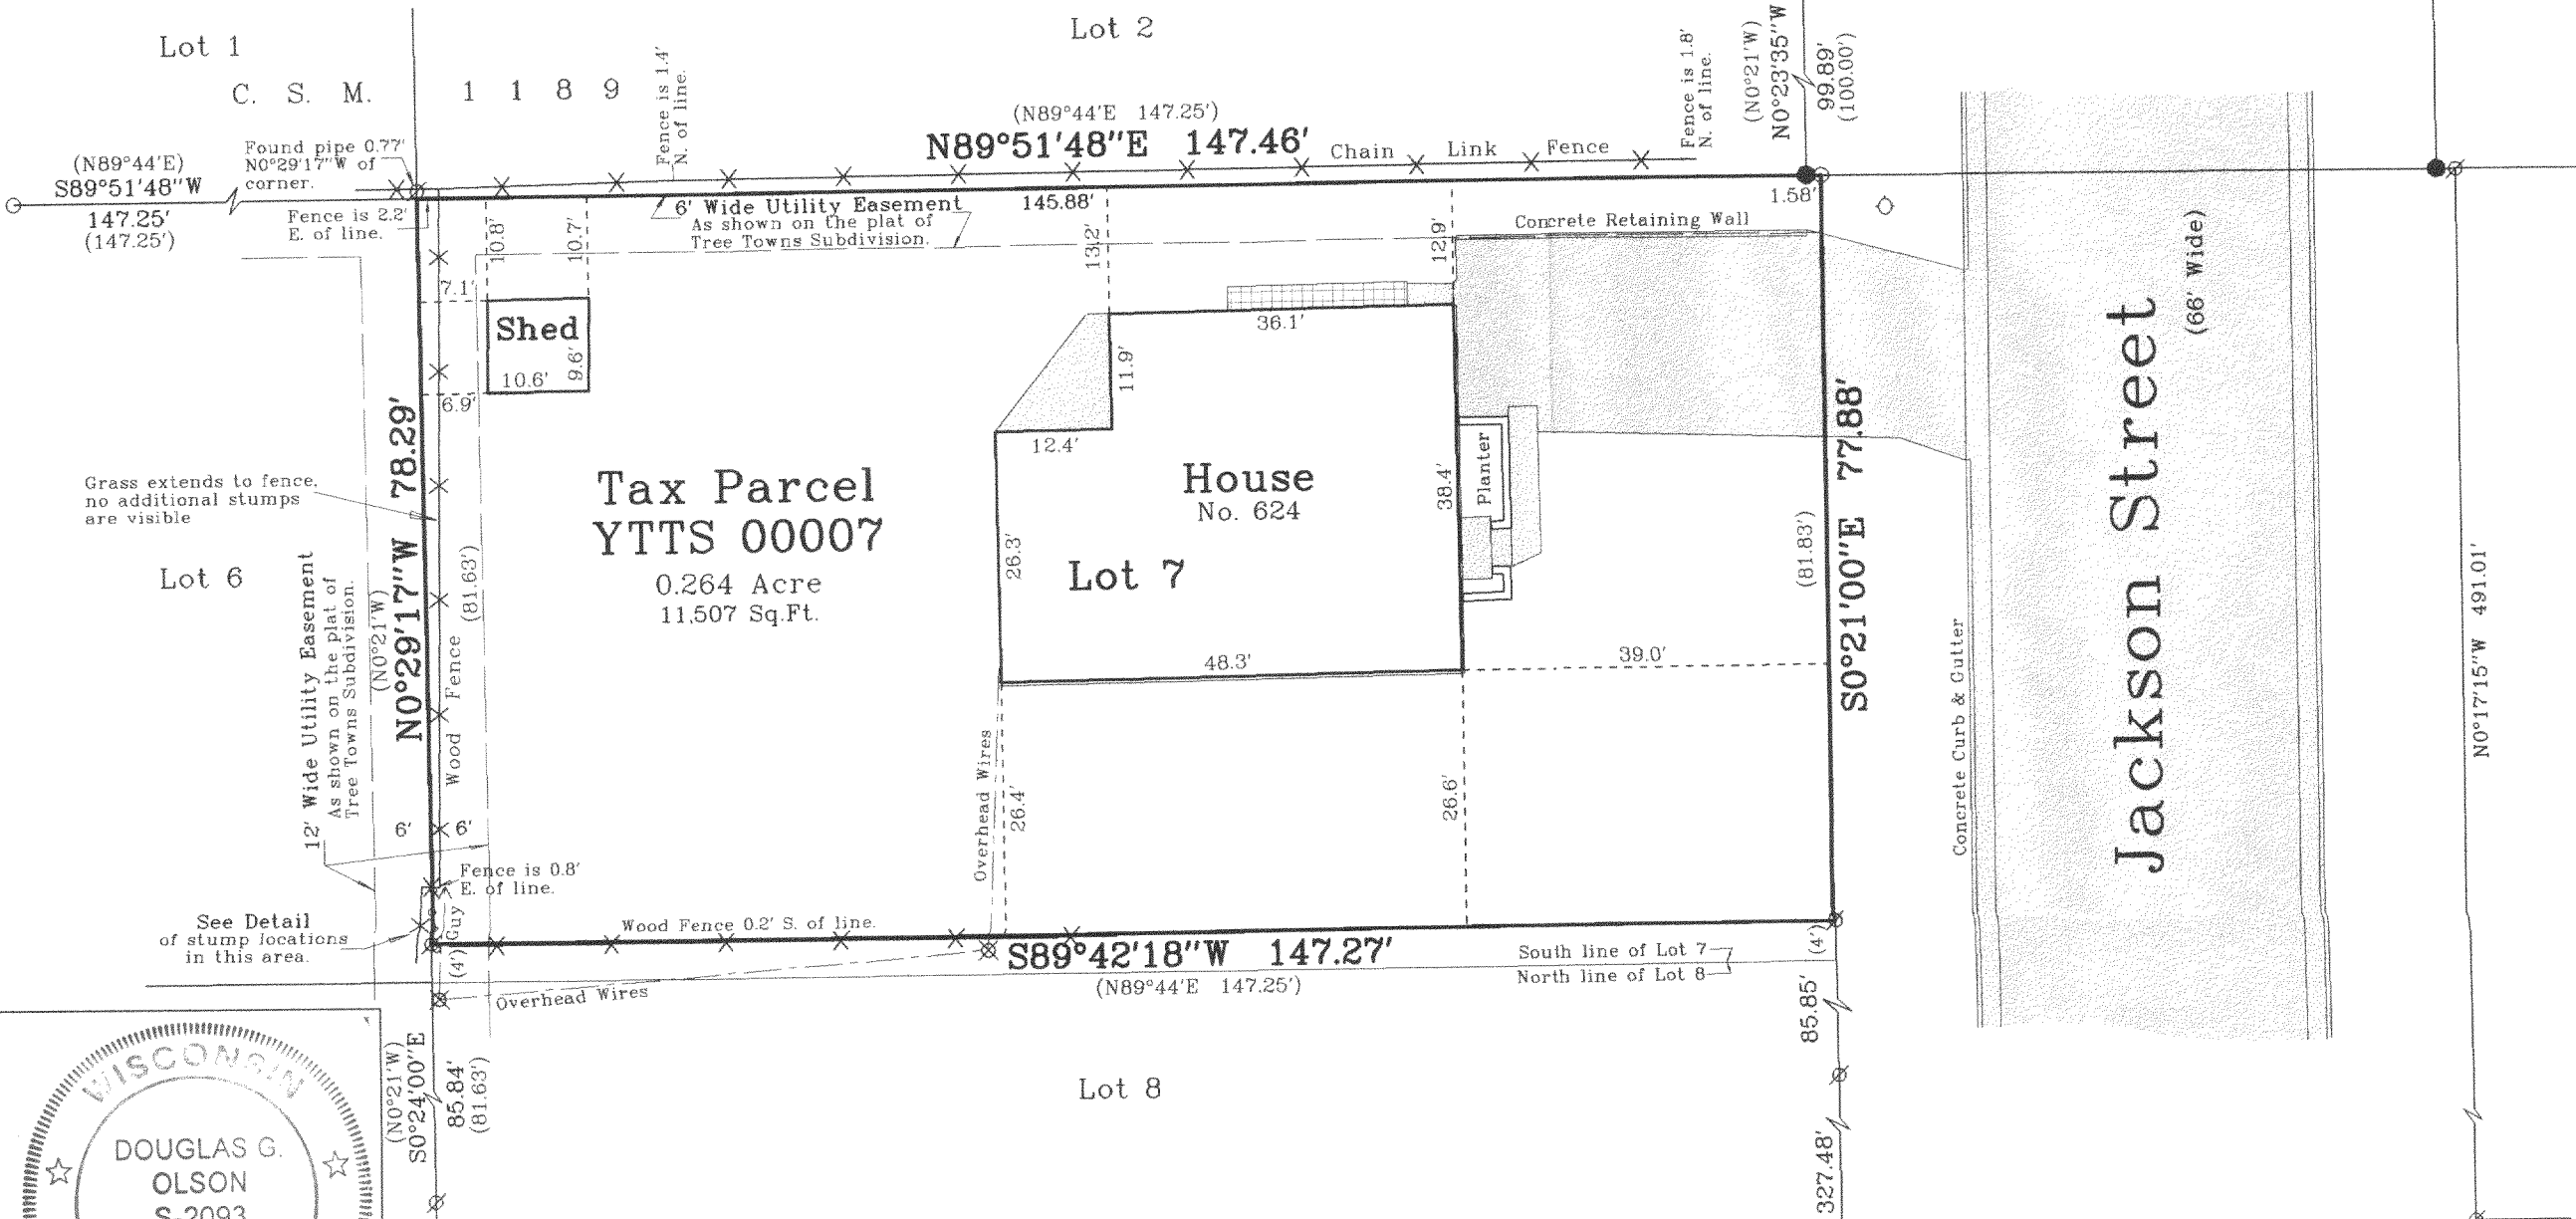

Rec'd
MAY 11 2006
smf

Jensen & Olson Land Surveying, LLC

45 South Wisconsin Street P.O. Box 322
Elkhorn, Wisconsin. 53121
Telephone: (262) 723-3434
Facsimile: (262) 723-8044

Scale: 1" = 20'



Legend

- Found Iron Pipe 1-3/16" dia.
- Found Iron Rod, 3/4" dia.
- Recorded Information
- Utility Pole
- Asphalt Surface
- Concrete Surface
- Brick Surface


YTT5-7

Survey date: November 9, 2004.
Revisions: No. 1 - Stumps

Sheet 1 of 1 Sheets.

Job Reference Number:

004-2038 2004.174

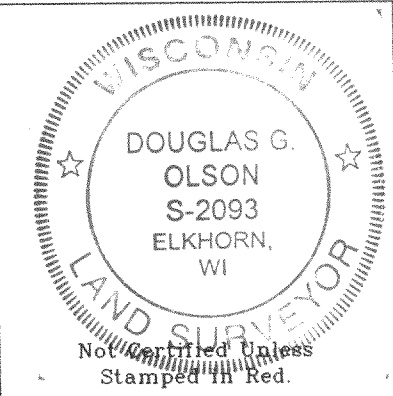

Copyright c 2005 by Jensen & Olson Land Surveying, LLC.

All rights reserved. No part of this survey plat may be reproduced or transmitted in any form by any means - graphic, electronic, or mechanical, including photocopying, tracing, or information storage and retrieval systems - without permission in writing from Douglas G. Olson, Jensen & Olson Land Surveying, LLC.

I, Douglas G. Olson, Wisconsin Registered Land Surveyor, do hereby certify that this survey was performed by me or under my direction in full compliance with the owner's/agent's instructions and Chapter A-E 7 of the Wisconsin Administrative Code "Minimum Standards for Property Surveys"; and that this map is an accurate representation thereof to the best of my knowledge and belief.

Douglas G. Olson
Wisconsin Registered Land Surveyor - 2093

- Notes:
- 1) This survey plat is not certified unless signed and sealed in red ink.
 - 2) This survey is subject to Wisconsin lien laws. This Plat of Survey is the notice of intent to file lien. Lien waiver required.