


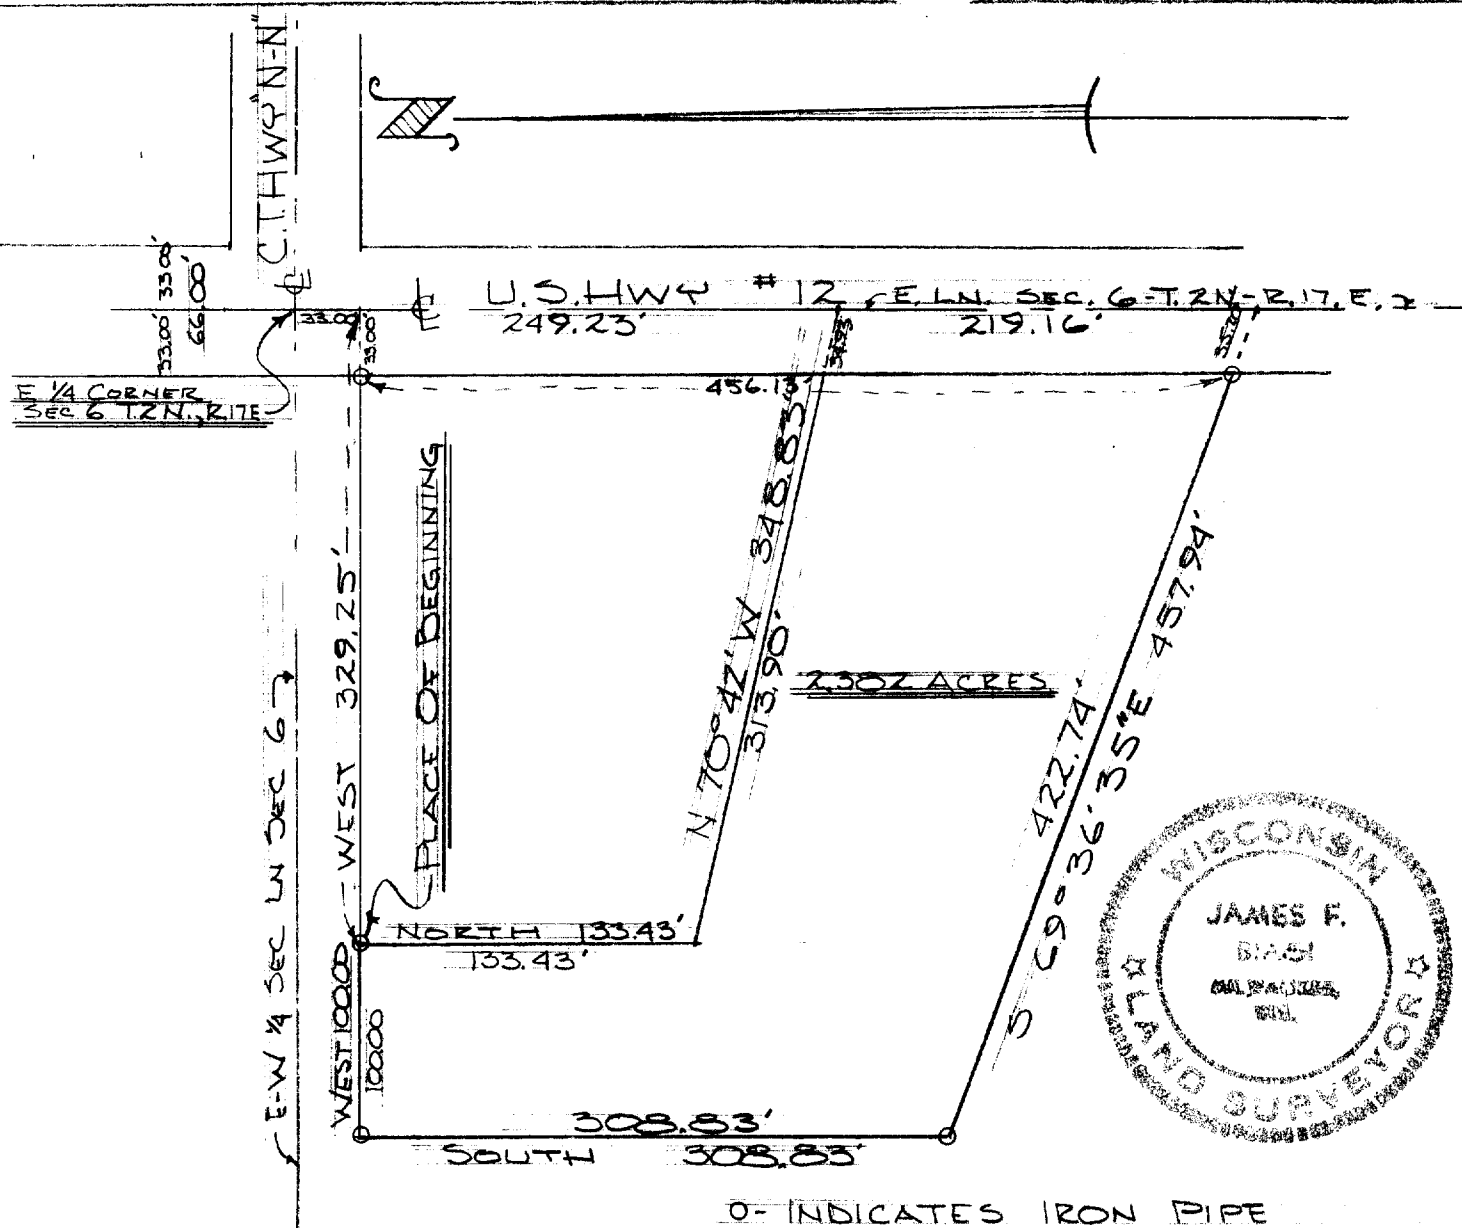

DESCRIPTION: COMMENCING AT THE EAST  $\frac{1}{4}$  CORNER OF SECTION 6, T. 2 N., R. 17 E., IN THE CITY OF ELKHORN, WALWORTH COUNTY, WISCONSIN; THENCE SOUTH ALONG THE EAST LINE OF SAID SECTION 33.00 FEET, THENCE WEST 329.25 FEET TO THE PLACE OF BEGINNING OF THE LANDS HEREINAFTER DESCRIBED, TO WIT: THENCE CONTINUE WEST 100.00 FEET, THENCE SOUTH 308.83 FEET, THENCE S.  $69^{\circ} 36' 35''$  E. 457.94 FEET TO THE EAST LINE OF SAID SECTION, THENCE NORTH 219.16 FEET, THENCE N.  $70^{\circ} 42' W.$  348.83 FEET, THENCE NORTH 133.43 FEET TO THE PLACE OF BEGINNING. CONTAINING 2.382 ACRES.

CERTIFICATE: I, JAMES F. BIAGI, SURVEYOR DO HEREBY CERTIFY THAT I HAVE SURVEYED THE PROPERTY HEREON DESCRIBED.

DECEMBER 12, 1966.

*James F. Biagi*  
James F. Biagi RLS 272