


...being more particularly described as follows: Commencing at the Southeast corner of Lot 12, Block 2 of Fairlane Subdivision Addition No. 1; thence East 19.93 feet to an iron pipe and the point of beginning; thence continue East 289.87 feet to an iron rod; thence South 44°11'00" West, 318.80 feet to an iron pipe; thence North 16°27' West, 238.37 feet to the point of beginning, being 0.760 acres of land more or less.

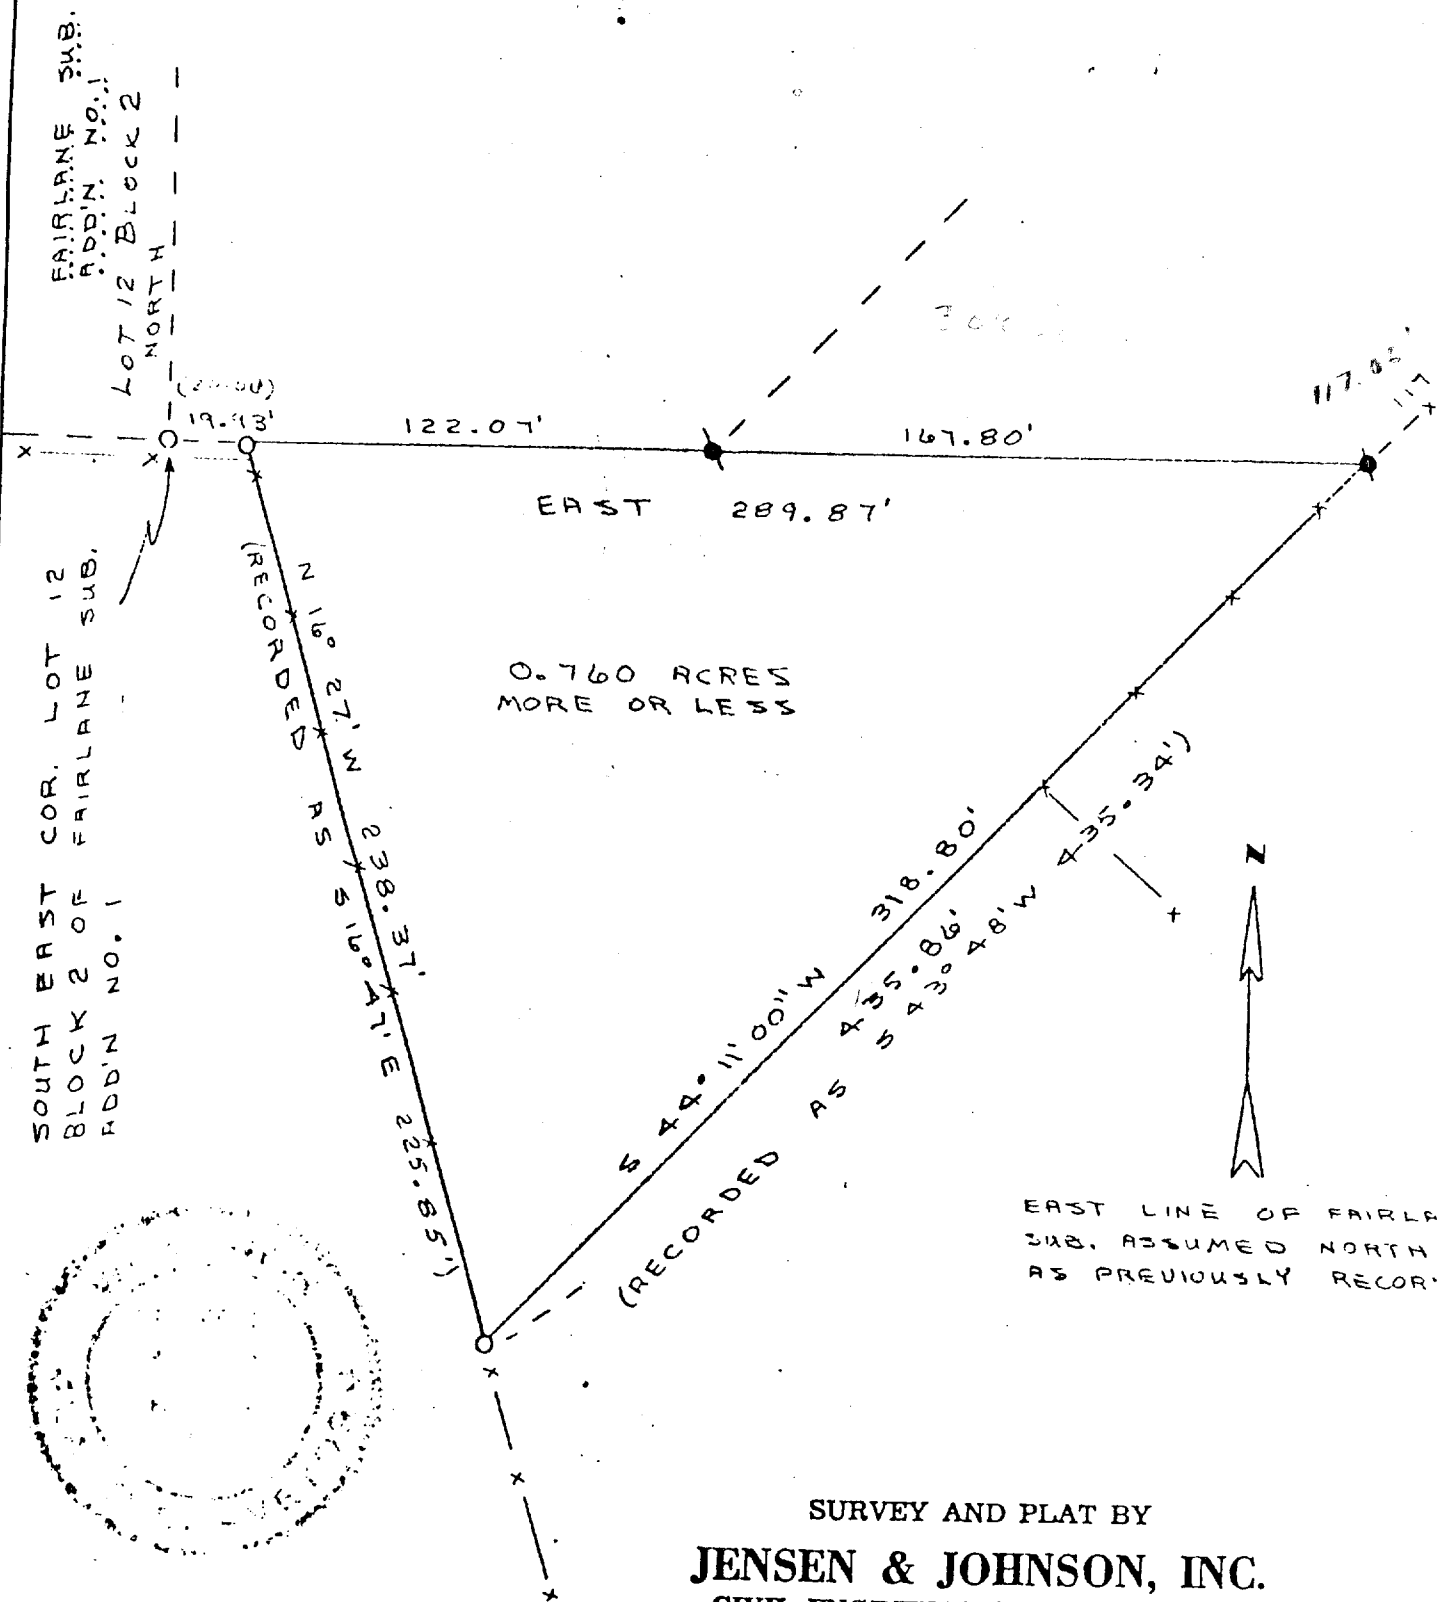

175H

VOL 160 PAGE 47

1 P4 C S 1290

U-NE-7C (part of)

4-206 J