

LAND-MARK SURVEYING

Mark L. Miritz

Wisconsin Registered Land Surveyor S-2582

N9330 Knuteson Drive
Whitewater, WI 53190
Phone: (262) 495-3284
FAX: (262) 495-8421
LAND-MARKSURVEYING.COM

OWNER: SANDRA BROWN
C/O SANDRA GUADIAN
441 OAK RIDGE DR.
DARIEN, WI. 53114


PLAT OF SURVEY

PART OF LOTS 2 AND 3 OF BLOCK 36
OF DAVIS ADDITION TO THE CITY OF
ELKHORN, WALWORTH COUNTY, WISCONSIN.

TOTAL PARCEL AREA
20,719 S.F. (0.48 AC.)

REFERENCE DEED - SEE VOL. 665 P. 2061 DOC. NO. 421448 RECORDED 7/16/99

NOTE: this survey retraces a previous Plat of Survey prepared by Lloyd L. Jensen Dated April, 1940

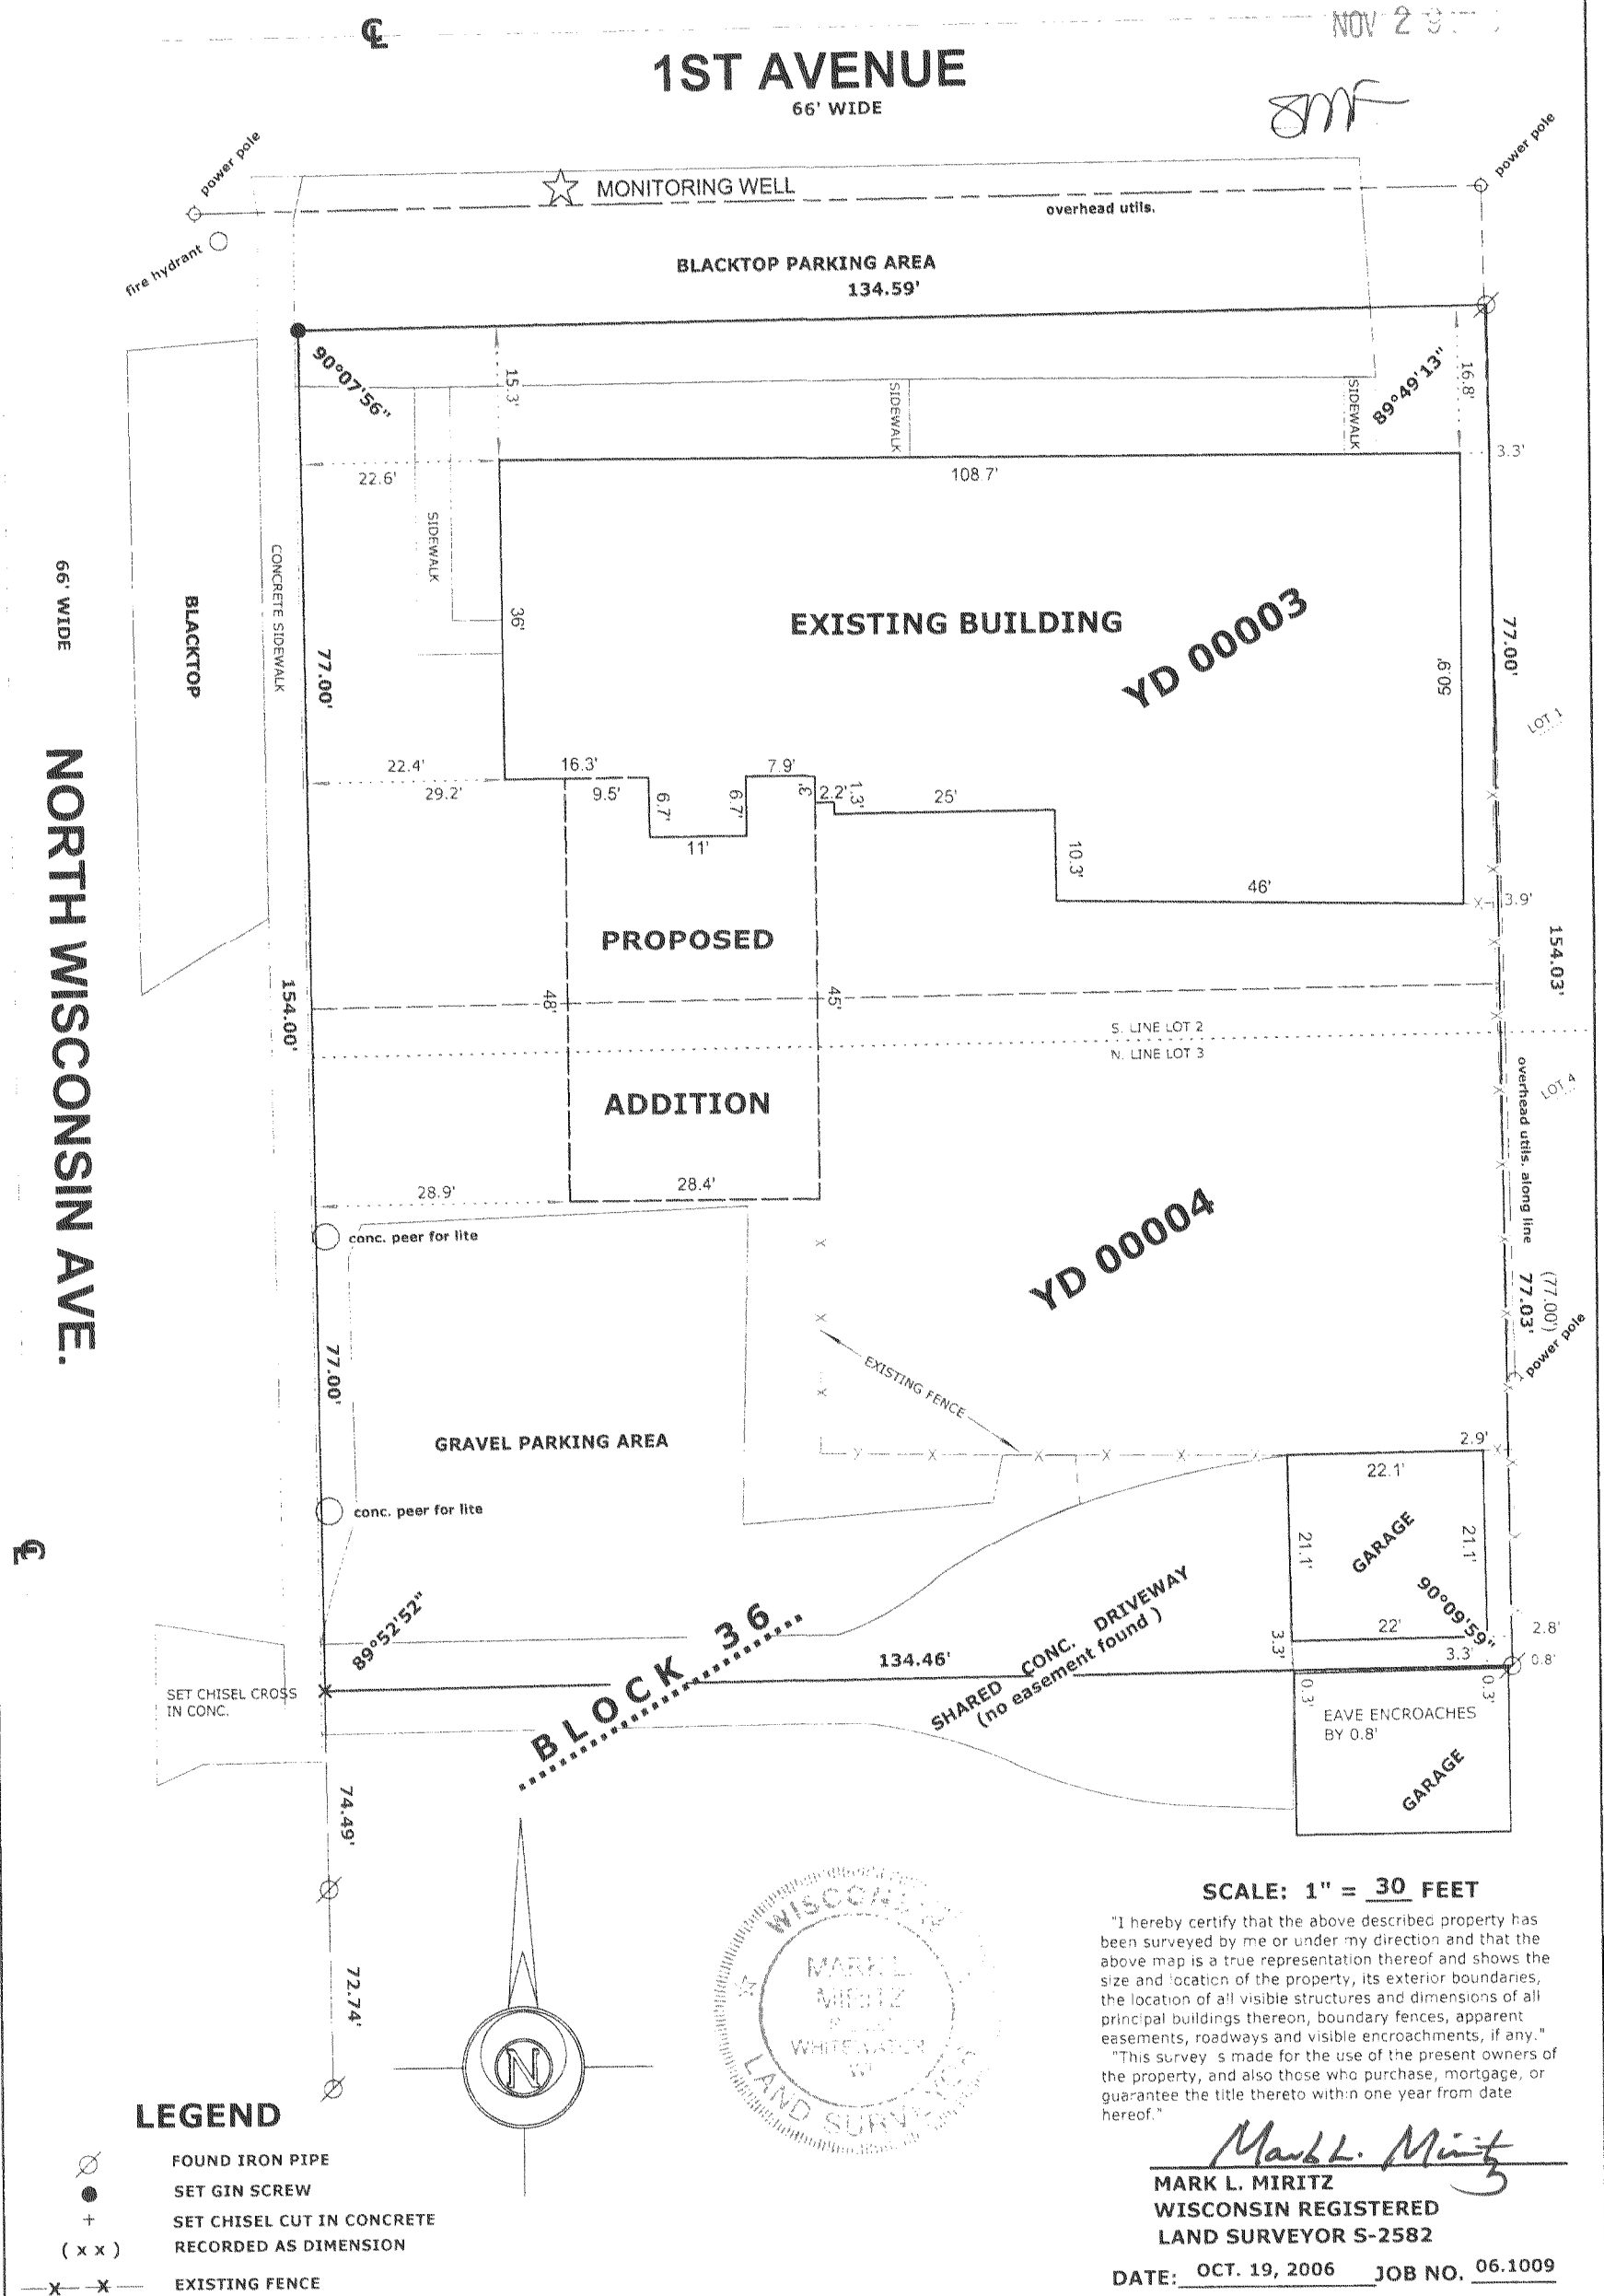

YD-3 YD-4

004-2086