

PLAT OF SURVEY



Engineers Land Surveyors Environmental Scientists  
W232 S7530 816 BEND DR. BIG BEND, WI 53103 (262)662-4292


FOR: LAKELAND BUILDERS

DATE: 8/24/2006

DESCRIPTION: LOT 15 OF FAIRWAYS EDGE BUSINESS PARK FIRST ADDTION, LOCATED IN PART OF THE SE 1/4 OF THE NE 1/4 OF SECTION 24, TOWN 3 NORTH, RANGE 16 EAST, AND INCLUDING LOT 2 OF CSM # 3296 RECORDED IN VOL. 18 PAGES 249-250 AS DOCUMENT NO. 460520, CITY OF ELKHORN, WALWORTH COUNTY, WISCONSIN.

LEGEND

- FOUND IRON PIPE
- ⊕ FOUND IRON ROD

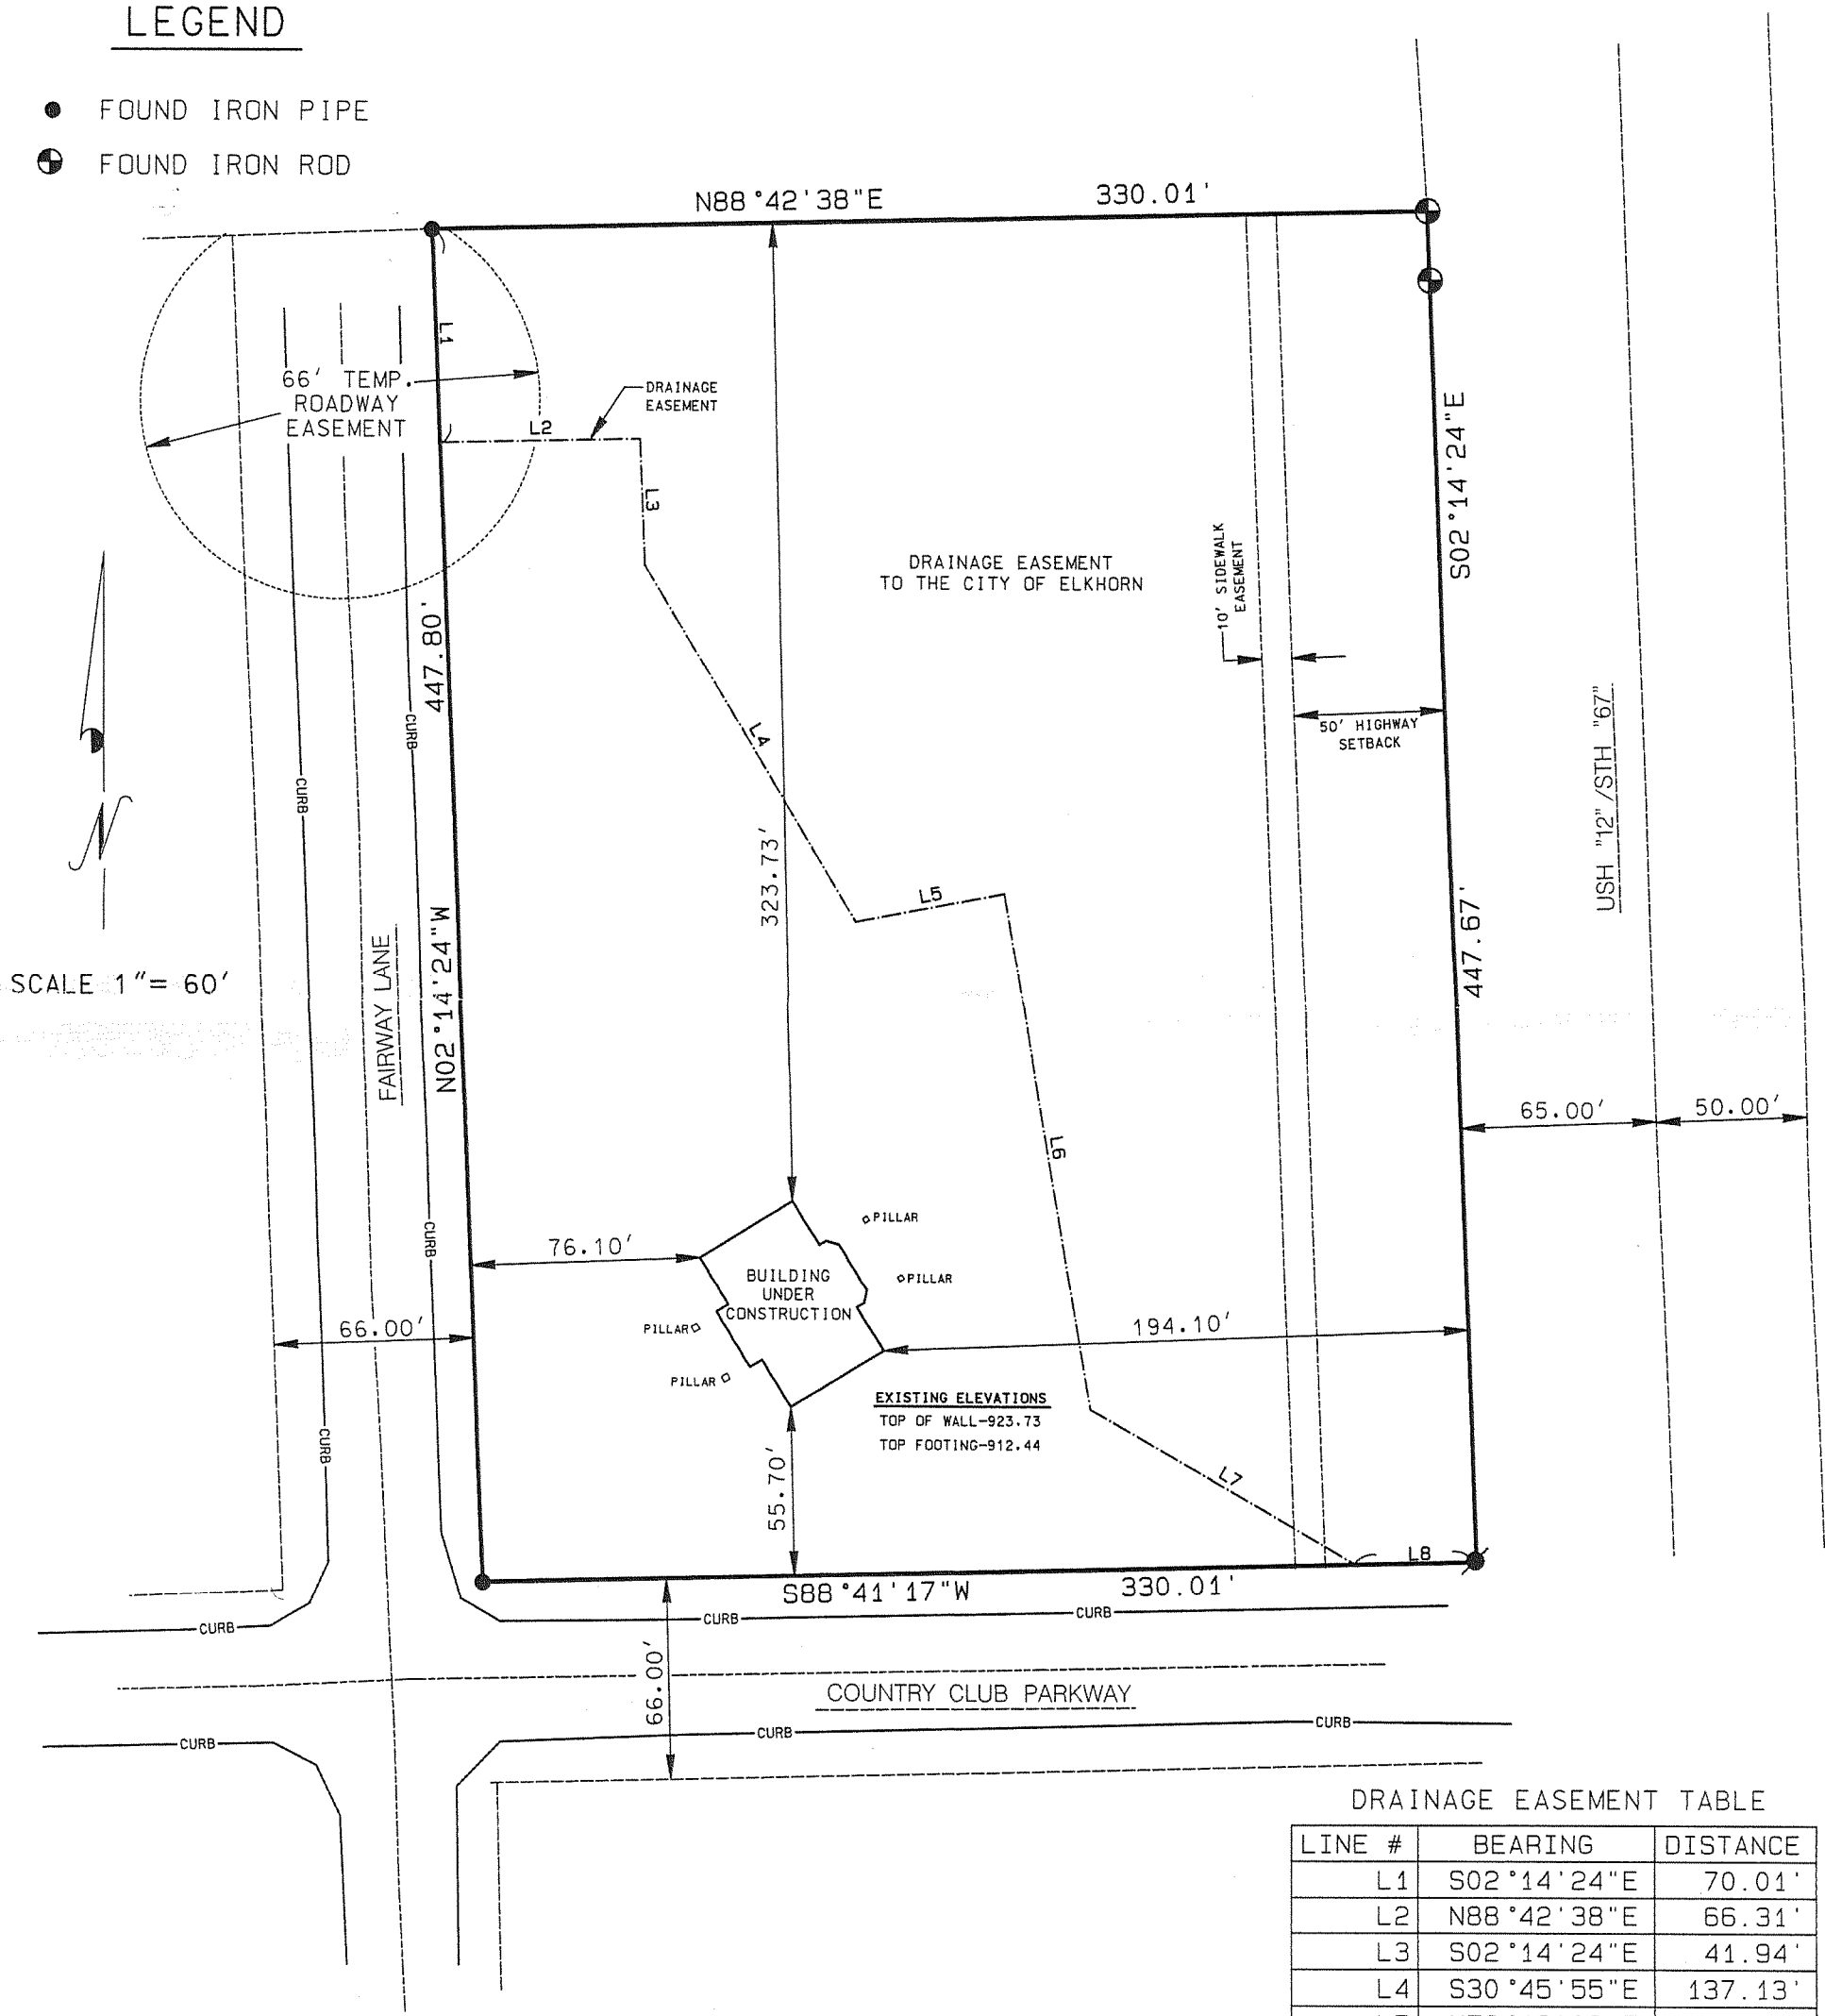


DRAINAGE EASEMENT TABLE

| LINE # | BEARING     | DISTANCE |
|--------|-------------|----------|
| L1     | S02°14'24"E | 70.01'   |
| L2     | N88°42'38"E | 66.31'   |
| L3     | S02°14'24"E | 41.94'   |
| L4     | S30°45'55"E | 137.13'  |
| L5     | N79°16'08"E | 50.36'   |
| L6     | S09°34'42"E | 173.47'  |
| L7     | S60°00'34"E | 101.92'  |
| L8     | N88°40'44"E | 40.00'   |

I MICHAEL A. GREESON R.L.S. # 2770 HEREBY CERTIFY THAT THIS SURVEY WAS MADE IN ACCORDANCE WITH THE MINIMUM STANDARDS FOR PROPERTY SURVEYS (CHAPTER A-E7) STATE OF WISCONSIN AND HAS BEEN PREPARED UNDER MY DIRECTION AND CONTROL AND IS CORRECT TO THE BEST OF MY KNOWLEDGE AND BELIEF.

*Michael A. Greeson*

MICHAEL A. GREESON, R.L.S. # 2770  
RSV# 04067RECERT.DGN

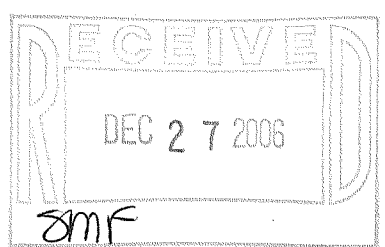

YFE1-5

004-2088