



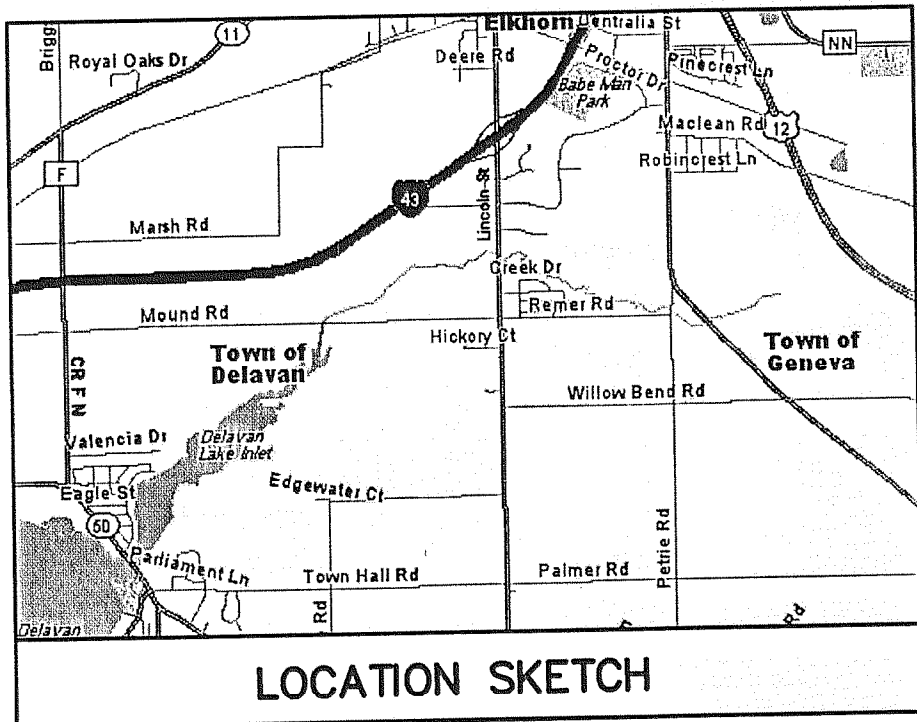

S.T.H. "67" VARIABLE WIDTH

ASSIGNED WEST LINE OF THE NW 1/4
SECTION 7, TOWN 2 NORTH,
RANGE 17 EAST, S 01°14'32" E

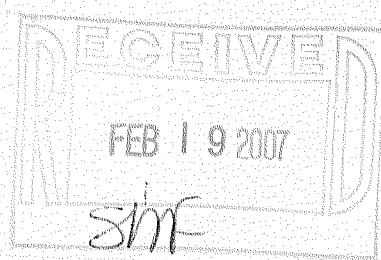


NOTE: COPIES OF THIS MAP TO WHICH THE FOLLOWING CERTIFICATE
WILL APPLY SHOW THE SURVEYOR'S ORIGINAL SEAL AND SIGNATURE
IN RED INK. COPIES BY ANY OTHER MEANS MAY HAVE ALTERATIONS
WHICH DO NOT REPRESENT THE SURVEYOR'S WORK PRODUCT.


I HEREBY CERTIFY THAT THE ABOVE DESCRIBED PROPERTY HAS BEEN
SURVEYED UNDER MY DIRECTION AND THAT THE ABOVE MAP IS A TRUE
REPRESENTATION THEREOF AND SHOWS THE SIZE AND LOCATION OF
THE PROPERTY AND ITS EXTERIOR BOUNDARIES. THIS SURVEY IS
MADE FOR THE USE OF THE PRESENT OWNERS OF THE PROPERTY, AND
ALSO THOSE WHO PURCHASE, MORTGAGE, OR GUARANTEE THE TITLE
THEREIN WITHIN ONE YEAR FROM THE DATE HEREOF.

DATED: JANUARY 17, 2007

PETER S. GORDON R.L.S. 2101

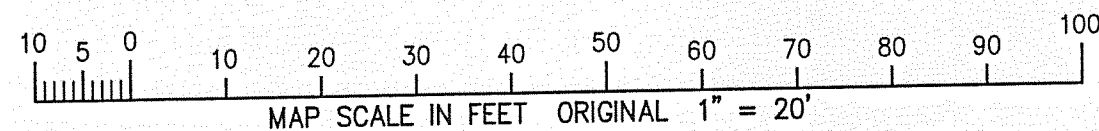


YA3861-1

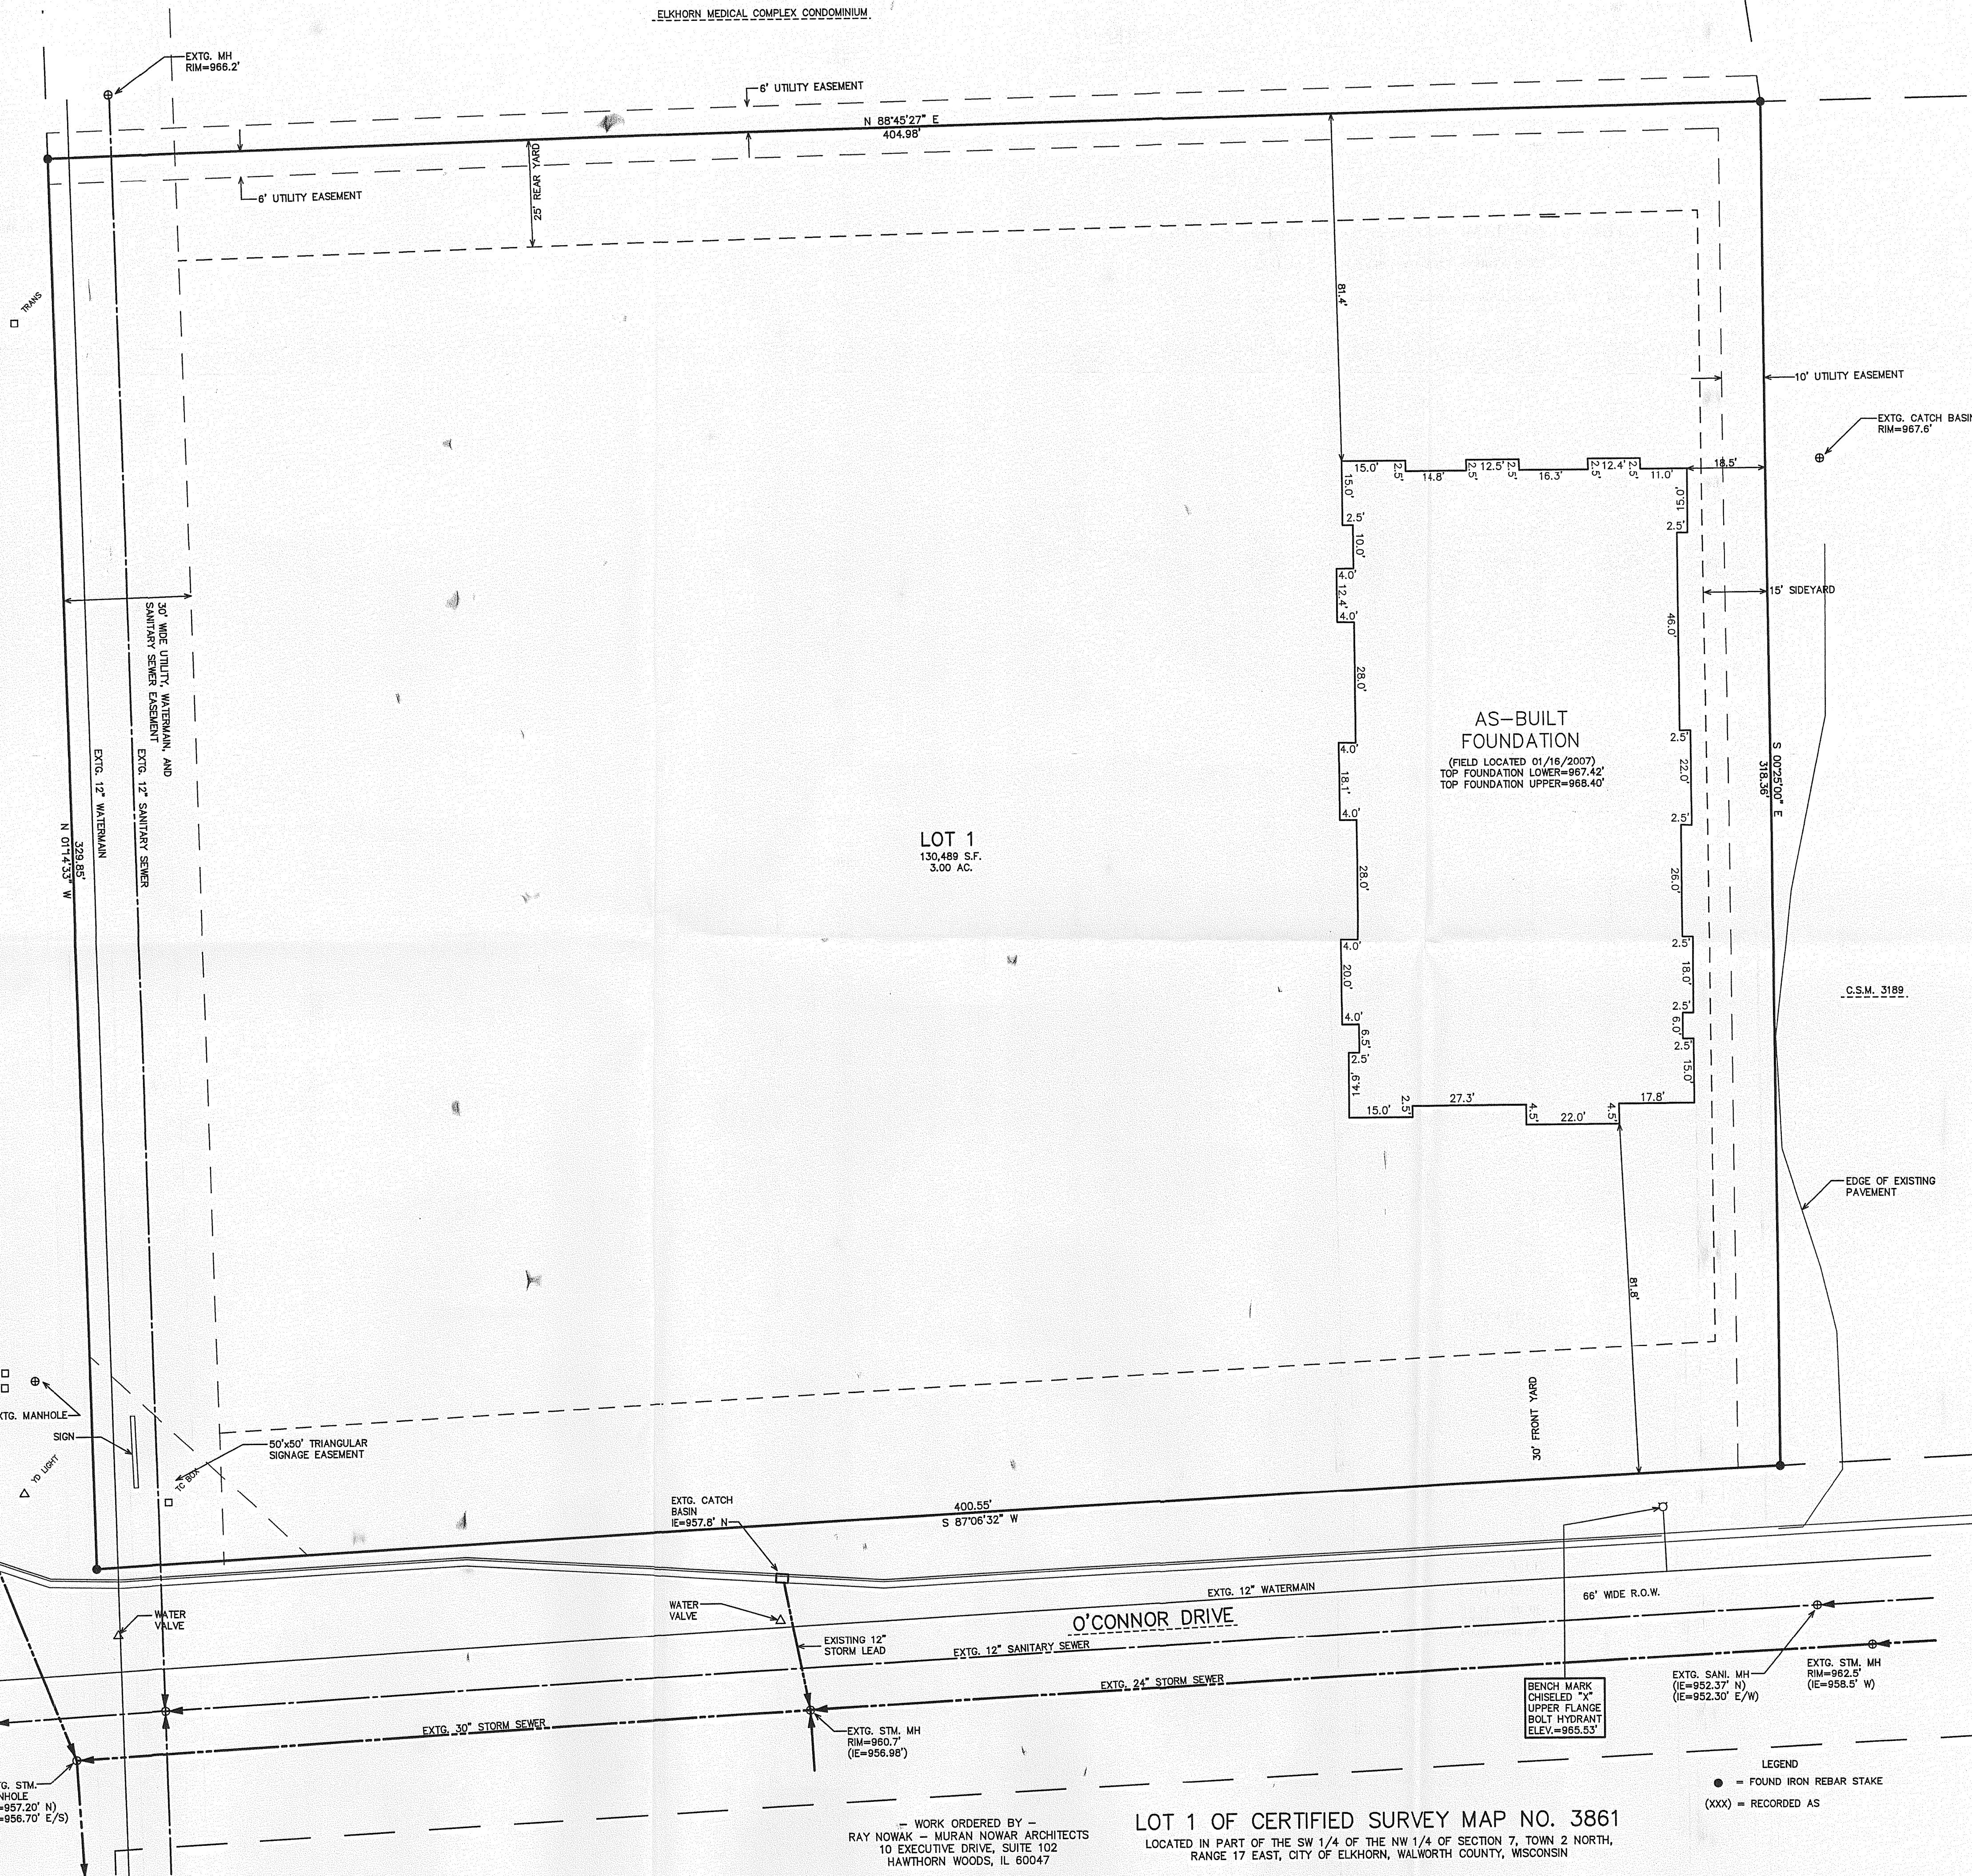

WORK ORDERED BY -
RAY NOWAK - MURAN NOWAK ARCHITECTS
10 EXECUTIVE DRIVE, SUITE 102
HAWTHORN WOODS, IL 60047

LOT 1 OF CERTIFIED SURVEY MAP NO. 3861
LOCATED IN PART OF THE SW 1/4 OF THE NW 1/4 OF SECTION 7, TOWN 2 NORTH,
RANGE 17 EAST, CITY OF ELKHORN, WALWORTH COUNTY, WISCONSIN

LEGEND
● - FOUND IRON REBAR STAKE
(xxx) = RECORDED AS

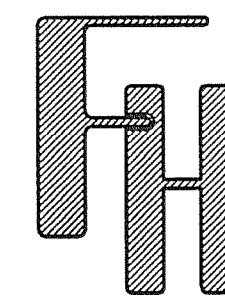

BUSINESS PARK PLAZA
CITY OF ELKHORN
WALWORTH COUNTY, WISCONSIN

AS-BUILT MAPPING

FARRIS, HANSEN & ASSOCIATES, INC.
ENGINEERING - ARCHITECTURE - SURVEYING
7 RIDGWAY COURT P.O. BOX 437
ELKHORN, WISCONSIN 53121
OFFICE: (262) 723-2098 FAX: (262) 723-5886

REVISIONS	
04/14/2006	MISC. ADVANCEMENT
05/04/2006	BS MISC. REVISIONS
05/10/2006	KD MISC. REVISIONS
05/31/2006	KD MISC. REVISIONS
09/05/2006	FJ MISC. REVISIONS
09/18/2006	FJ MISC. REVISIONS
01/17/2007	KD TO SHOW SIZE AND LOCATION OF AS-BUILT FOUNDATION BLDG. #2

PROJECT NO.
6906

DATE
12/22/05

SHEET NO.
1 of 1

004-2110