

PLAT OF SURVEY

BEING ALL OF LOT 33 OF HARVEST POINTE SOUTH, LOCATED IN THE SW 1/4 OF THE SW 1/4 OF SEC. 30, T.3N., R.17E., CITY OF ELKHORN, WALWORTH COUNTY, WI.




SURVEYOR
DAVID T. BOSSHARD, RLS 2641
YAGGY COLBY ASSOCIATES
501 MAPLE AVE., P.O. BOX 180500
DELAFIELD, WISCONSIN 53018
(262)646-6855

SURVEY FOR
BIELINSKI CUSTOM HOMES
N16 W23377 STONE RIDGE DRIVE
WAUKESHA, WI 53188

- LEGEND
- - 1" IRON PIPE FOUND
 - ⊙ - NAIL SET
 - - UTILITY BOX
 - ⊗ - CURB STOP
 - Ⓢ - MANHOLE
 - ⊕ - BENCHMARK (AS NOTED)

NOTE: THE MISSING LOT CORNER IRONS WERE NOT RESET AT THIS TIME PER THE CLIENT'S REQUEST. SIGNED LOT PIPE PLACEMENT WAIVER ON FILE IN ACCORDANCE WITH AE 7.01(2) OF ADMIN. CODE.

NOTE: THIS BUILDING LIES ON AT LEAST ONE MINIMUM SETBACK LINE.

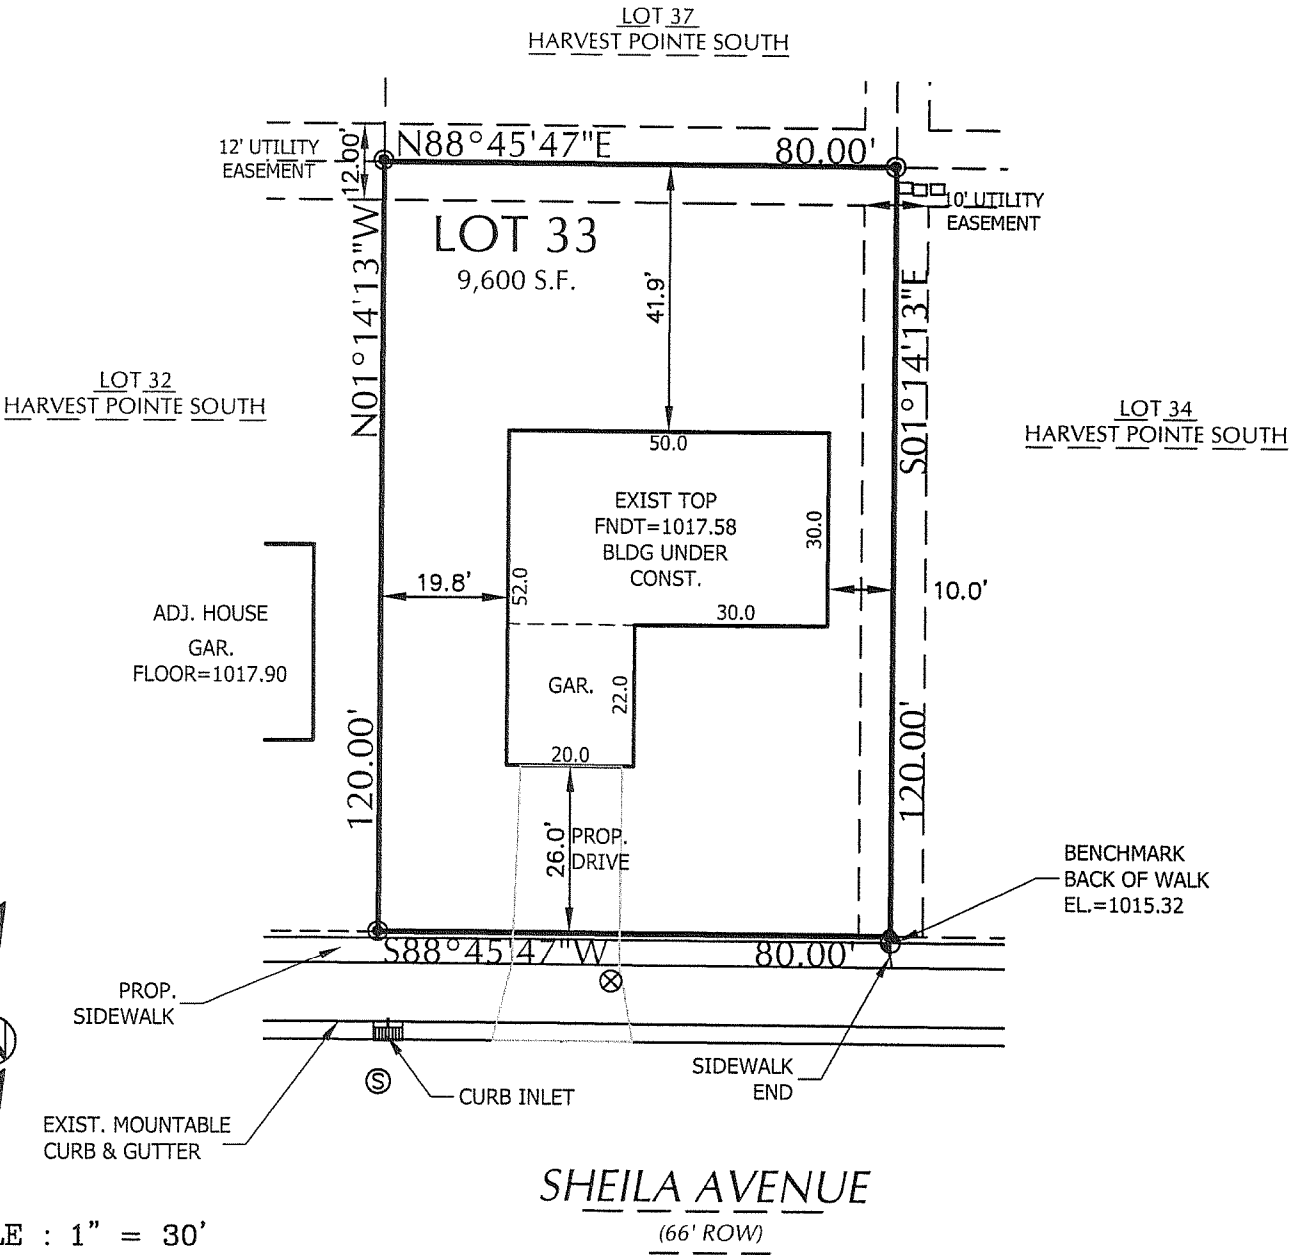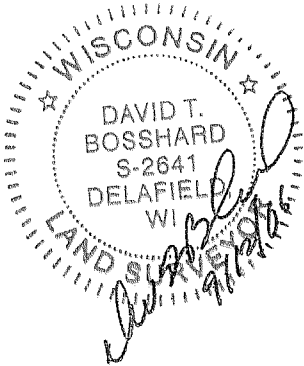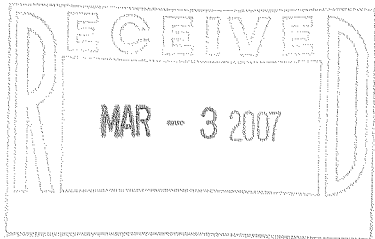

YHPS-33

004-2120