



MORTGAGE INSPECTION SURVEY

LOT 7 OF LANDMARK SUBDIVISION, CITY OF ELKHORN, WALWORTH COUNTY, WISCONSIN

NOTE: This is not a "Property Survey" as defined in Chapter AE 5.01 of the Wisconsin Administrative Code.

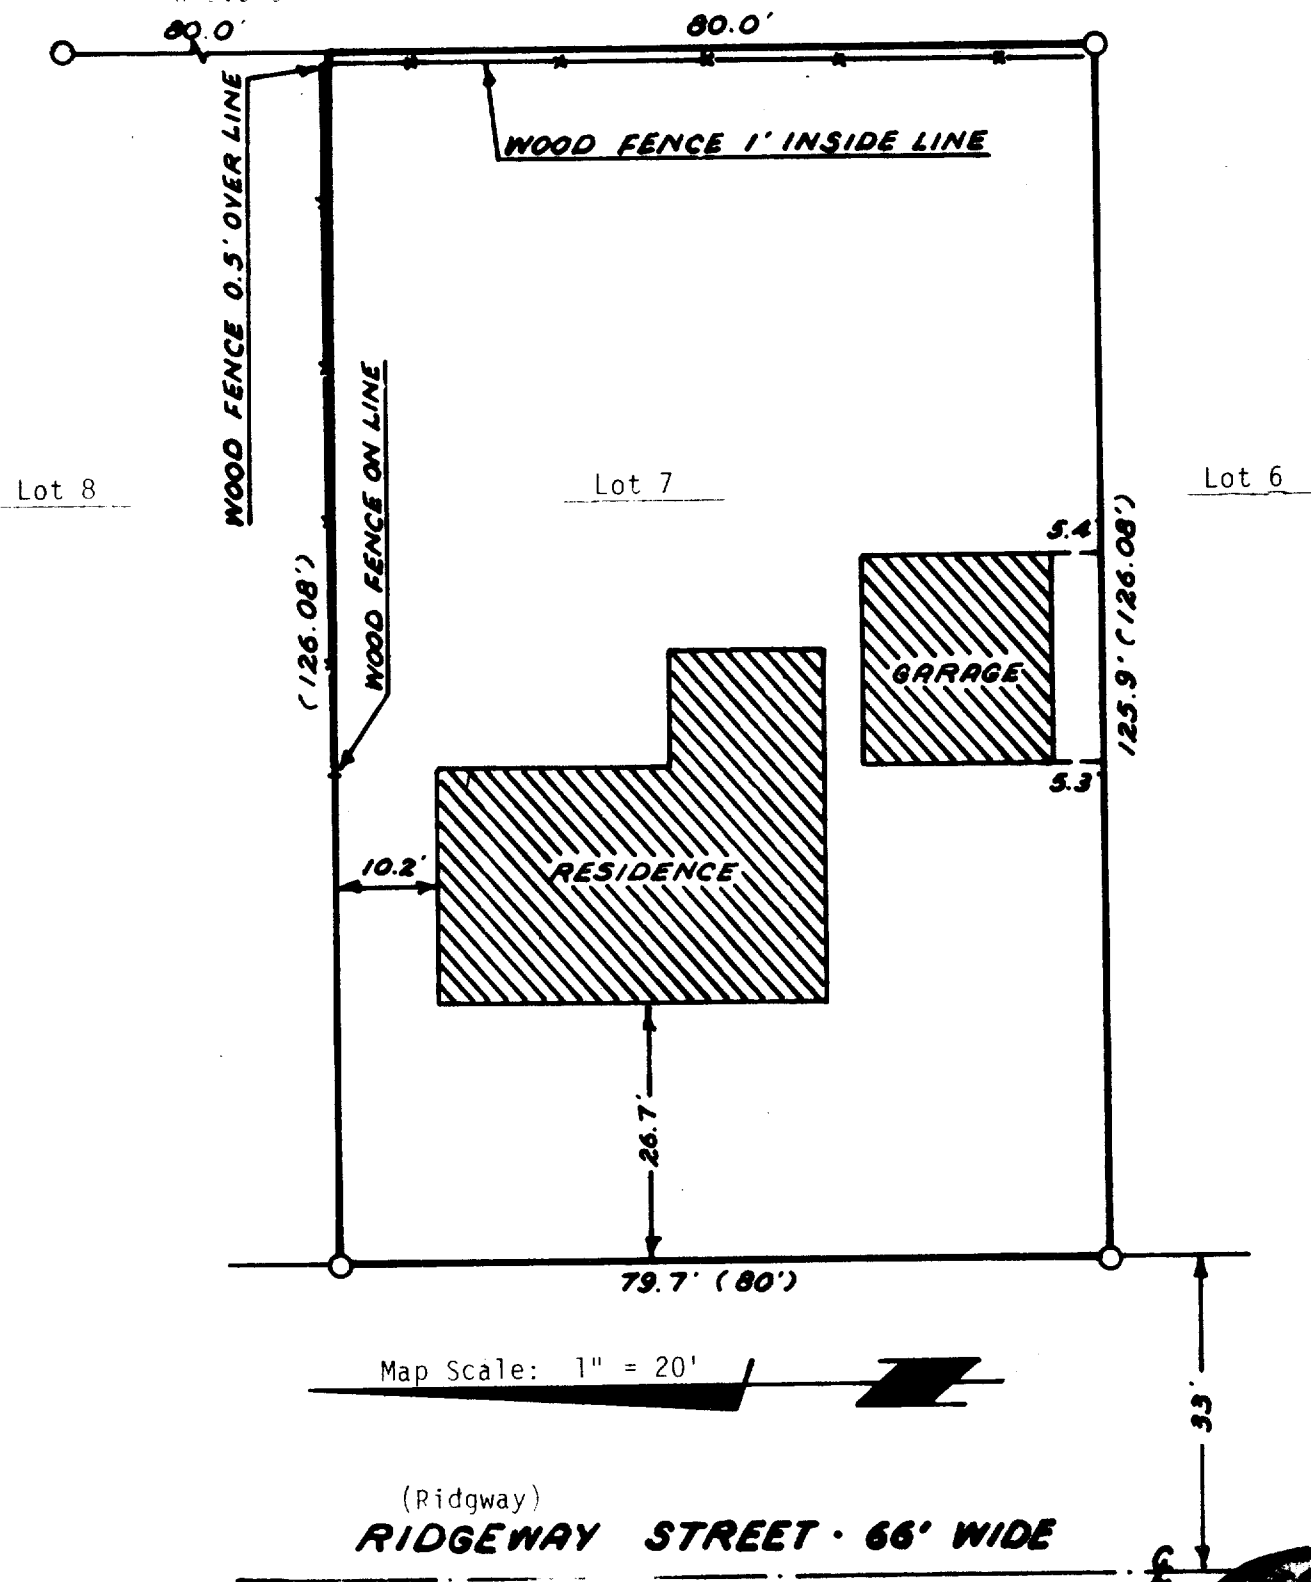

Buyers: Rodney E. Smith & Kelly Wilson
 Sellers: David & Katherine Knoblock
 Address: 27 Ridgway Street, Elkhorn, Wis.
 Work ordered by: Haukesha Savings & Loan Association

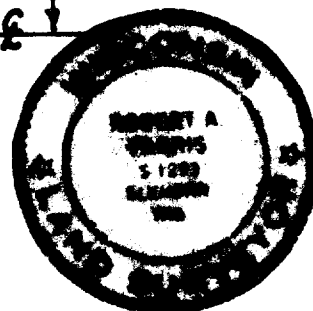

I HEREBY CERTIFY: That this map is a true representation of the lot lines and of the buildings located thereon to the best of my knowledge and belief.

○ = Eased Iron Pipe
 / = Record Dimension

Robert A. Farris
 Robert A. Farris RLS

Dated this 27th day of Aug. 1978

FARRIS, HANSEN & COOPER, INC
 ENGINEERING, SURVEYING & LAND PLANNING

115 N. WALWORTH ST. - 2ND. BOX 127 ELKHORN, WI 53121
 PHONE 414-733-2132

DRAWING NO. 1395

VLS-7

4-214