



Plat of Survey

of

A parcel of land described in a Special Warranty Deed recorded in Vol. 642 on Page 9055 as Document No. 337613, as shown below:

Commencing on the 1/4 line of Sec. 36 in Tsp. 3 N. R.16E. in the City of Elkhorn, County of Walworth and State of Wisconsin: Commencing 132 ft. N. of where the center line of Wisconsin Street crosses the said 1/4 line, running thence E. 20 rods to the center of Washington Street in said City, thence N. 66 ft. to a stake; thence W. 20 rods to a stake, thence S. 66 ft. to the place of beginning, excepting parcel described as: Starting at a point where the E. and W. 1/4 section line of Sec. 36, T.3N. R.16E. intersects the centerline of Wisconsin Street in the City of Elkhorn, go N. 132 ft. to a point; thence E. 198 ft. to the place of beginning; thence E. 132 ft. to the center of Washington Street; thence N. 66 ft. to a point; thence W. 132 ft. to a point; thence S. to the place of beginning, all in the City of Elkhorn, Walworth County, Wisconsin.

Surveyed for: Coldwell Banker, Leith & Associates  
102 North Wisconsin Street  
Elkhorn, Wisconsin. 53121

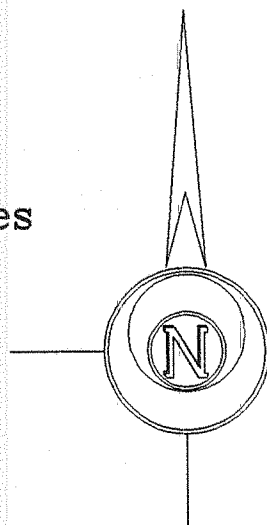
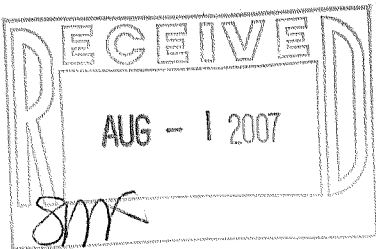


Bearings referenced to the Original  
Plat of the City of Elkhorn

First Avenue

North Wisconsin Street

Washington Street

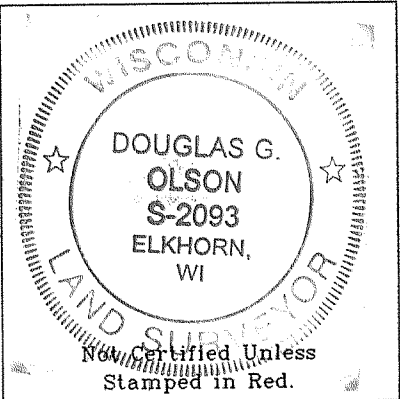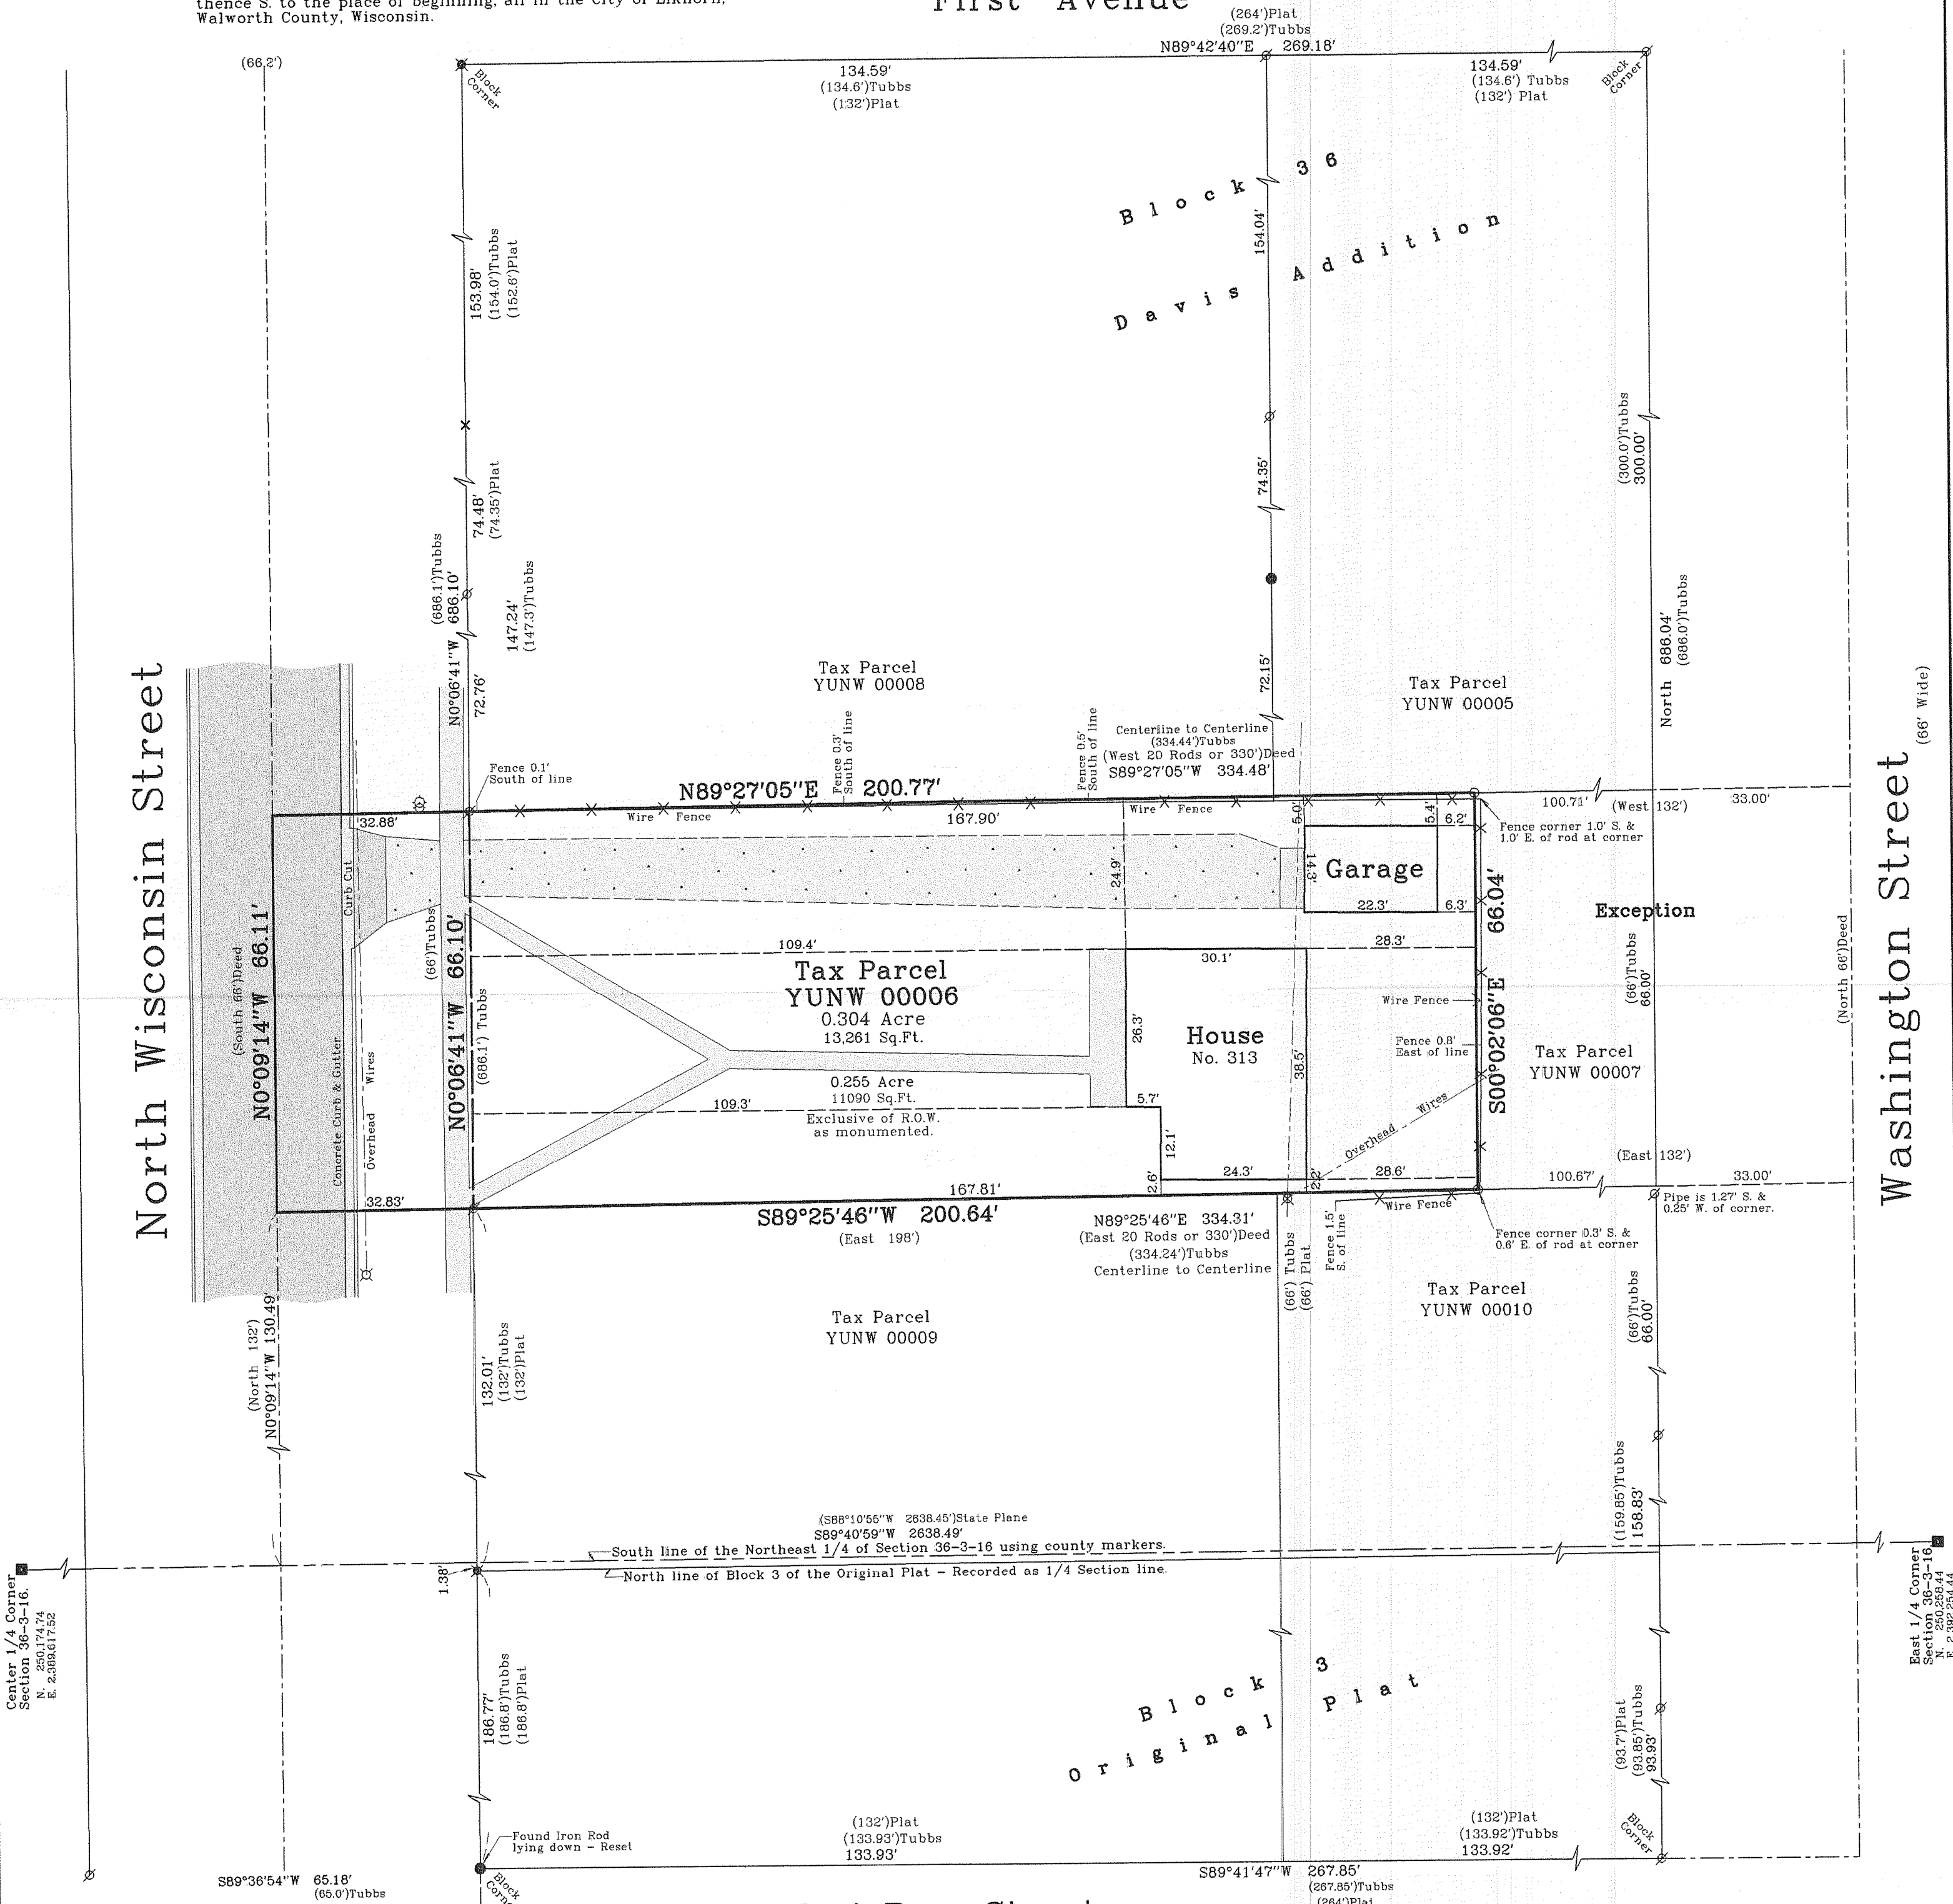

Copyright © 2006 by Jensen & Olson Land Surveying, LLC.

All rights reserved. No part of this survey plat may be reproduced or transmitted in any form by any means - graphic, electronic, or mechanical, including photocopying, tracing, or information storage and retrieval systems - without permission in writing from Douglas G. Olson, Jensen & Olson Land Surveying, LLC.

Notes:

- 1) This survey plat is not certified unless signed and sealed in red ink.
- 2) This survey is subject to Wisconsin lien laws. This Plat of Survey is the notice of intent to file lien. Lien waiver required.

I hereby certify that I have surveyed the above described property and the map hereon is correct to the best of my professional knowledge and belief and shows the size and location of the property, its exterior boundaries, the location and dimensions of all visible structures thereon, boundary fences, apparent easements and roadways and visible encroachments, if any.  
This survey is made for the exclusive use of the present owners of property, and also those who purchase, mortgage or guarantee title thereto, within one year from the date hereof.

Douglas G. Olson  
Wisconsin Registered Land Surveyor - 2093

Sheet 1 of 1 Sheets

Job Reference Number

2006.133

Legend


- Found Iron Pipe
- Found Iron Rod
- Found Spindle
- Found Chisel Cross Cut
- Recorded Information
- Utility Pole
- Hydrant
- Asphalt Surface
- Concrete Surface
- Found County Section Corner
- Set Iron Rod
- Water Valve
- Gravel

Jensen & Olson Land Surveying, LLC

45 South Wisconsin Street P.O. Box 322  
Elkhorn, Wisconsin. 53121  
Telephone (262) 723-3434  
Facsimile (262) 723-8044

Scale in Feet

1" = 20'

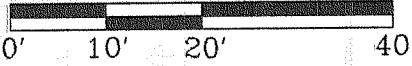

Survey Date: Nov. 20, 2006.

Revisions:

004-2151