


FARRIS, HANSEN & ASSOCIATES, INC.

ENGINEERING - ARCHITECTURE - SURVEYING
7 RIDGWAY COURT - P.O. BOX 437 - ELKHORN, WISCONSIN 53121
PHONE: (262) 723-2098 FAX: (262) 723-5886


BOUNDARY SURVEY & MONITORING WELL LOCATION

LOT 2 CSM 938
RECORDED IN VOL. 4, PG. 183, DOC. 46839
LOCATED IN THE NE 1/4 SECTION 36
TOWN 3 NORTH, RANGE 16 EAST, CITY OF ELKHORN
WALWORTH COUNTY, WISCONSIN

WORK ORDERED BY -
KONICEK ENVIRONMENTAL CONSULTING, LLC
1032 S. SPRING STREET
PORT WASHINGTON, WI. 53074

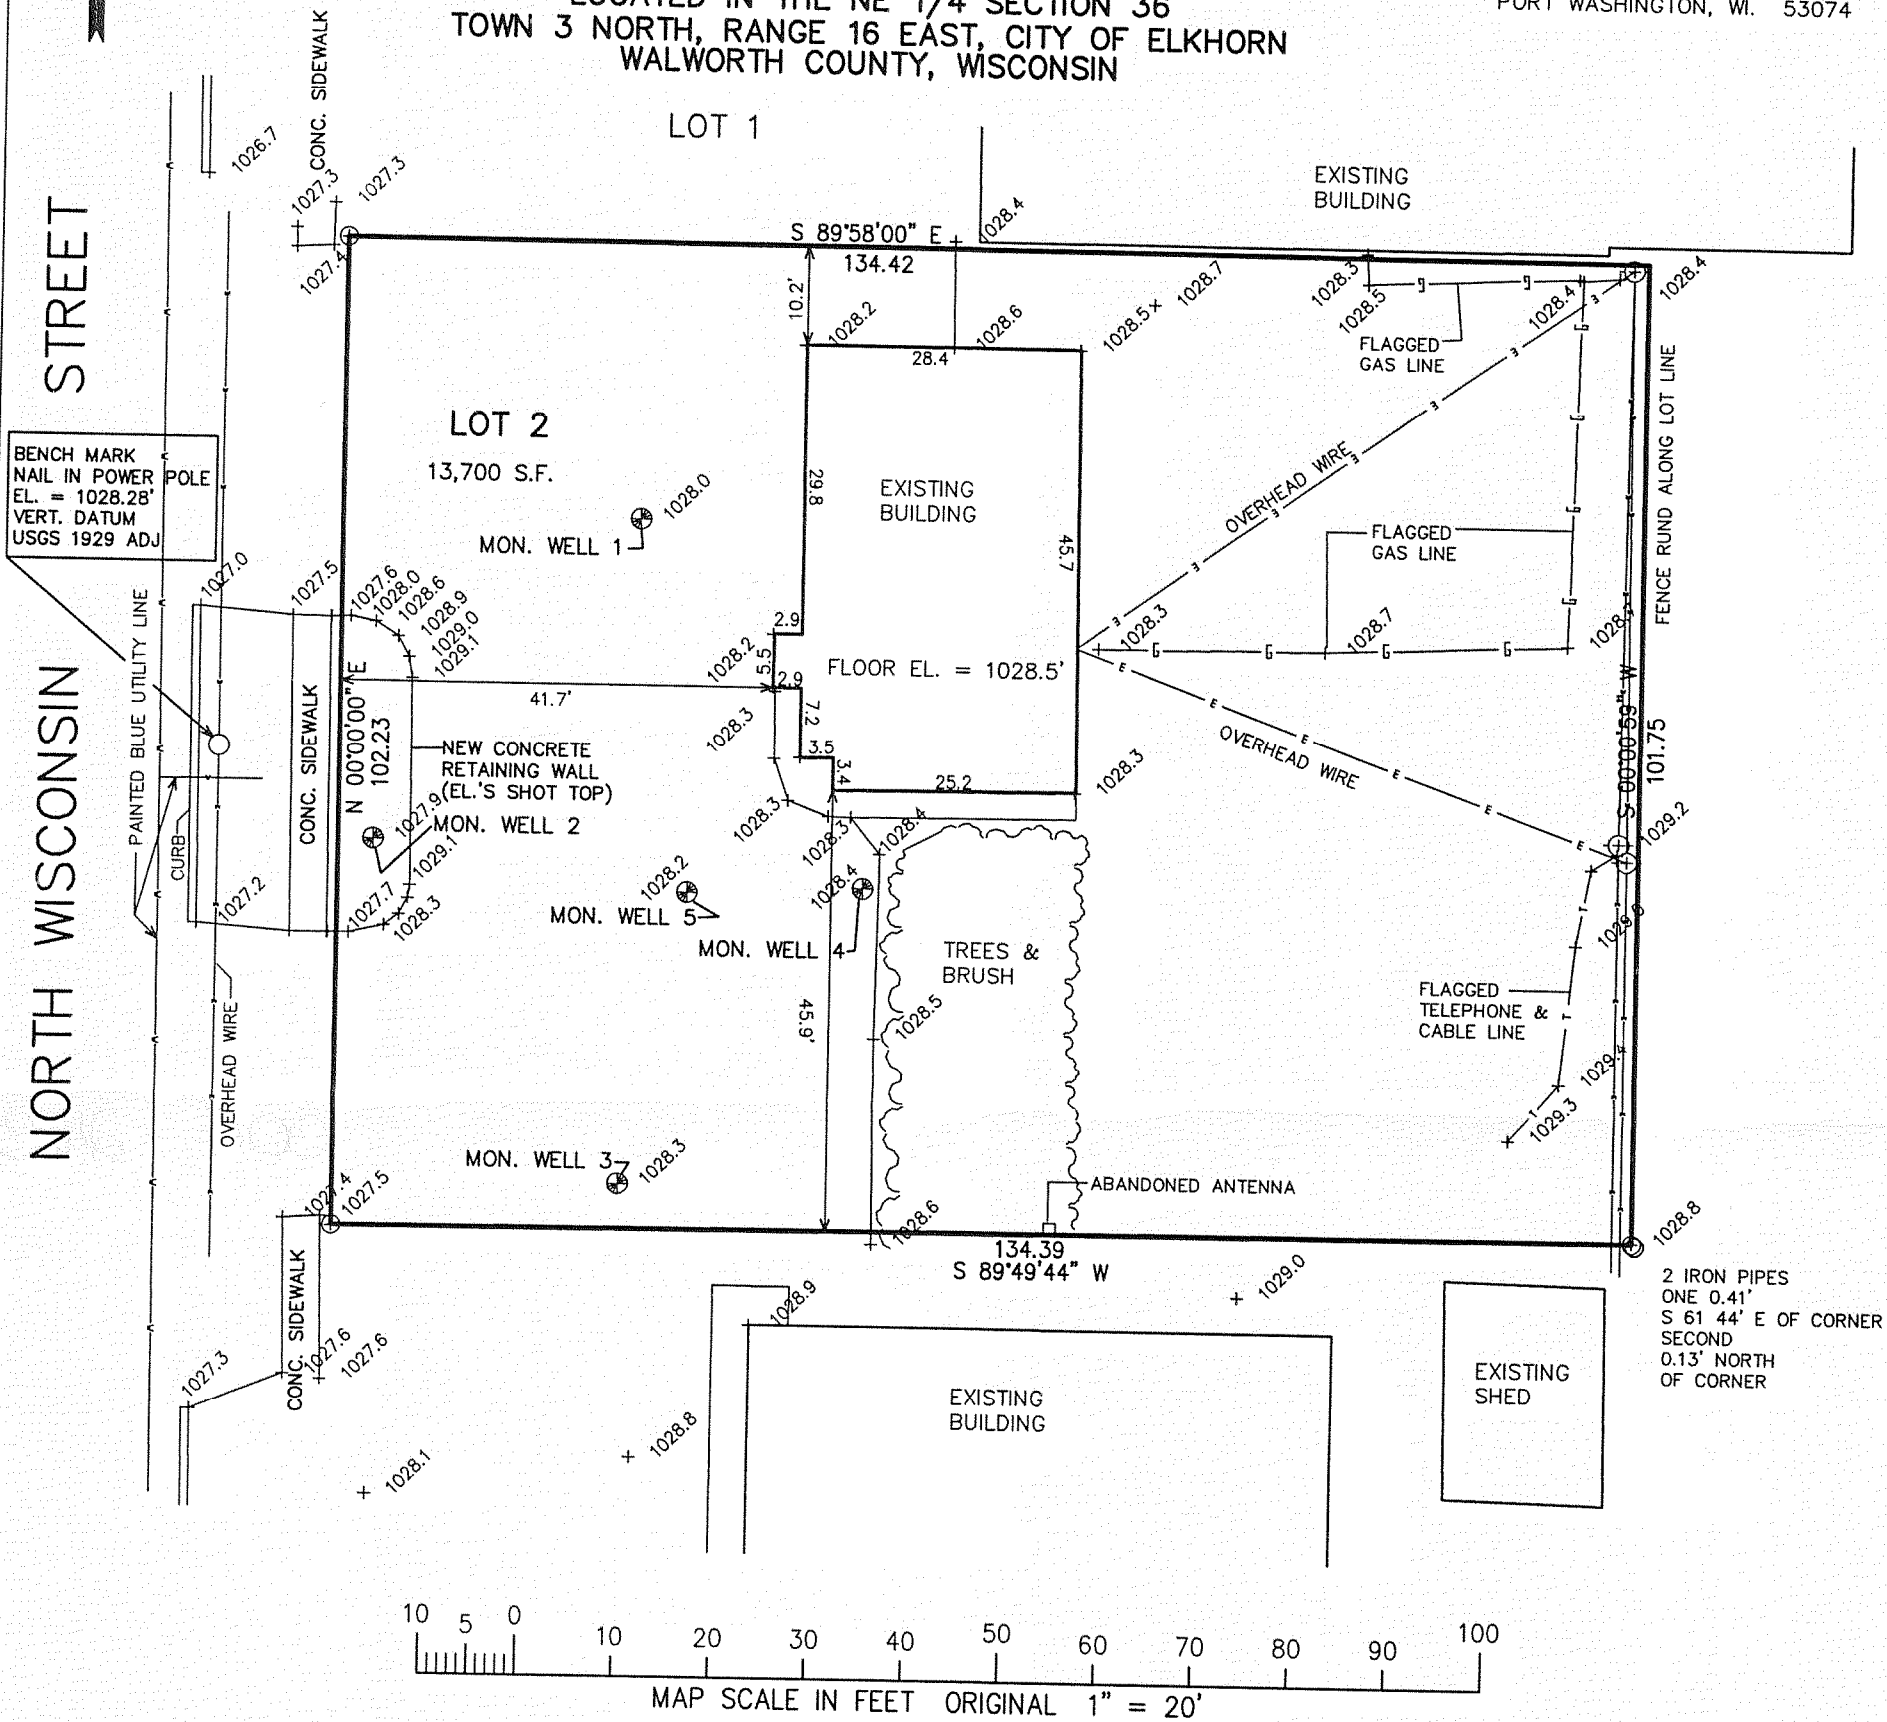

MONITORING WELL #	GROUND EL.	TOP PIPE EL.
1	1028.0'	1027.55'
2	1027.9'	1027.39'
3	1028.3'	1027.92'
4	1028.4'	1028.11'
5	1028.2'	1027.84'

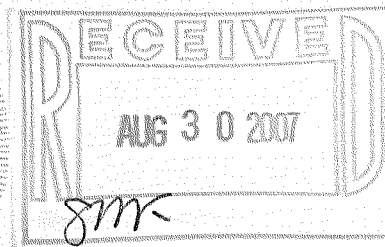

NOTE: COPIES OF THIS MAP TO WHICH THE FOLLOWING CERTIFICATE WILL APPLY SHOW SURVEYOR'S ORIGINAL SEAL AND SIGNATURE IN RED INK. COPIES BY ANY OTHER MEANS MAY HAVE ALTERATIONS WHICH DO NOT REPRESENT THE SURVEYOR'S WORK PRODUCT.

I HEREBY CERTIFY THAT THE ABOVE DESCRIBED PROPERTY HAS BEEN SURVEYED UNDER MY DIRECTION AND THAT THE ABOVE MAP IS A TRUE REPRESENTATION THEREOF AND SHOWS THE SIZE AND LOCATION OF THE PROPERTY AND ITS EXTERIOR BOUNDARIES. THIS SURVEY IS MADE FOR THE USE OF THE PRESENT OWNERS OF THE PROPERTY, AND ALSO THOSE WHO PURCHASE, MORTGAGE, OR GUARANTEE THE TITLE THERETO WITHIN ONE YEAR FROM THE DATE HEREOF.

DATED: AUGUST 3, 2007

Peter S. Gordon
PETER S. GORDON R.L.S. 2101

PROJECT: 4100.07
DATE: 08-03-2007
SHEET 1 OF 1

AUG 03 2007

YA 938-2

004-2163