



94-69

SOUTH CHURCH ST.

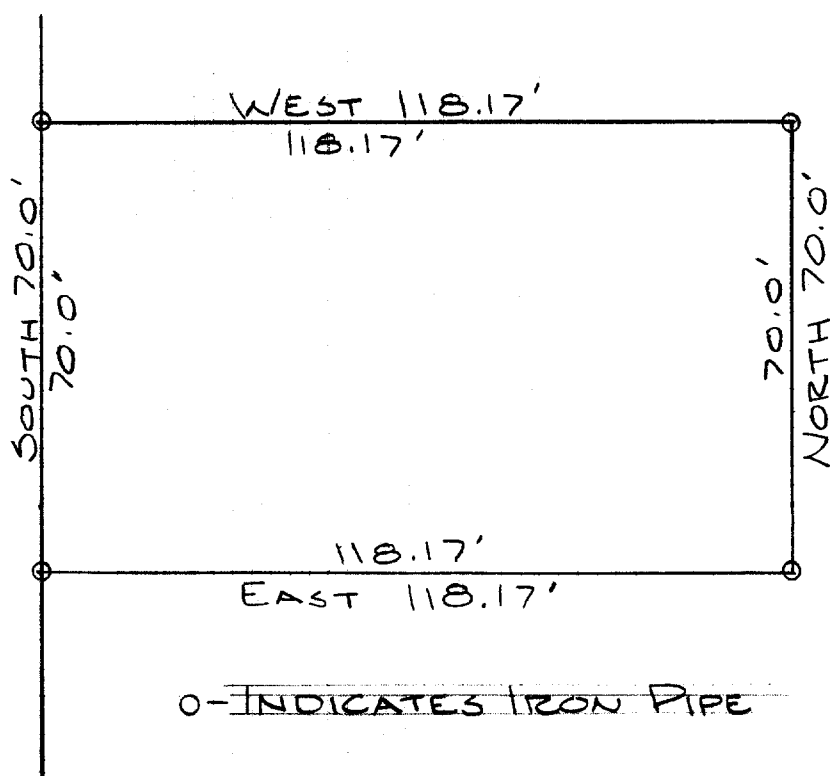

O-INDICATES IRON PIPE

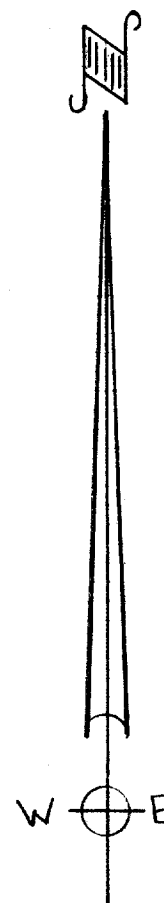


DESCRIPTION: Commencing at a point that is 208.00 feet North of the intersection of the North line of Centralia Street and the East line of Church Street in the City of Elkhorn, Walworth County, Wisconsin; thence East 118.17 feet, thence North 70.00 feet, thence West 118.17 feet to the East line of Church Street, thence South 70.00 feet to the place of beginning.

CERTIFICATE: I, James F. Biagi, surveyor, do hereby certify that I have surveyed the property hereon described.

June 25, 1969.

James F. Biagi
James F. Biagi, R.L.S. 272

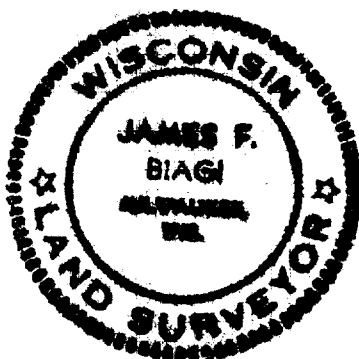

U-SW-46B

4-218B