


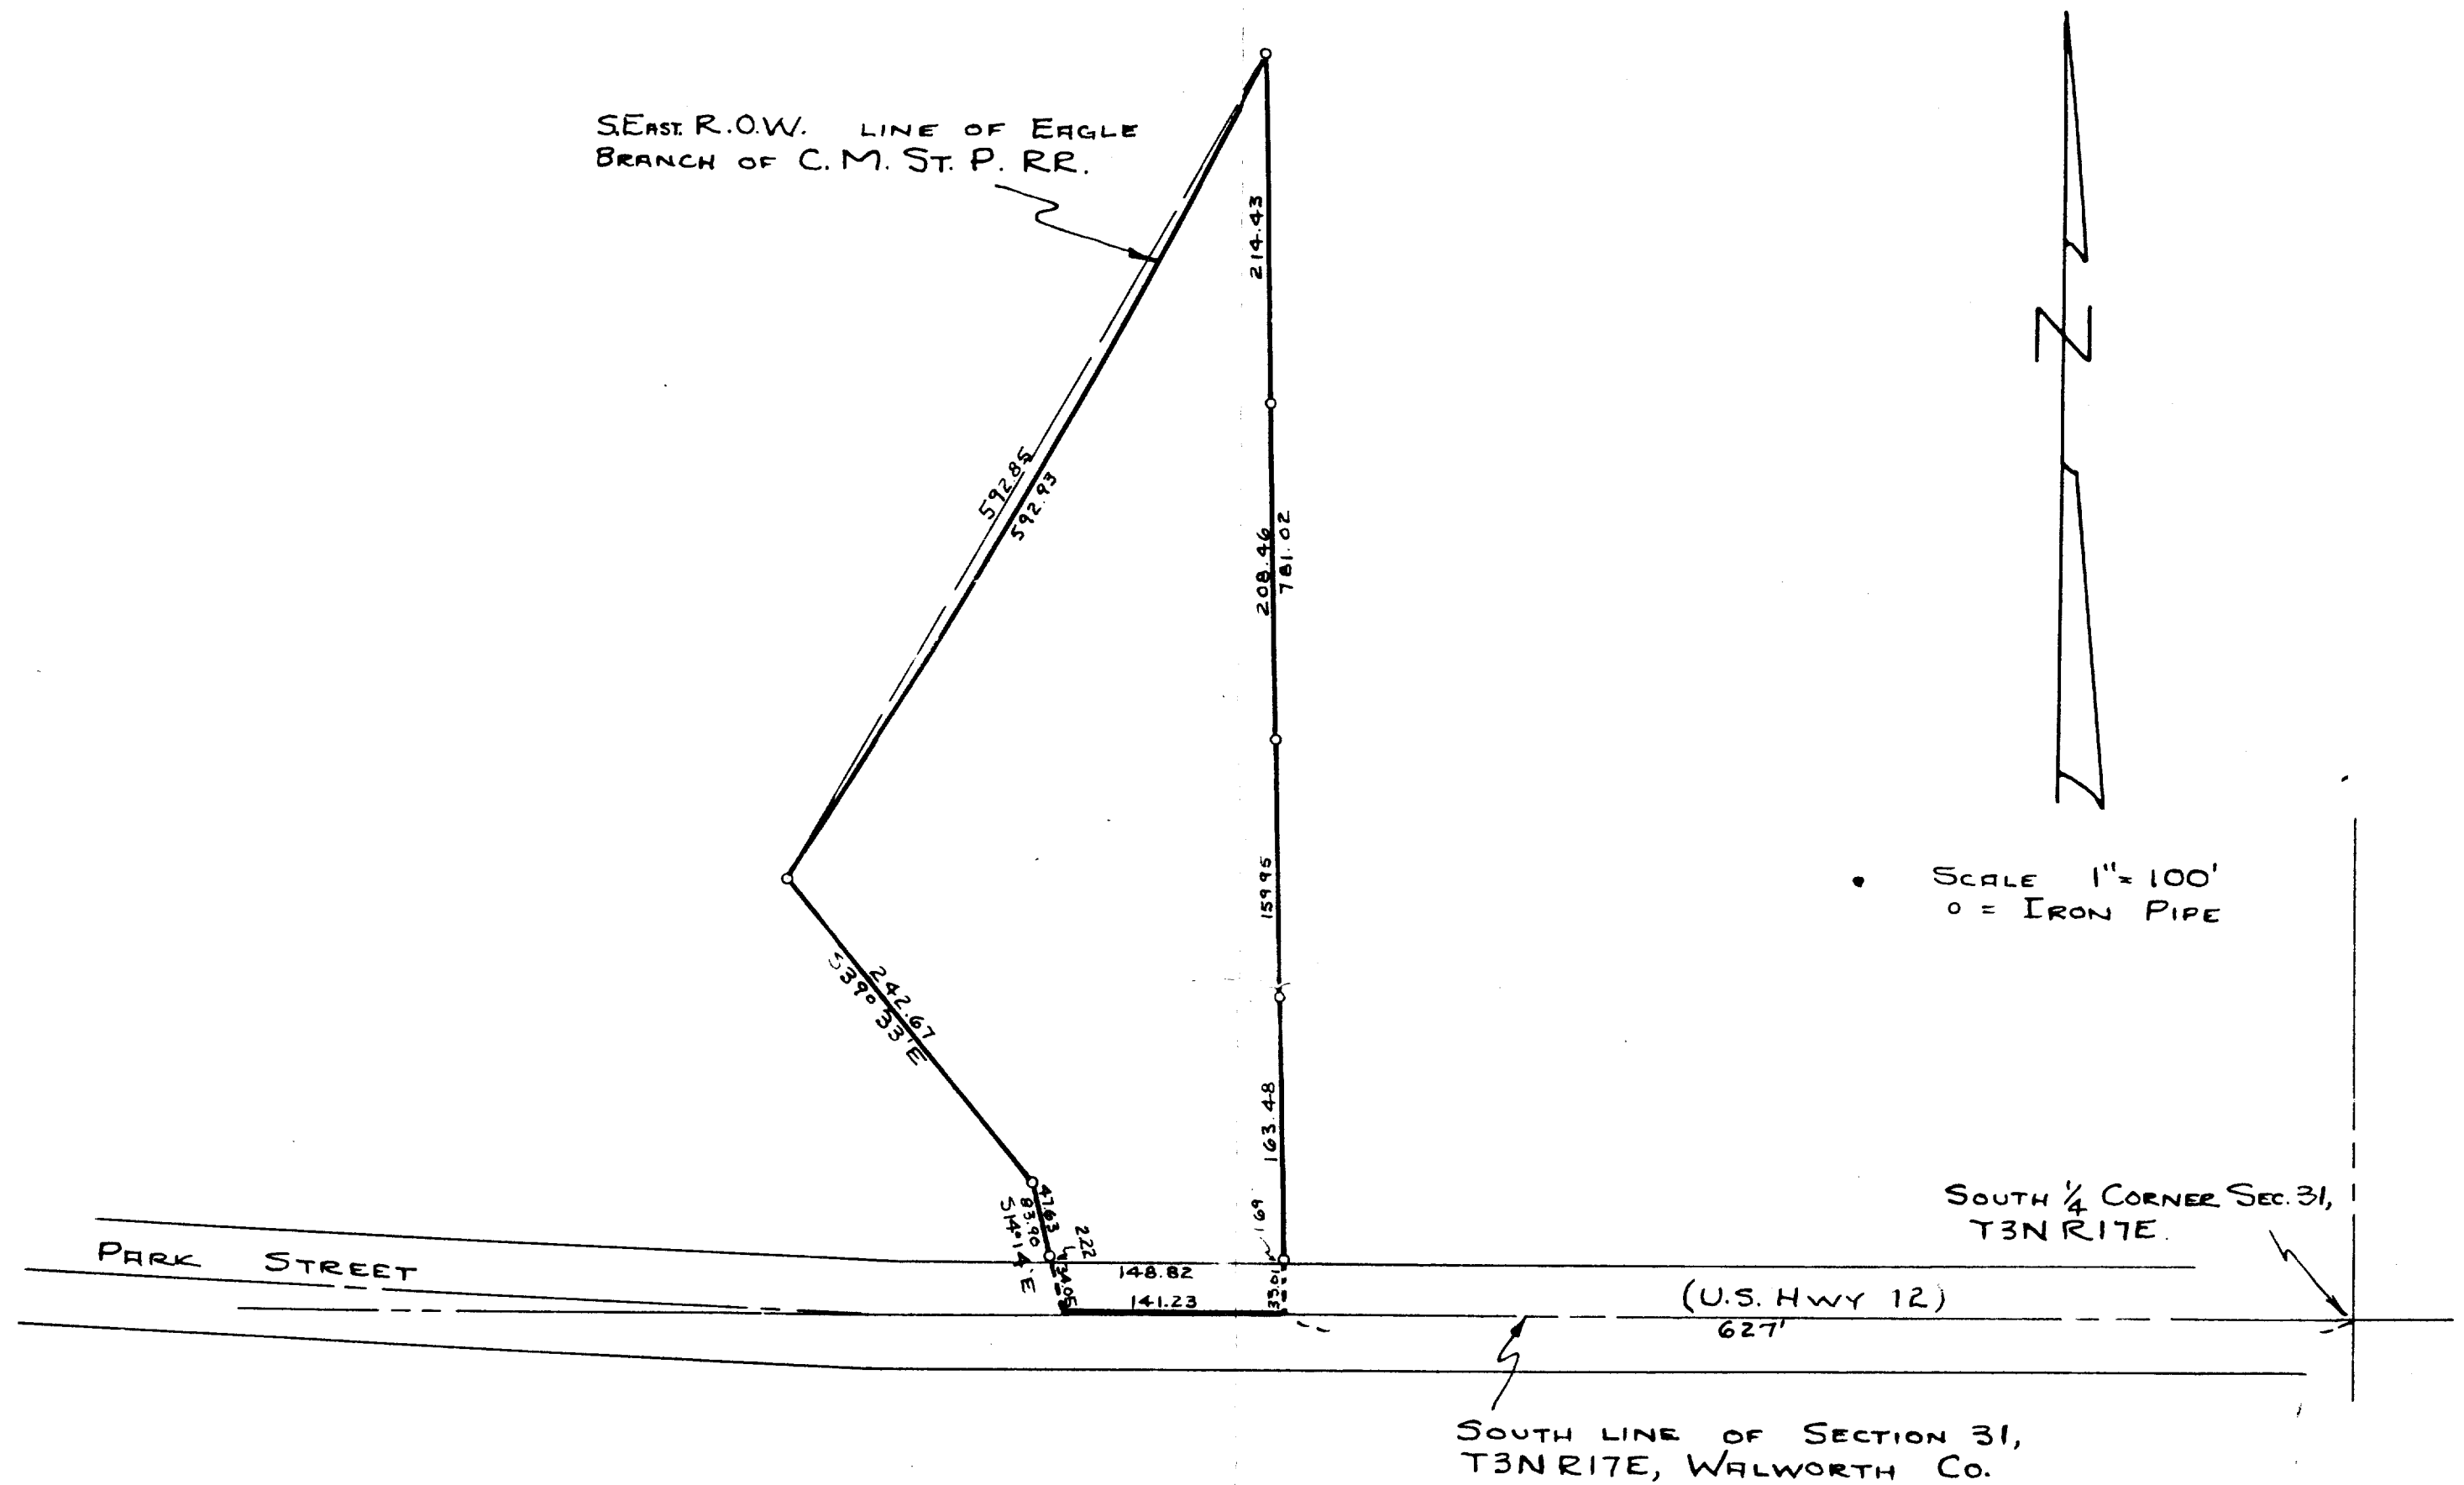

PLAT OF SURVEY OF LAND LOCATED IN THE SW 1/4 OF SEC-
TION 31, T3N R17E, IN THE CITY OF ELKHORN, WALWORTH
COUNTY, WISCONSIN.

DEC., 1949

Lloyd L. Jensen
COUNTY SURVEYOR

Yunz. 28, 28A

A-33 (part of)

4-21