


#83/10

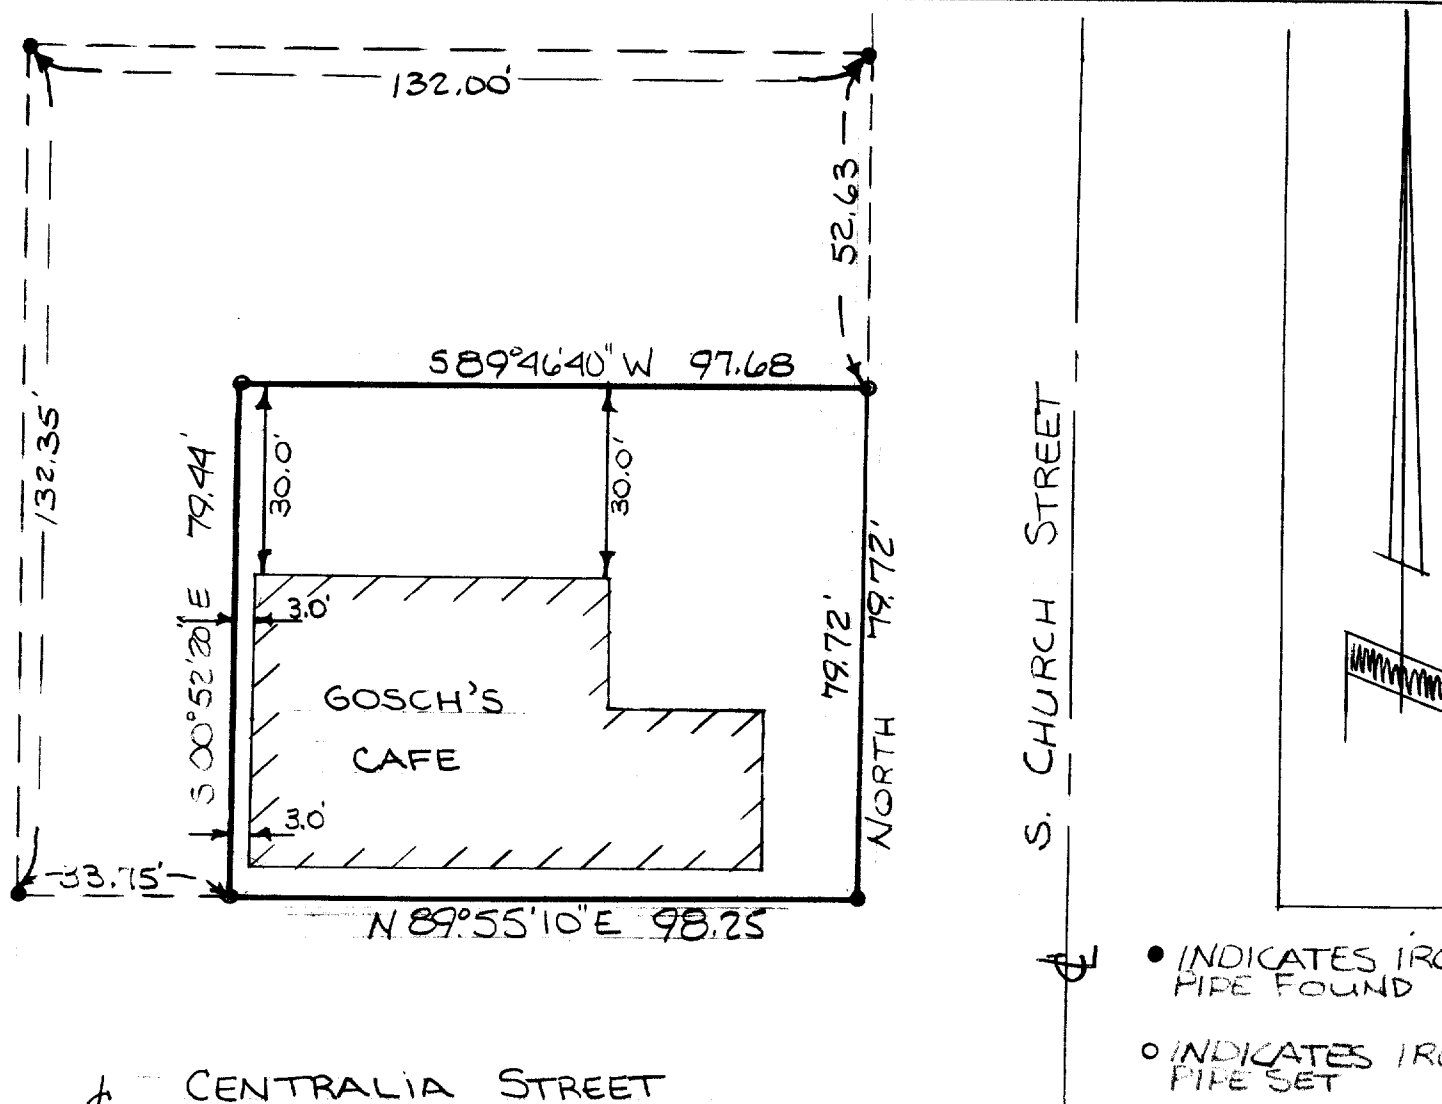

DESCRIPTION:

Commencing at the point of intersection of the North line of Centralia Street and the West line of South Church Street, thence North along the West line of said South Church Street 79.72 feet; thence S89°46'40"W 97.68 feet; thence S00°52'20"E 79.44 feet; to a point on the North line of said Centralia Street; thence N89°55'10"E 98.25 feet to the place of beginning.

CERTIFICATE:

I, James F. Biagi, surveyor, do hereby certify that I have surveyed the lands hereon described.

July 25, 1972

James F. Biagi

RLS#272

