
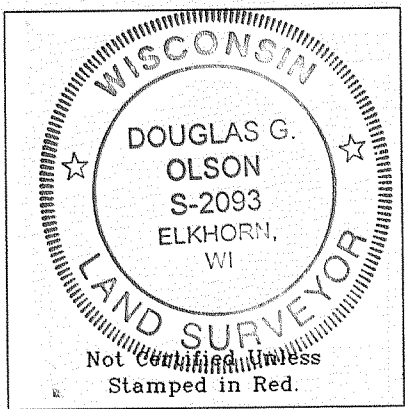


Plat of Survey

of

Lot 62 of Harvest Pointe,

a subdivision located in the Southwest 1/4 of Section 30,
Town 3 North, Range 17 East, City of Elkhorn,
Walworth County, Wisconsin.

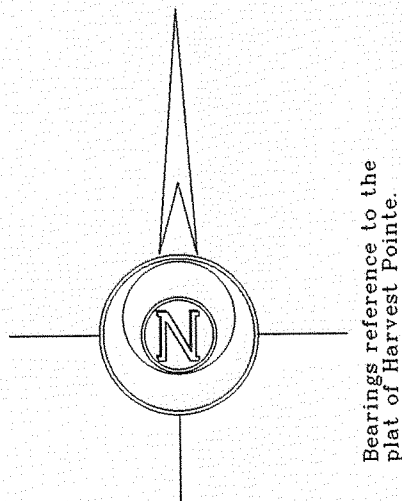

- Notes: 1) This survey plat is not certified unless signed and sealed in red ink.
- 2) This survey is subject to Wisconsin lien laws. This Plat of Survey is the notice of intent to file lien. Lien waiver required.

Copyright c 2008 by Jensen & Olson Land Surveying, LLC.


All rights reserved. No part of this survey plat may be reproduced or transmitted in any form by any means - graphic, electronic, or mechanical, including photocopying, tracing, or information storage and retrieval systems - without permission in writing from Douglas G. Olson, Jensen & Olson Land Surveying, LLC.

I hereby certify that I have surveyed the above described property and the map hereon is correct to the best of my professional knowledge and belief and shows the size and location of the property, its exterior boundaries, the location and dimensions of all visible structures thereon, boundary fences, apparent easements and roadways and visible encroachments, if any.


This survey is made for the exclusive use of the present owners of property, and also those who purchase, mortgage or guarantee title thereto, within one year from the date hereof.

Douglas G. Olson
Wisconsin Registered Land Surveyor - 2093

Surveyed for: Coldwell Banker, Leith & Associates
102 North Wisconsin Street
Elkhorn, Wisconsin. 53121

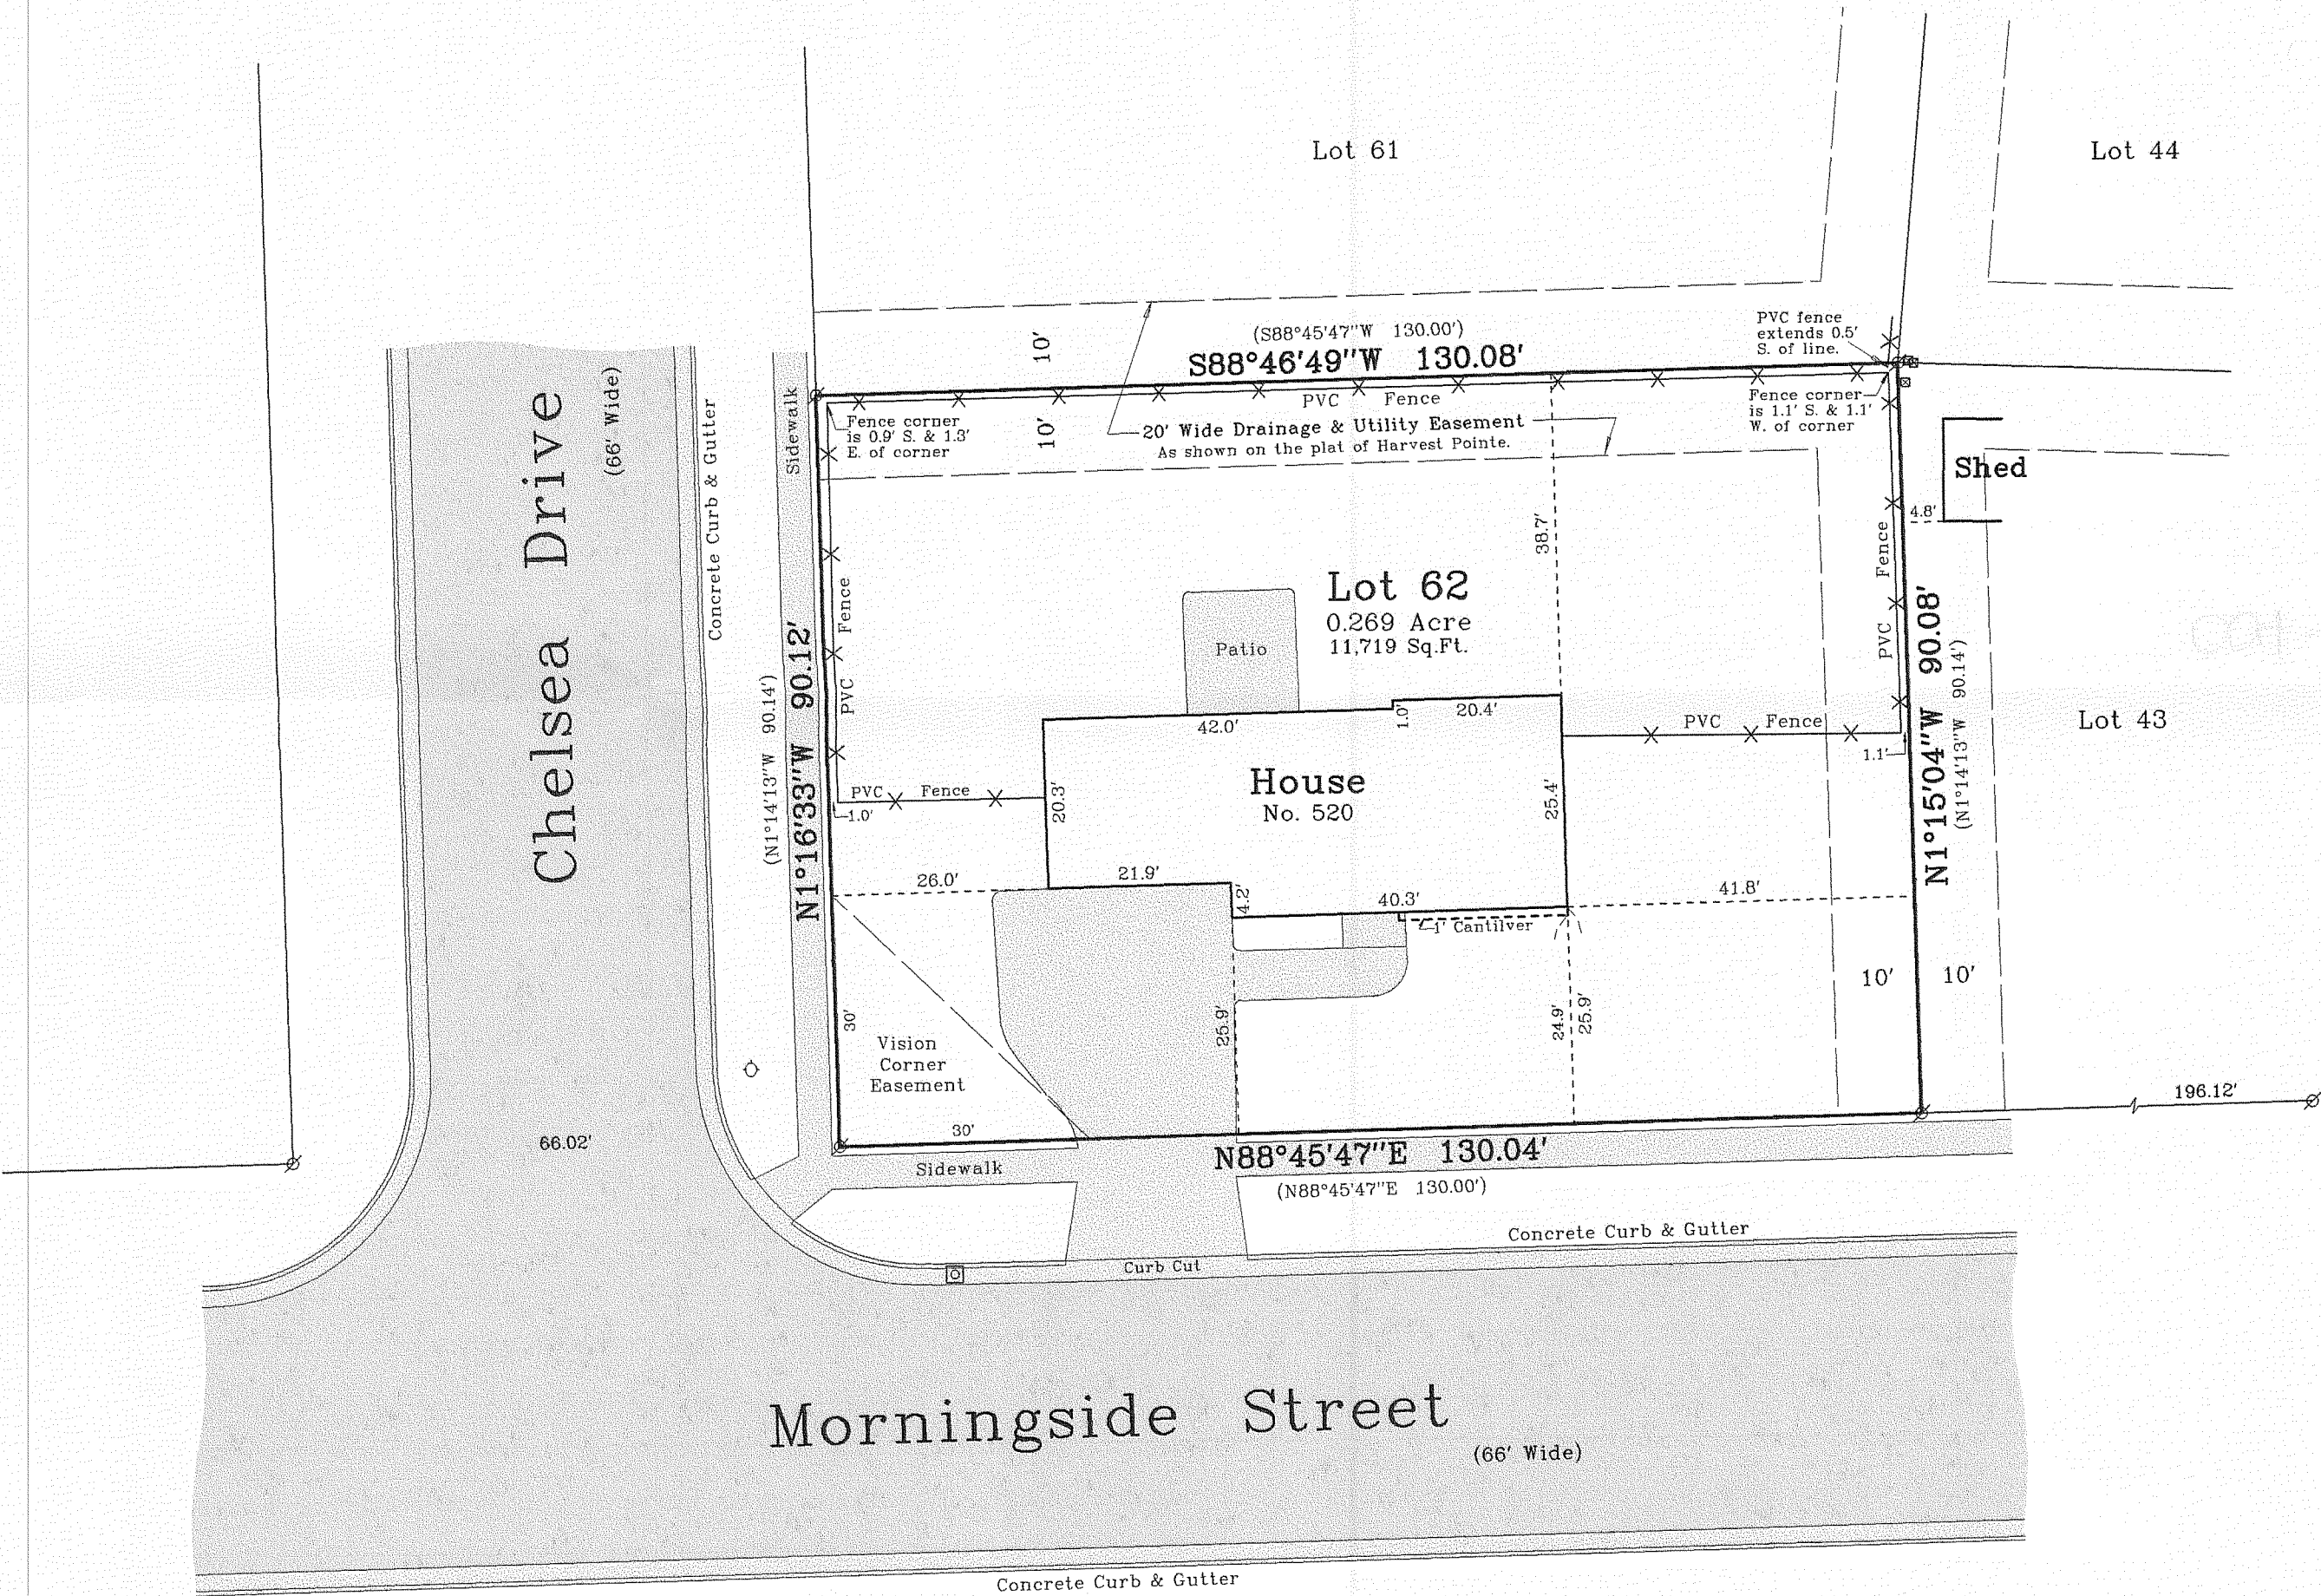

Survey Date: April 17, 2008.
Revisions:

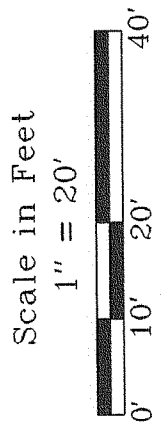

Jensen & Olson Land Surveying, LLC
45 South Wisconsin Street
Elkhorn, Wisconsin. 53121
Telephone (262) 723-3434
Facsimile (262) 723-8044
P.O. Box 322

- Legend
- Found Iron Pipe
 - Found 100d Spike
 - Set Iron Rod, 3/4" dia.
 - Recorded Information
 - Utility Pedestal
 - Catch Basin
 - Manhole
 - Asphalt Surface
 - Concrete

Sheet 1 of 1 Sheets
Job Reference Number
2008.042
2008.042

YHP- 62

004 - 2205