

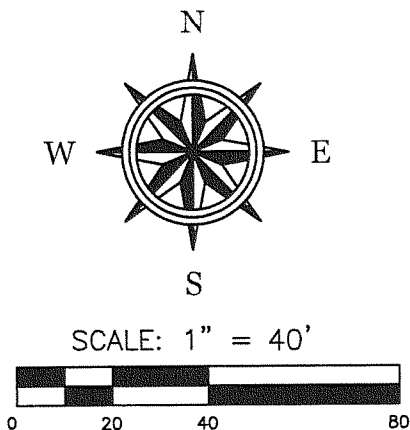
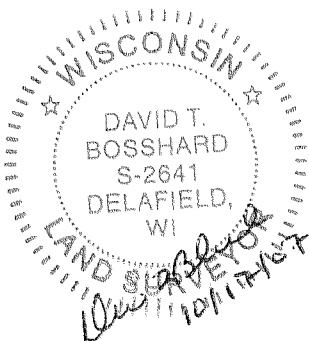


BUILDING 22 DETAIL

BEING A PART OF THE CONDOMINIUM PLAT OF HARVEST POINTE LOCATED
IN THE NW 1/4 OF THE SW 1/4 OF SECTION 30, TOWNSHIP 3 NORTH, RANGE 17
EAST, CITY OF ELKHORN, WALWORTH COUNTY, WISCONSIN.

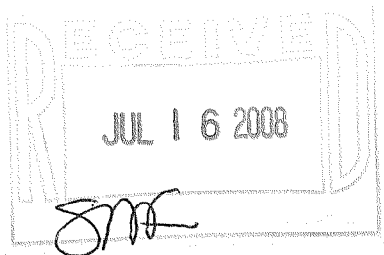

- LEGEND**
- Ⓜ - MAPLE HEART
 - ⊗ - CURB STOP
 - - UTILITY BOX
 - Ⓢ - MANHOLE

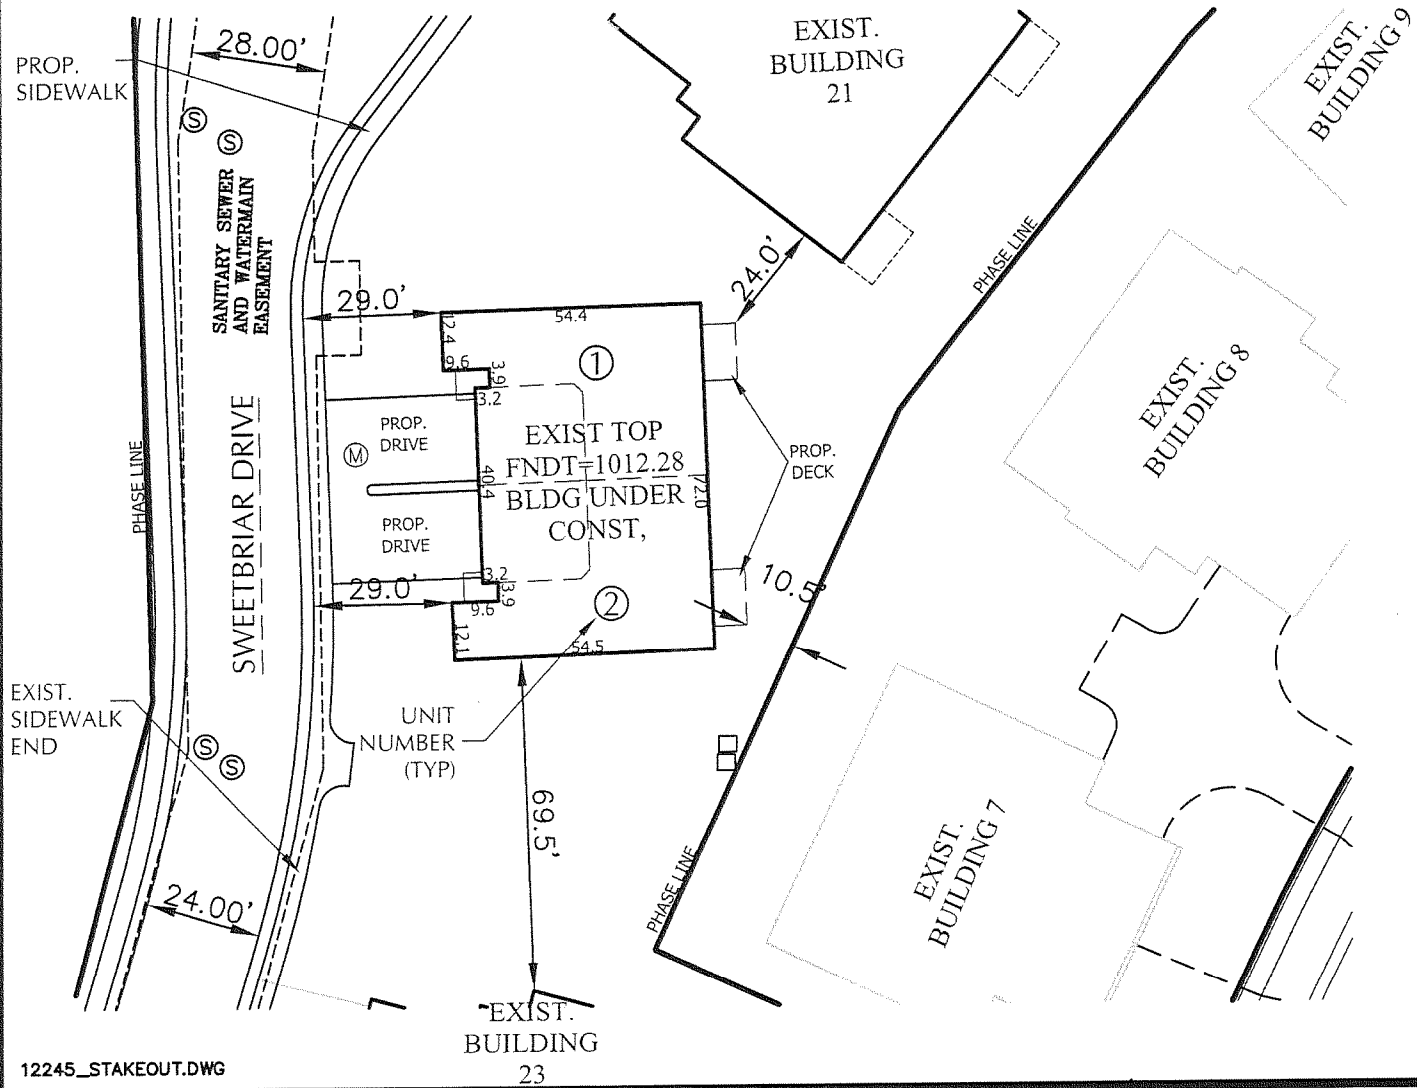

12245_STAKEOUT.DWG

P:\B12245.dwg(B12245.dwg, 10/16/2007 1:44:49 PM, 1st Floor 8150.pc3

YHPC3-11 YHPC3-12

004-2221