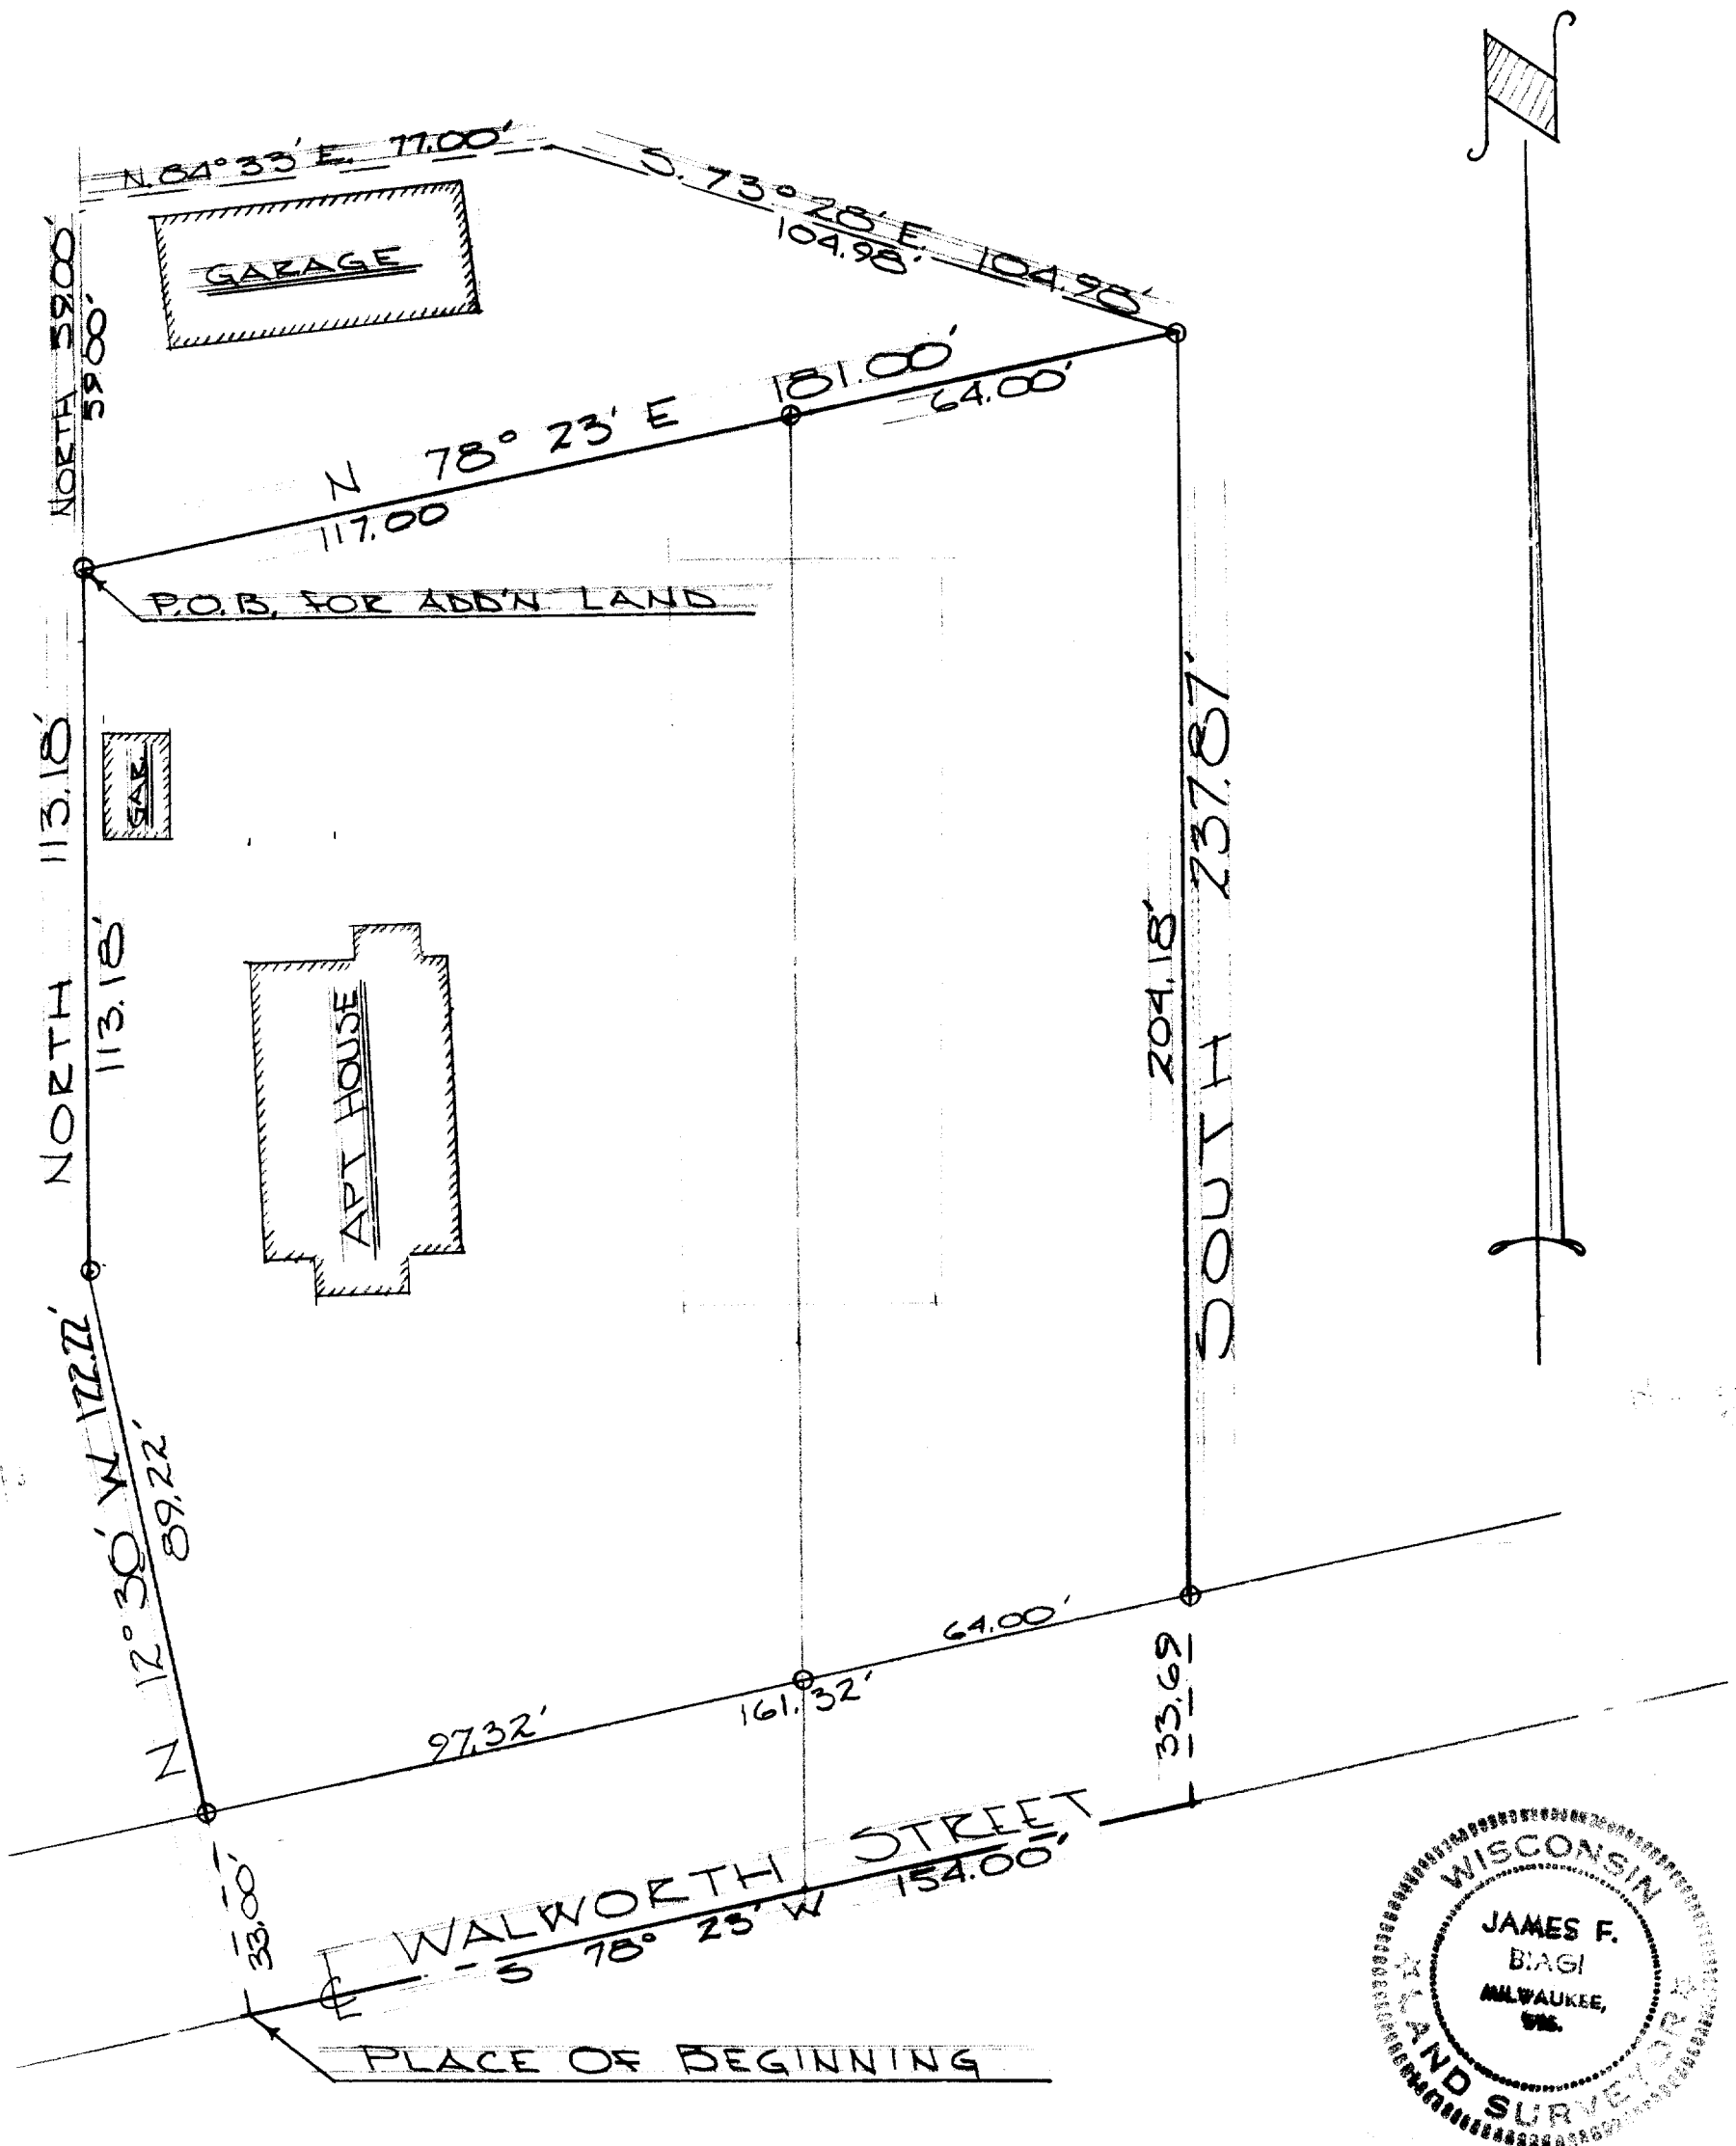


DESCRIPTION OF ORIGINAL TRACT:

Commencing at the SW corner of section 36, T. 3 N., R. 16 E. in the City of Elkhorn, Walworth County, Wisconsin; thence N. 88° 12' E. 49.50 feet, thence South 59.22 feet to the center line of Walworth Street, thence N. 78° 23' E. 758.00 feet to the place of beginning of the lands hereinafter described, to wit: thence N. 12° 30' W. 122.22 feet to an iron pipe, thence North 113.18 feet to an iron pipe, thence N. 78° 23' E. 181.00 feet to an iron pipe, thence South 237.87 feet to a point in the center line of Walworth Street, thence S. 78° 23' W. along the center line of said Street 154.00 feet to the place of beginning.

DESCRIPTION OF LANDS TO BE OBTAINED FOR GARAGE:

Commencing at the SW corner of Section 36, T. 3 N., R. 16 E. in the City of Elkhorn, Walworth County, Wisconsin; thence N. 88° 12' E. 49.50 feet, thence South 59.22 feet to the center line of Walworth Street, thence N. 78° 23' E. 758.00 feet, thence N. 12° 30' W. 122.22 feet, thence North 113.18 feet to the place of beginning of the lands hereinafter described, to wit: thence continue North 59.00 feet to an iron pipe, thence N. 84° 33' E. 77.00 feet to an iron pipe, thence S. 73° 28' E. 104.98 feet to an iron pipe, thence S. 78° 23' W. 181.00 feet to the place of beginning.

CERTIFICATE:

I, James F. Biagi, surveyor, do hereby certify that I have surveyed the property hereon described.

December 16, 1967.

James F. Biagi, RLS 272