

LAND-MARK SURVEYING

Mark L. Miritz

Wisconsin Registered Land Surveyor S-2582


N9330 Knuteson Drive
Whitewater, WI 53190
Phone: (262) 495-3284
FAX : (262) 495-8421
LAND-MARKSURVEYING.COM

PLAT OF SURVEY

LOT 11, BLOCK 41 OF DAVIS ADDITION, LOCATED
IN THE NORTHEAST 1/4 SECTION 36, TOWN 3
NORTH, RANGE 16 EAST, CITY OF ELKHORN,
WALWORTH COUNTY, WISCONSIN.

ORDERED BY: SIGMA ENVIRONMENTAL SERVICES
PROJECT MANAGER- STEVE MEER
1300 W. CANAL STREET
MILWAUKEE, WI 53233

SIGMA PROJECT NO. 10359

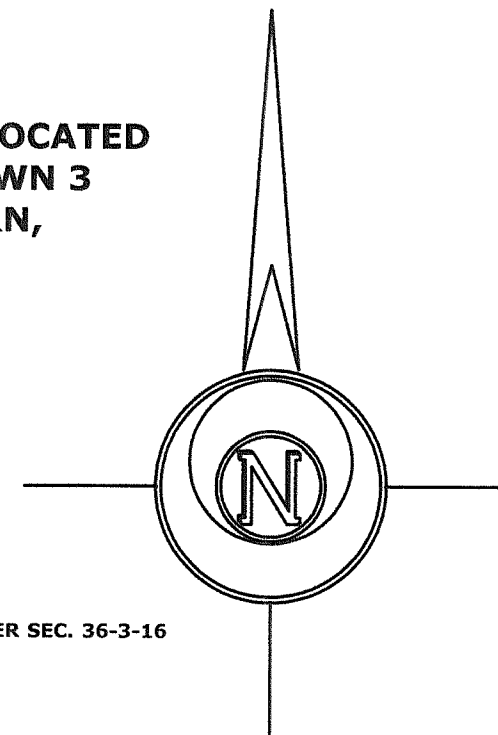

Horizontal Datum is based on the
Wisconsin State Plane Coordinate
System Grid, South Zone, North
American Datum of 1927, all
bearings are referred to Grid
North. The East line of the NE 1/4
Section 36-3-16 was assumed
to bear N 01°29'42" W.

LEGEND

- FOUND IRON ROD 3/4"
- FOUND COUNTY MONUMENT
- SET IRON ROD, 24" LONG, WEIGHING
1.5 LBS./LINEAL FT., 3/4" DIA.
- SOIL BORING- SGP (1-12)
- MONITORING WELL
- RECORDED AS DIMENSION

SCALE: 1" = 20 FEET

"I hereby certify that the above described property has
been surveyed by me or under my direction and that the
above map is a true representation thereof and shows the
size and location of the property, its exterior boundaries,
the location of all visible structures and dimensions of all
principal buildings thereon, boundary fences, apparent
easements, roadways and visible encroachments, if any."
"This survey is made for the use of the present owners of
the property, and also those who purchase, mortgage, or
guarantee the title thereto within one year from date
hereof."

Mark L. Miritz
MARK L. MIRITZ
WISCONSIN REGISTERED
LAND SURVEYOR S-2582

DATE: JULY 12, 2008 JOB NO. 08.701

NORTH

WISCONSIN

STREET

BLDG 0.3' EAST OF LINE

BLACKTOP

mw-7

BLDG 0.5' EAST OF LINE

CONC. WALK

mw-10

LOT 10

sgp-6
ele=1028.22'

mw-3

sgp-5
ele=1027.76'

18.1'

11.5'

8.1'

15.2'

8'

sgp-7
ele=1028.38'

mw-4

sgp-8
ele=1028.05'

sgp-9
ele=1027.54'

sgp-4
ele=1027.36'

mw-5

OVERHEAD UTILITY WIRES

mw-8

sgp-10
ele=1027.84'

46'

LOT 11

11,371 SQ. FT.

sgp-2
ele=1027.63'

pz-1

mw-2

sgp-1
ele=1027.33'

sgp-12
ele=1026.87'

BLACKTOP 2.9' WEST OF LINE

54'

UTILITY PED.

STORM SEWER GRATE

mw-9

50.2'

14.7'

80.2'

CONC.

CONC.

EAST FIRST AVE.

66' WIDE

mw-6

NORTH	EAST	TOP OF WELL CASING	WELL NO.	TOP OF WELL ELEV
250799.677	2391730.026	1027.641	mw-1	1027.754
250854.349	2391807.152	1026.851	mw-2	1027.135
250887.162	2391687.540	1028.542	mw-3	1028.794
250888.602	2391744.265	1027.950	mw-4	1028.308
250883.523	2391714.053	1028.219	mw-5	1028.771
250755.176	2391720.413	1027.104	mw-6	1027.505
250837.700	2391682.547	1028.227	mw-7	1028.523
250887.319	2391809.822	1026.649	mw-8	1027.108
250807.894	2391813.748	1026.491	mw-9	1026.885
250791.792	2391689.434	1028.327	mw-10	1028.624
250856.549	2391807.274	1027.038	pz-1	1027.201


EAST 1/4 CORNER
SEC. 36-3-16
N= 250,258.44
E= 2,392,254.54
ELEV= 1024.45

NE CORNER SEC. 36-3-16

2075.43'

N 01°29'42" W 2639.43'

564.00'

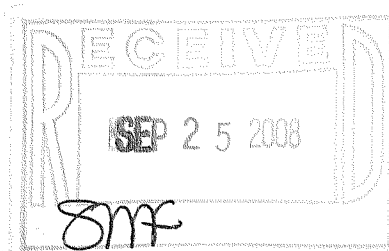

VD-45

004-2230