
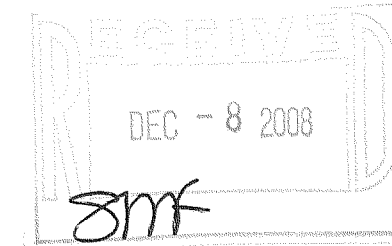


SOUTH DEVENDOR STREET

ABELL SURVEYING & MAPPING

1140 SEQUOIA STREET • DELAVAN, WISCONSIN 53115
262-728-6737

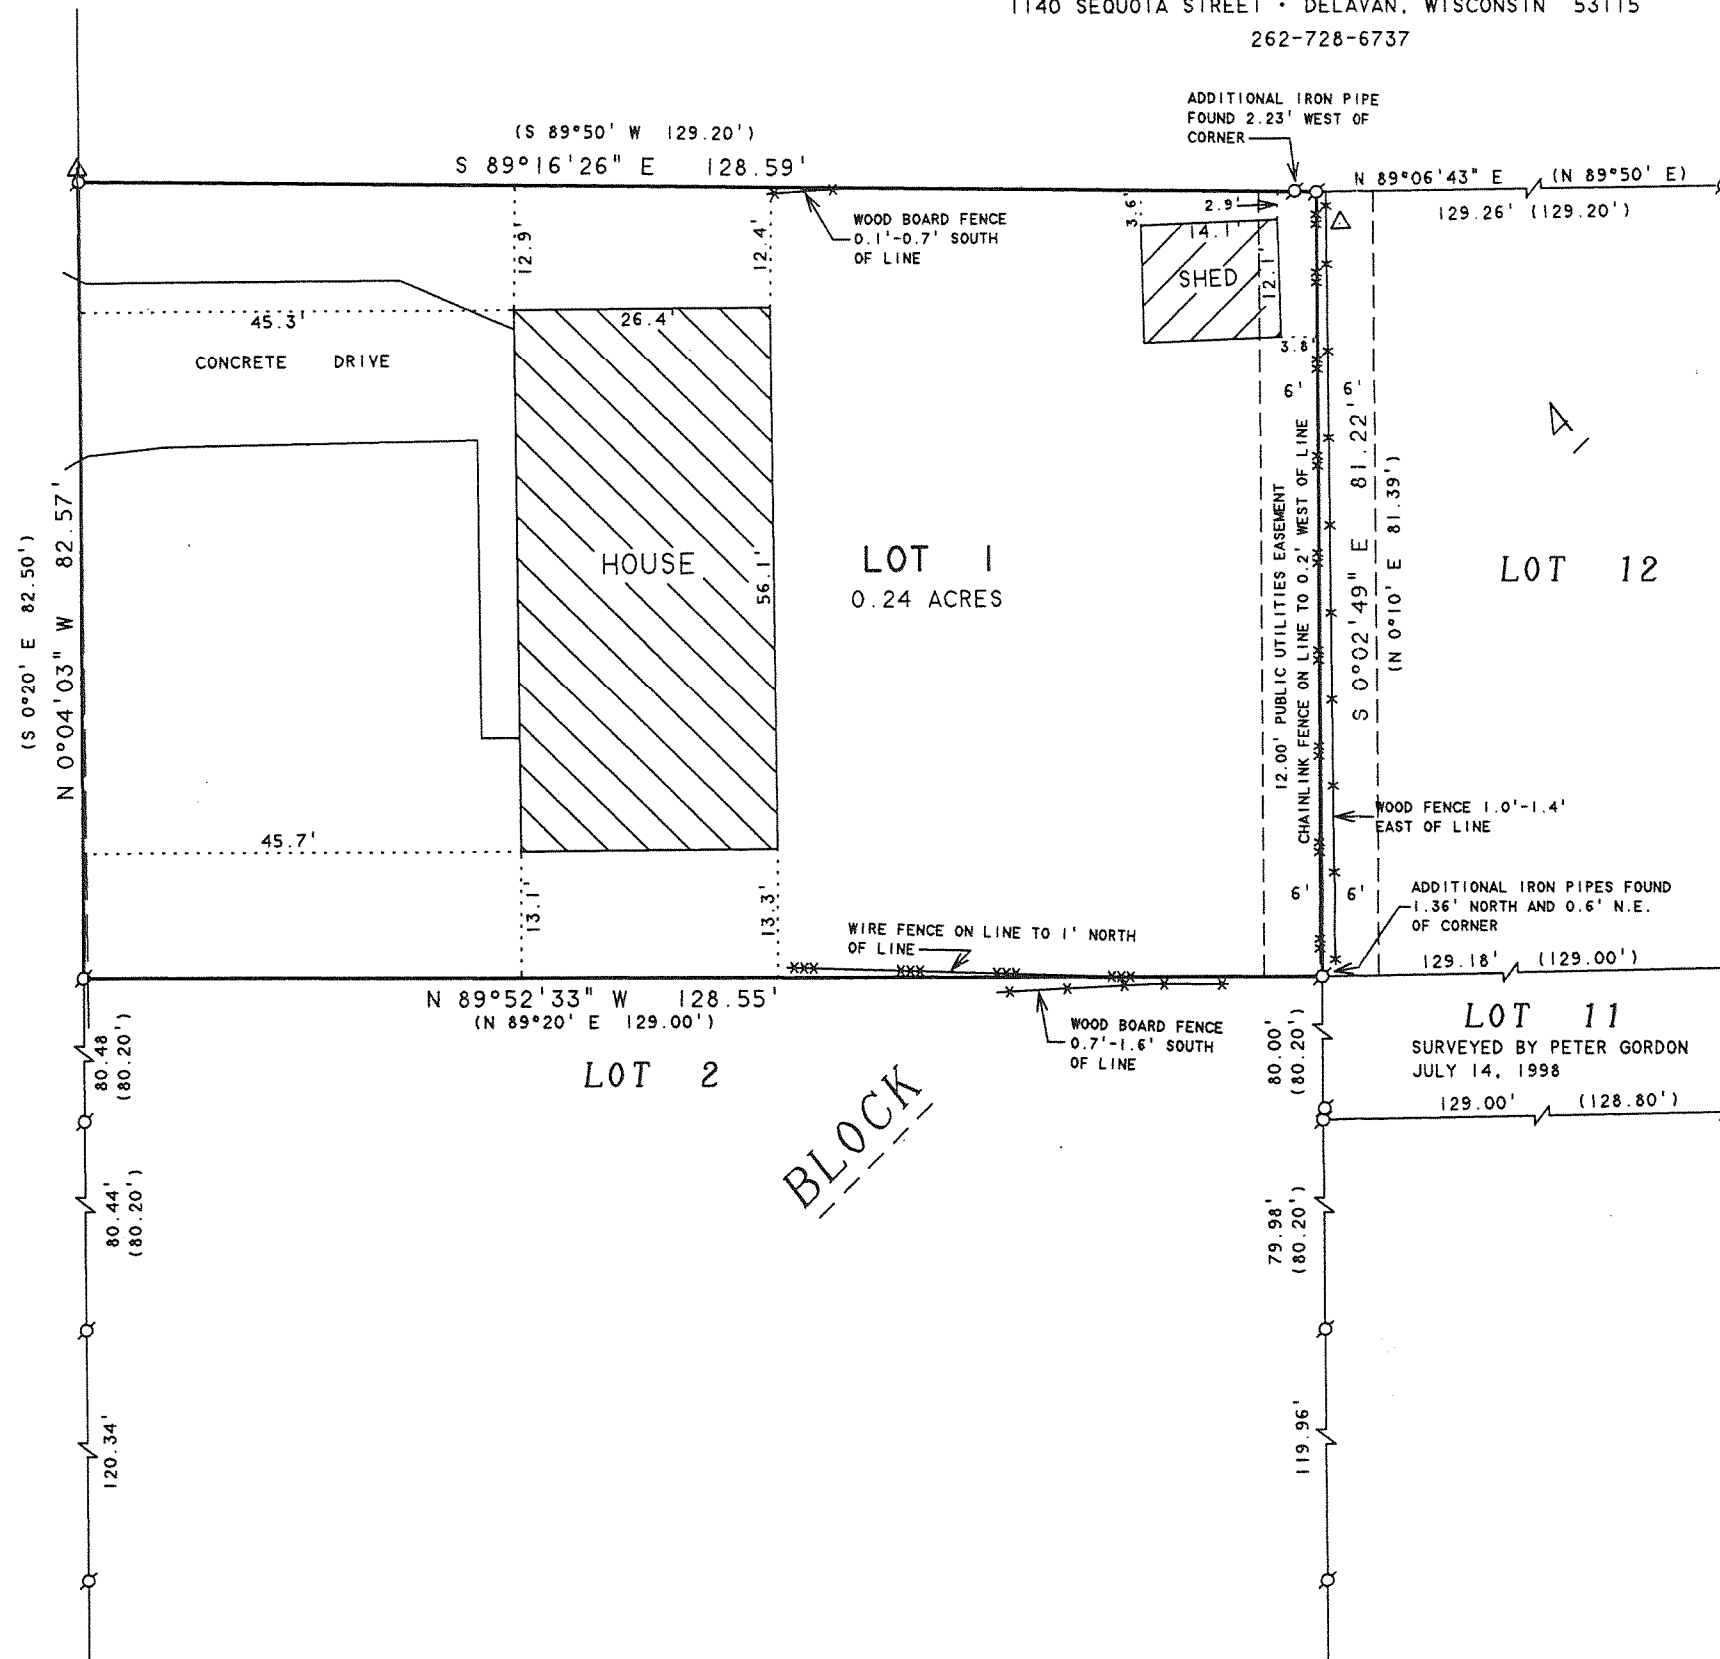

SCALE 1"=20'

LEGEND

- - IRON PIPE FOUND
- - IRON ROD FOUND
- △ - UTILITY POLE
- - OVERHEAD UTILITY LINES
- *—*— - WOOD FENCE
- **—**— - CHAINLINK FENCE
- () - RECORDED AS

PLAT OF SURVEY OF

LOT 1, BLOCK 4, JAMES JONES 2nd ADDITION,
LOCATED IN THE NORTHWEST 1/4 OF SECTION J,
T2N, R16E, CITY OF ELKHORN, WALWORTH COUNTY,
WISCONSIN.

ORDERED BY: JOHN SAARI
1102 N. THOMPSON DRIVE
MADISON, WI 53074

I HEREBY CERTIFY THAT I HAVE SURVEYED THE ABOVE DESCRIBED PROPERTY AND THAT THE ABOVE MAP IS A TRUE REPRESENTATION THEREOF AND SHOWS THE SIZE AND LOCATION OF THE PROPERTY, ITS EXTERIOR BOUNDARIES, THE LOCATION OF ALL VISIBLE STRUCTURES AND DIMENSIONS OF ALL PRINCIPAL BUILDINGS THEREON, BOUNDARY FENCES, APPARENT EASEMENTS, ROADWAYS AND VISIBLE ENCROACHMENTS, IF ANY, TO THE BEST OF MY KNOWLEDGE AND BELIEF.

THIS SURVEY IS MADE FOR THE USE OF THE PRESENT OWNERS OF THE PROPERTY, AND ALSO THOSE WHO PURCHASE, MORTGAGE, OR GUARANTEE THE TITLE THERETO WITHIN ONE (1) YEAR FROM DATE HEREON.

David F. Abell

DAVID F. ABELL
WISCONSIN REGISTERED LAND SURVEYOR, S-1596

September 3, 2008

DATE: September 3, 2008 JOB NUMBER - 08033
NOTE: THIS IS NOT A CERTIFIED COPY UNLESS SEALED.

Y042-50

004-2243