


Plat of Survey

of


Lot 8 of Block 48 of Rockwell's Second Addition to the Village (now City) of Elkhorn,

located in the Northeast 1/4 of Section 1, Town 2 North, Range
16 East, City of Elkhorn, Walworth County, Wisconsin.

Surveyed for: **Jill Richards**
216 South Washington Street
Elkhorn, Wisconsin. 53121

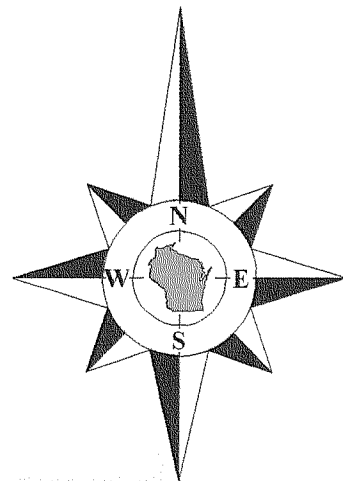

Bearings are referenced to the West line of
Washington Street, assumed to bear South.

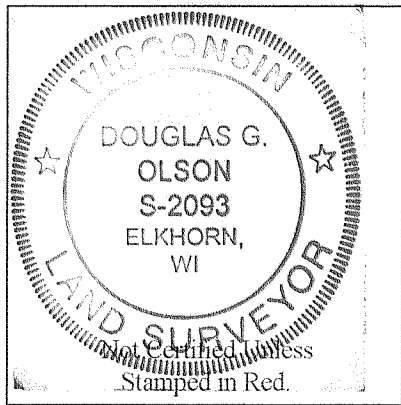

Notes:


- 1) This survey plat is not certified unless signed and sealed in red ink.
- 2) This survey is subject to Wisconsin lien laws. This Plat of Survey is the notice of intent to file lien. Lien waiver required.

Copyright 2008 by Jensen & Olson Land Surveying, LLC.


All rights reserved. No part of this survey plat may be reproduced or transmitted in any form by any means - graphic, electronic, or mechanical, including photocopying, tracing, or information storage and retrieval systems - without permission in writing from Douglas G. Olson, Jensen & Olson Land Surveying, LLC.

I, Douglas G. Olson, Wisconsin Registered Land Surveyor, do hereby certify that this survey was performed by me, or under my direction in full compliance with the owner's/agent's instructions and Chapter A-E 7 of the Wisconsin Administrative Code "Minimum Standards for Property Surveys"; and that this map is an accurate representation thereof to the best of my knowledge and belief.

Douglas G. Olson
Wisconsin Registered Land Surveyor - 2093

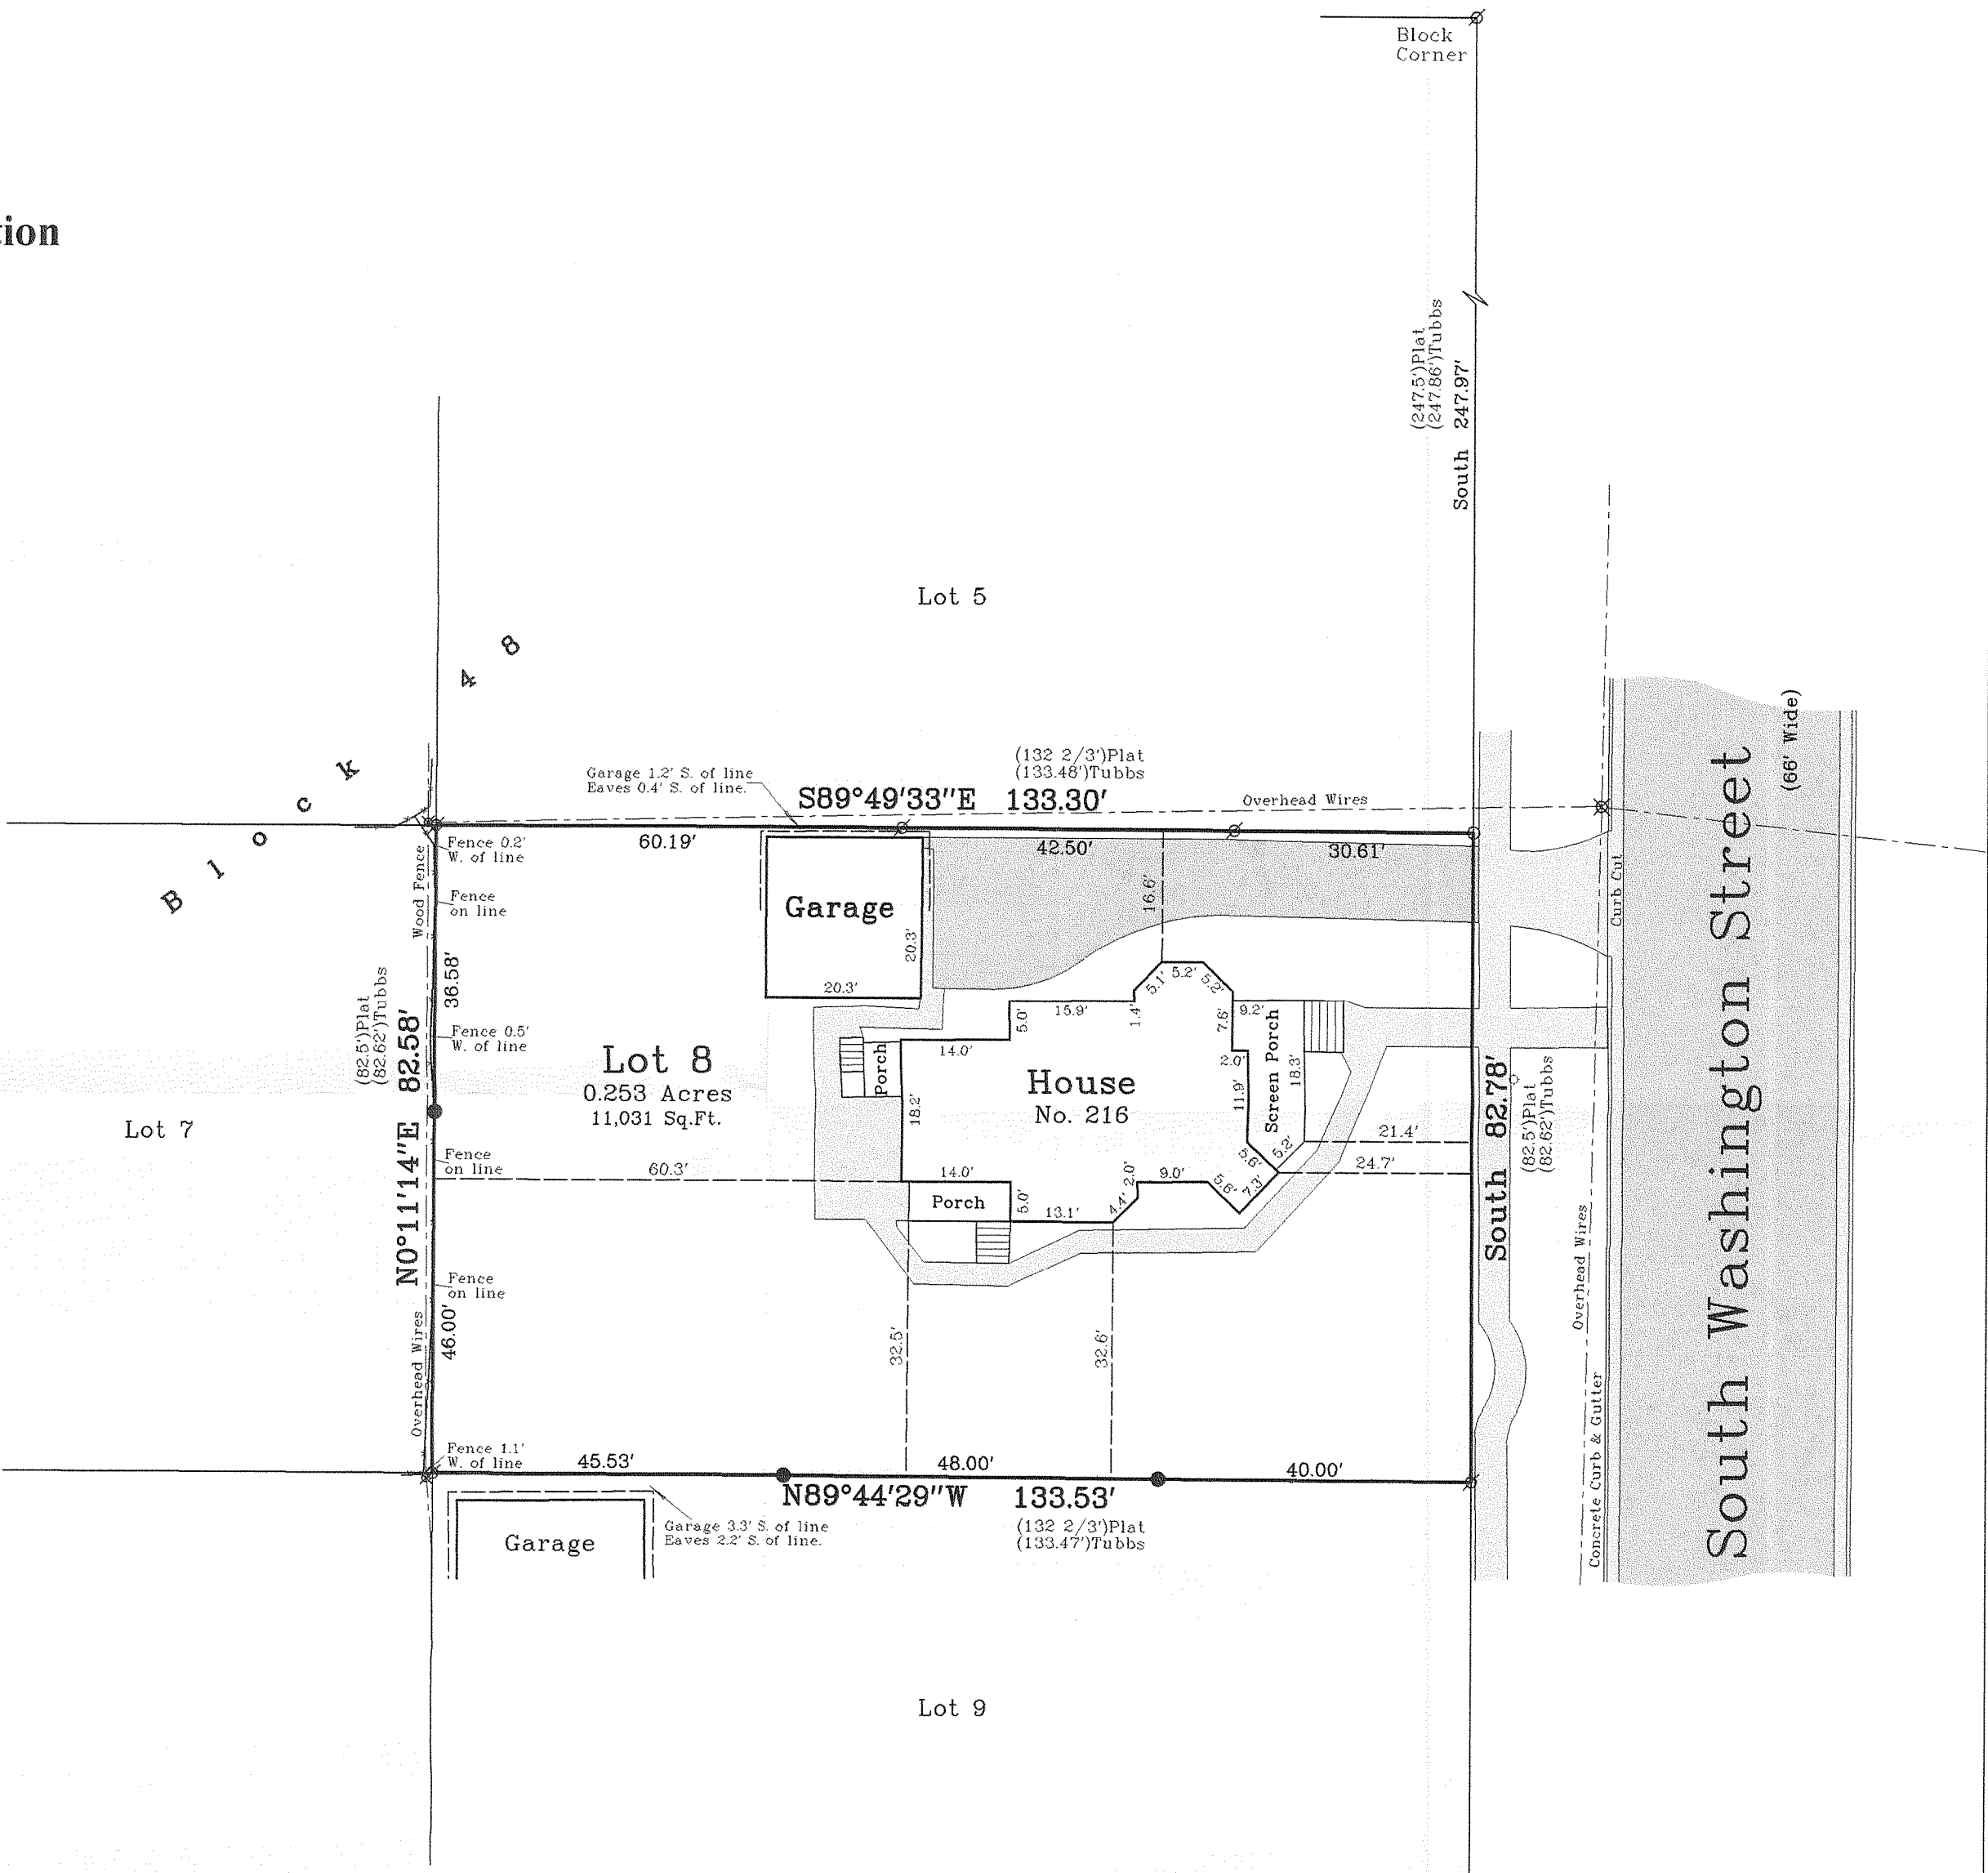


Note: (88')Plat - Indicates dimension as shown on the Original Plat of the City of Elkhorn.
(88.7')Tubbs - Indicates dimension as shown on Mr. Tubbs' survey of the City of Elkhorn

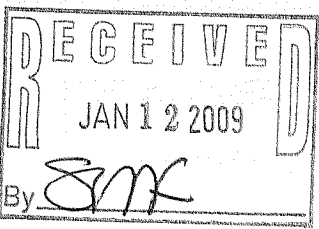

Survey Date: September 12, 2008.

Revisions:

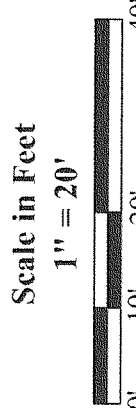

Jensen & Olson Land Surveying, LLC

45 South Wisconsin Street * P.O. Box 322 * Elkhorn, Wisconsin. 53121
Telephone: (262) 723-3434 * Facsimile: (262) 723-8044
Email: jensen.olson@elknet.net

Legend
Found Iron Pipe 1" dia.
Found Iron Rod 3/4" dia.
Recorded Information
Water Valve
Asphalt Surface
Concrete Surface

Sheet 1 of 1 Sheets
Drawing Name: 2008.099 - 2008.099
Job Reference Number
2008.099

2008.099

YRW2-13

007-2247