



61-52

4-225B

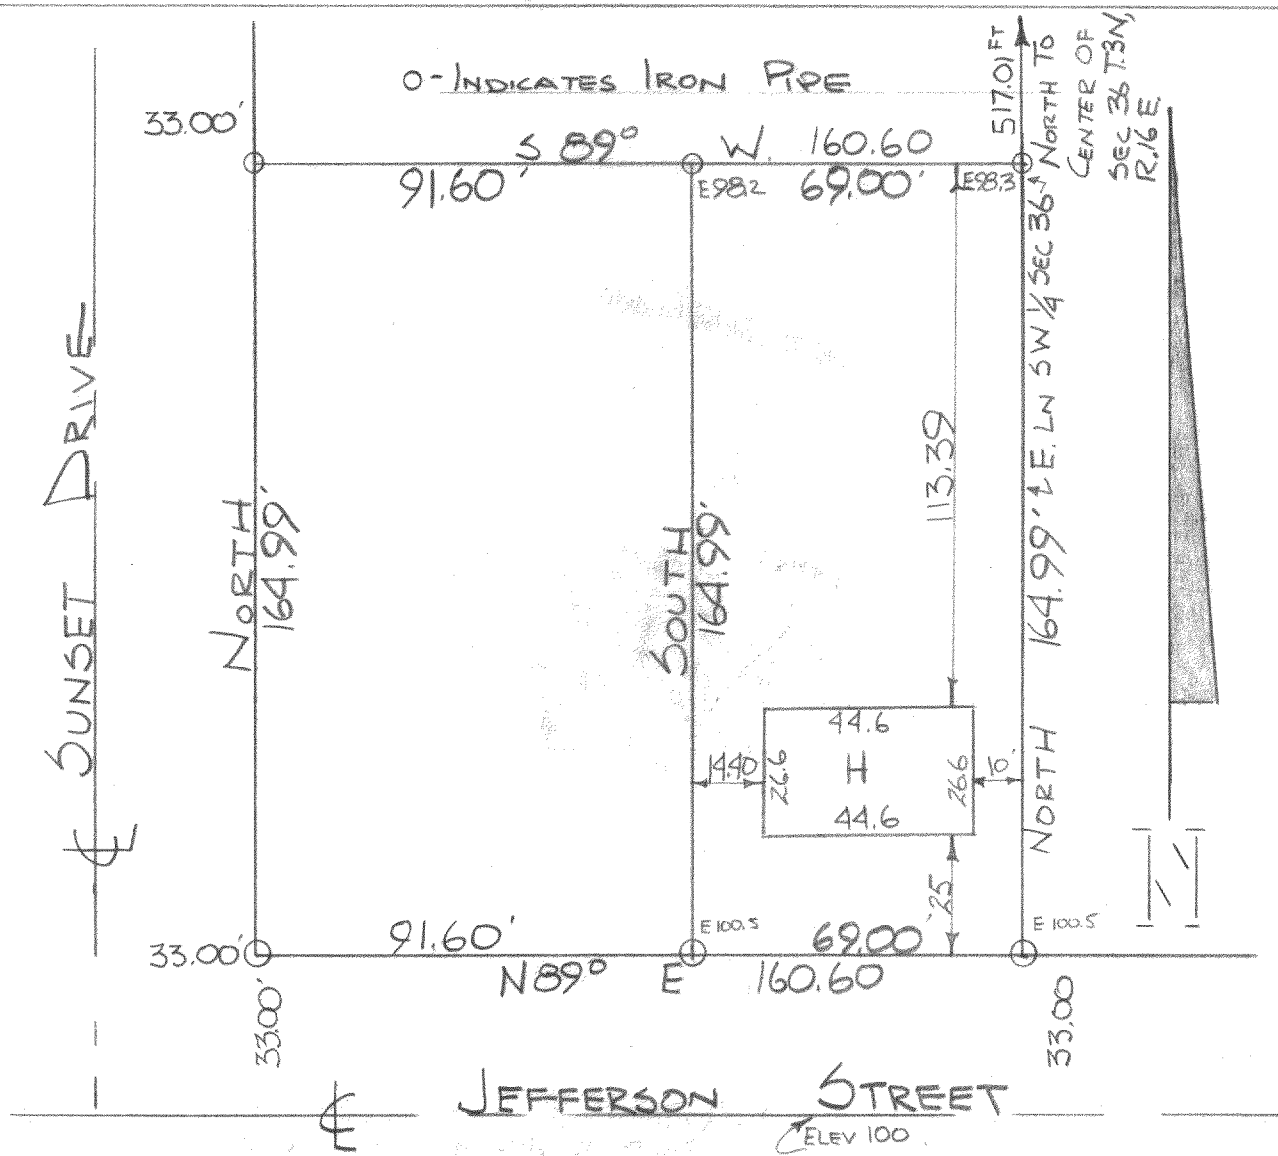

DESCRIPTION: Commencing at the point of intersection of the North line of Jefferson Street and the East line of the SW 1/4 of Section 36, T3N, R16E, in the City of Elkhorn, Walworth County Wisconsin; thence North along the East line of said 1/4 Section 164.99 feet to an iron stake, thence West 69.00 feet to an iron stake, thence South 164.99 feet to an iron stake, thence East 69.00 feet to the place of beginning.

CERTIFICATE: I, James F. Biagi, surveyor, do hereby certify that I have surveyed the property hereon described on this 28th day of April, 1961.

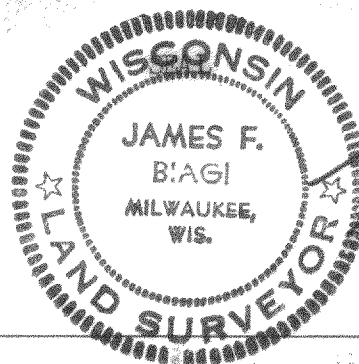

*James F. Biagi*

James F. Biagi RLS 272

U-NW-60 + U-NW-61

4-225B