


Plat of Survey

of

Lot 84 of Hearthstone of Elkhorn Addition No. 1.,

located in the Northeast 1/4 of Section 25, Town 3 North, Range 16 East,
City of Elkhorn, Walworth County, Wisconsin.

Surveyed for: **Rolling Oaks LLC**
N1958 County Road O
Delavan, Wisconsin. 53115

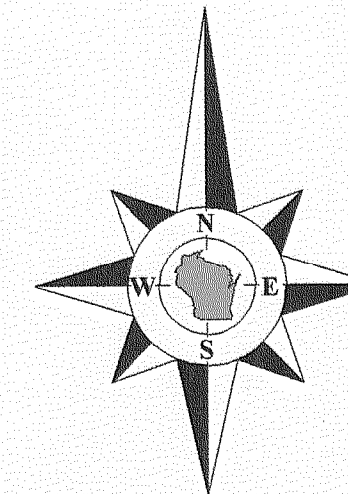


Bearings referenced to the plat of
Hearthstone of Elkhorn Addition No. 1.

Hearthstone Street
(66' Wide)

Lot 84
Tax Parcel
YHE1 00028
0.242 Acre
10,524 Sq.Ft.


House
No. 218

Davenport Street
(66' Wide)

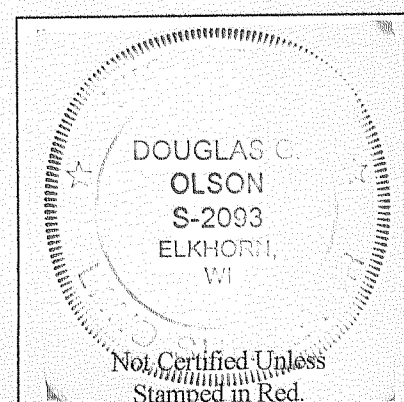

Notes:

- 1) This survey plat is not certified unless signed and sealed in red ink.
- 2) This survey is subject to Wisconsin lien laws. This Plat of Survey is the notice of intent to file lien. Lien waiver required.

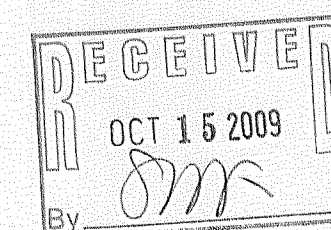

Copyright 2009 by Jensen & Olson Land Surveying, LLC.


All rights reserved. No part of this survey plat may be reproduced or transmitted in any form by any means - graphic, electronic, or mechanical, including photocopying, tracing, or information storage and retrieval systems - without permission in writing from Douglas G. Olson, Jensen & Olson Land Surveying, LLC.

I hereby certify that I have surveyed the above described property and the map hereon is correct to the best of my professional knowledge and belief and shows the size and location of the property, its exterior boundaries, the location and dimensions of all visible structures thereon, boundary fences, apparent easements and roadways and visible encroachments, if any.

This survey is made for the exclusive use of the present owners of the property, and also those who purchase, mortgage or guarantee title thereto, within one year from the date hereof.

Douglas G. Olson
Wisconsin Registered Land Surveyor - 2093

Survey Date: Sept. 30, 2009.
Revisions:

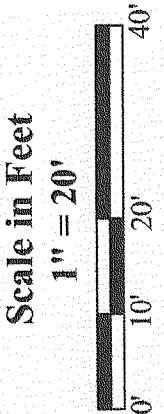

Jensen & Olson Land Surveying, LLC
45 South Wisconsin Street * P.O. Box 322 * Elkhorn, Wisconsin. 53121
Telephone: (262) 723-3434 * Facsimile: (262) 723-8044
Email: jensen.olson@elknet.net

Legend
Found Iron Pipe dia.
Set Iron Pipe, 1"
Recorded Information
Utility Pedestal
Manhole
Water Valve
Asphalt Surface
Concrete Surface

Sheet 1 of 1 Sheets
Drawing Name: Dmr (6-2009085-2009085) Plat.srf
Job Reference Number
2009.085

2009.085

YHE1 -28

004-2265