


FARRIS, HANSEN & ASSOCIATES, INC.

ENGINEERING — ARCHITECTURE — SURVEYING
7 RIDGWAY COURT — P.O. BOX 437 — ELKHORN, WISCONSIN 53121
PHONE: (262) 723-2098 FAX: (262) 723-5886

— WORK ORDERED BY —
FARLEY NESHEK REALTY CORPORATION
PO BOX 75
ELKHORN, WI 53121

PLAT OF SURVEY

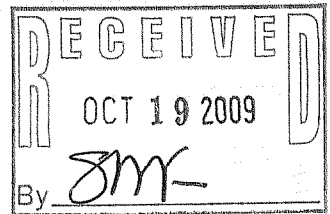

WISCONSIN STATE PLANE COORDINATE SYSTEM
SOUTH ZONE
N. LINE OF THE NW 1/4 OF SEC. 31-3-17
BEARS S 88°45'48" W

LEGAL DESCRIPTION
Lot 37 Fair Meadow Subdivision Addition No. 1, located in part of the Northeast 1/4 and the Southeast 1/4 of the Northwest 1/4 of Section 31, Town 3 North, Range 17 East, City of Elkhorn, Walworth County, Wisconsin.


Tax Key No. YFM1 00037

MAP SCALE IN FEET ORIGINAL 1" = 20'

NOTE: EASEMENT REC. IN VOL. 523 OF DEEDS, PAGE 334 DOES NOT AFFECT THE LANDS SURVEYED (LIES WEST OF THE SUBDIVISION).

DOC. 719811 VACATES THAT PART OF HANNAH STREET PLATTED ON RENDON SUBDIVISION ADDITION NO. 1 WITHIN THE BOUNDARY OF FAIR MEADOW SUBDIVISION ADDITION NO. 1.

EASEMENT REC. AS DOC. 728866 DOES NOT AFFECT THE SUBJECT LOT.

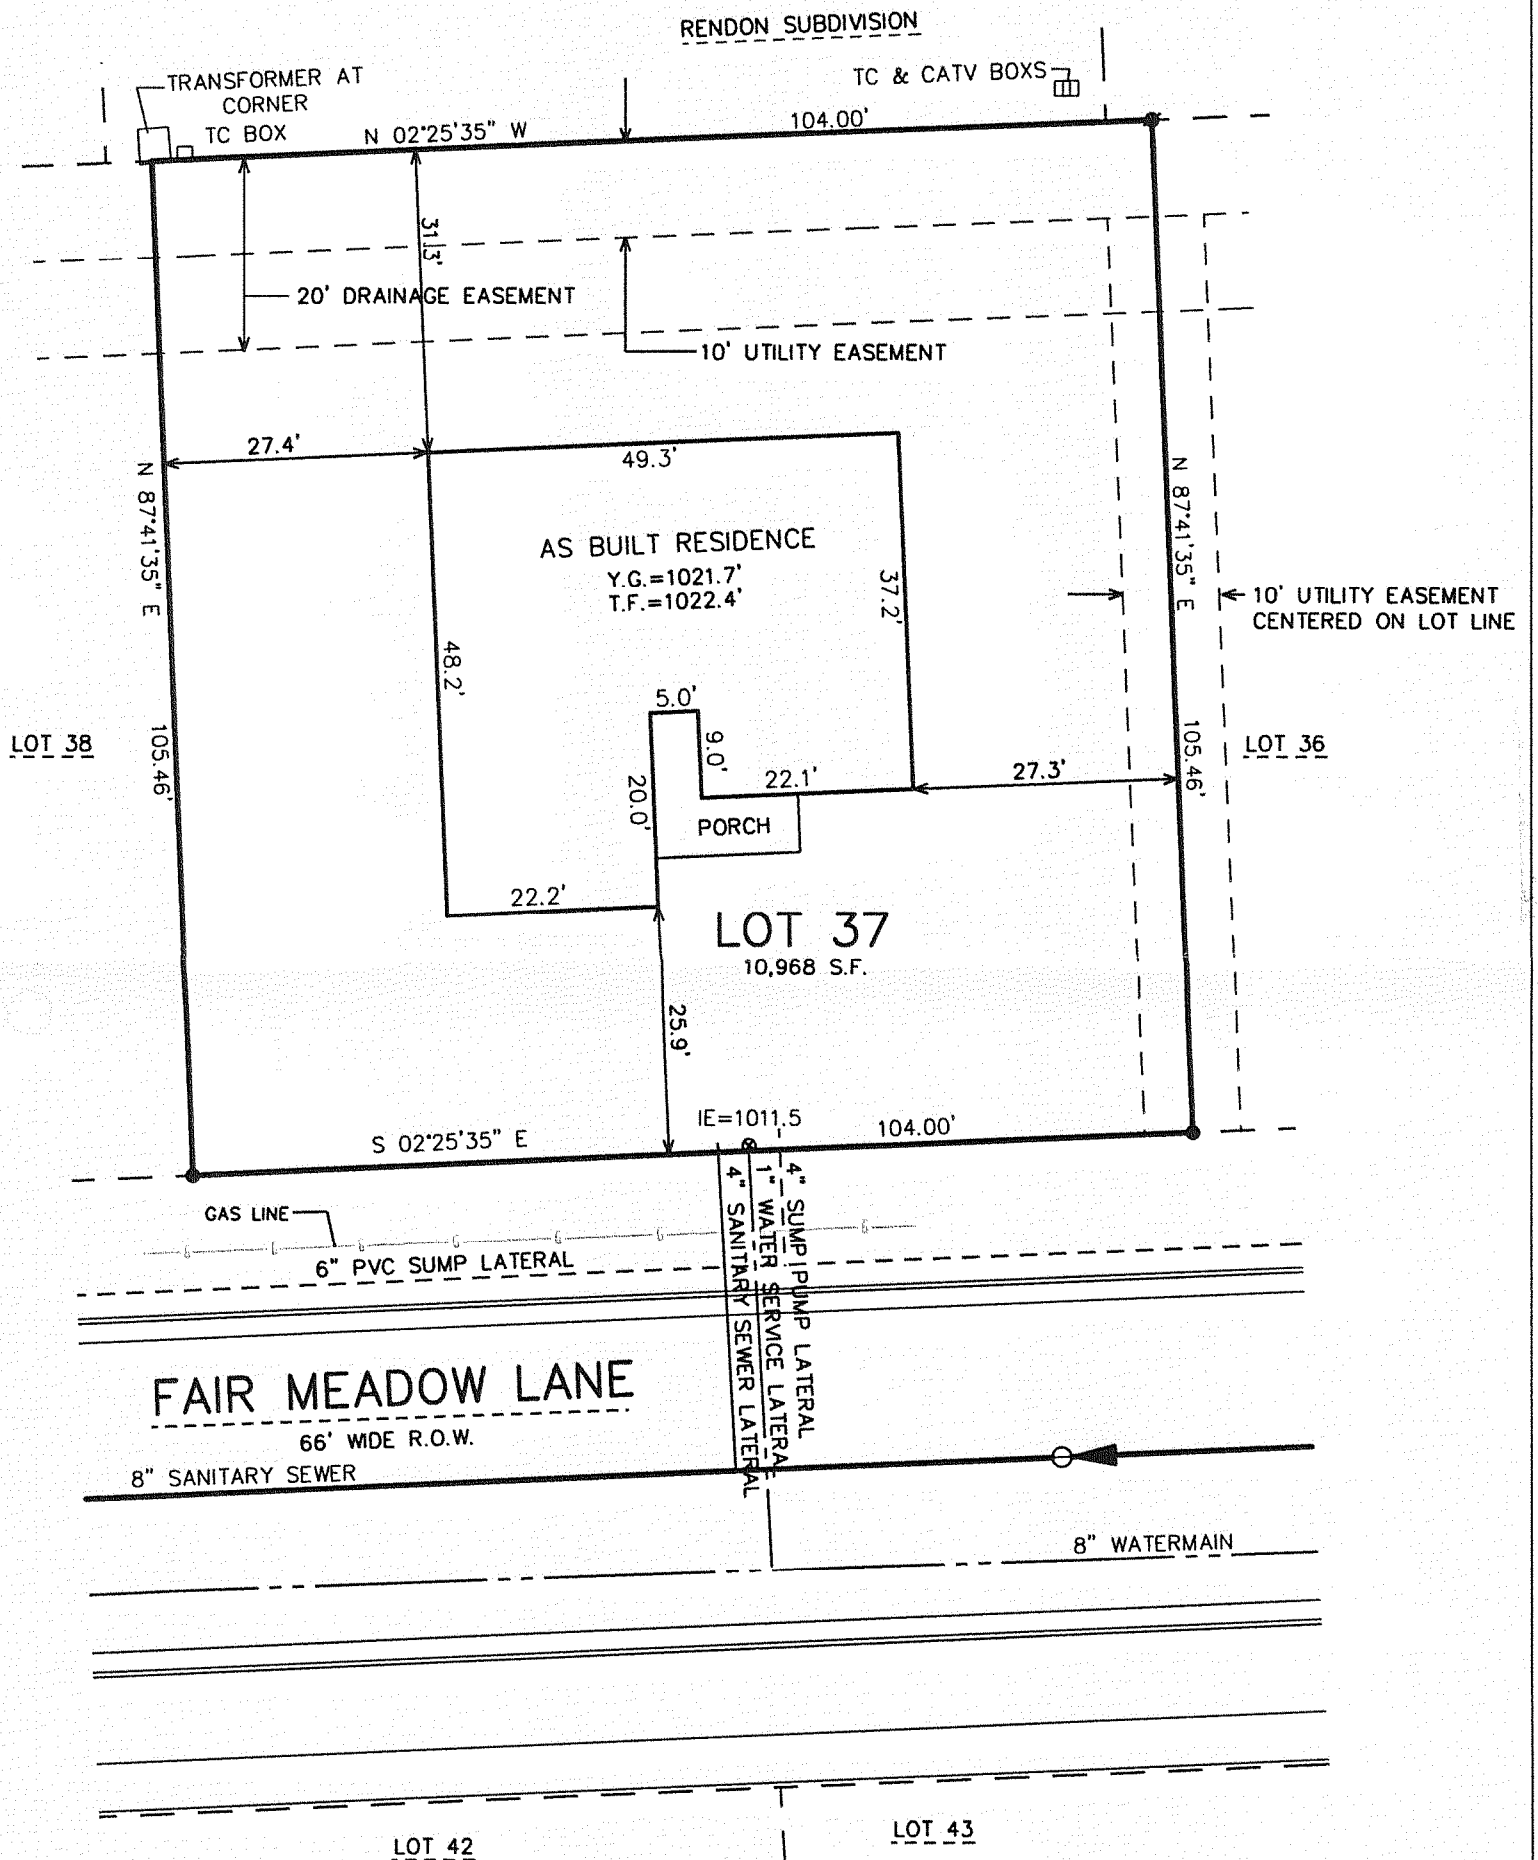

NOTE: COPIES OF THIS MAP TO WHICH THE FOLLOWING CERTIFICATE WILL APPLY SHOW SURVEYOR'S ORIGINAL SEAL AND SIGNATURE IN RED INK. COPIES BY ANY OTHER MEANS MAY HAVE ALTERATIONS WHICH DO NOT REPRESENT THE SURVEYOR'S WORK PRODUCT.

I HEREBY CERTIFY THAT THE ABOVE DESCRIBED PROPERTY HAS BEEN SURVEYED UNDER MY DIRECTION AND THAT THE ABOVE MAP IS A TRUE REPRESENTATION THEREOF AND SHOWS THE SIZE AND LOCATION OF THE PROPERTY, ITS EXTERIOR BOUNDARIES, THE LOCATION OF ALL VISIBLE STRUCTURES, AND DIMENSIONS OF ALL PRINCIPLE BUILDINGS THEREON, BOUNDARY FENCES, APPARENT EASEMENTS, ROADWAYS, AND VISIBLE ENCROACHMENTS, IF ANY. THIS SURVEY IS MADE FOR THE USE OF THE PRESENT OWNERS OF THE PROPERTY, AND ALSO THOSE WHO PURCHASE, MORTGAGE, OR GUARANTEE THE TITLE THERETO WITHIN ONE YEAR FROM THE DATE HEREOF.

DATED: SEPTEMBER 24, 2009

Peter S. Gordon
PETER S. GORDON R.L.S. 2101



PROJECT: 6104.37
DATE: 07/01/2008
SHEET 1 OF 1